
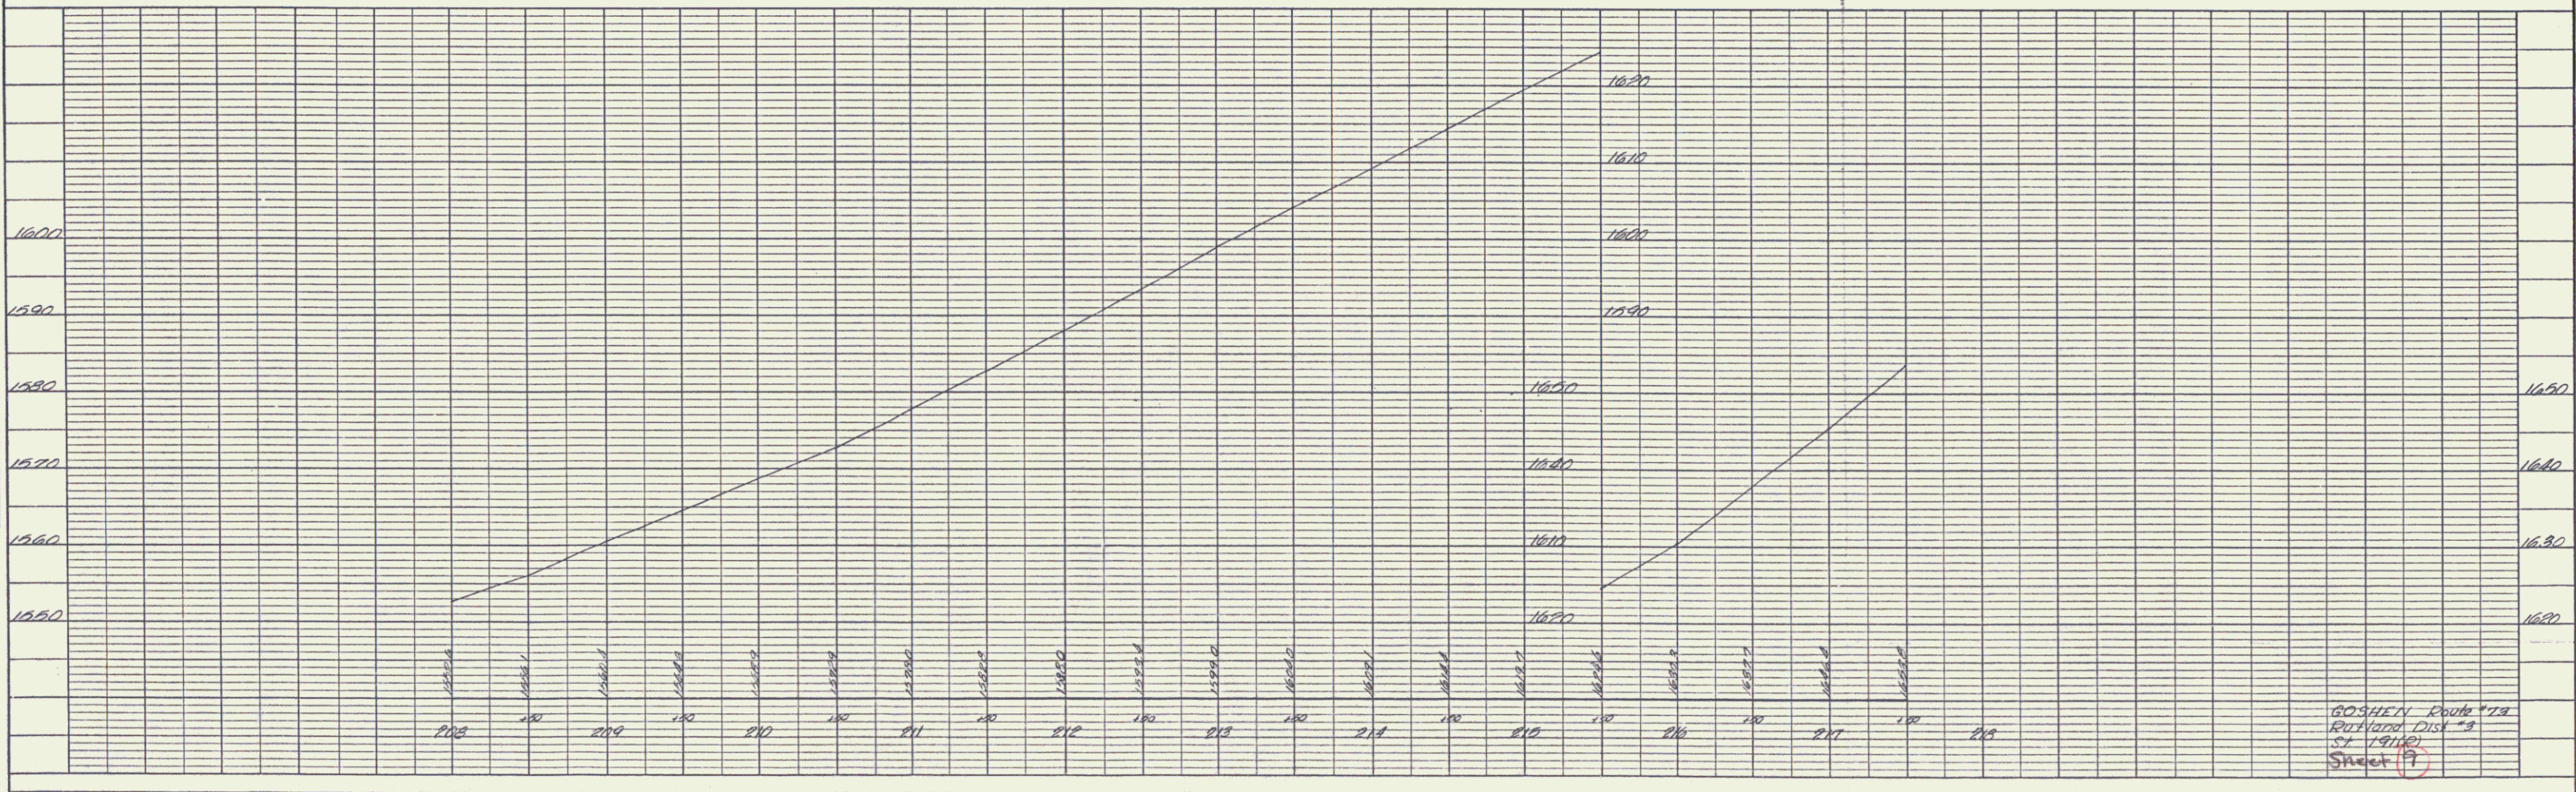


PLAN	
DESIGNED BY	DATE
PLANNED BY	BY
NOTED BY	CHECKED BY
DATE	DATE
NOTED BY	
DATE	
STRUCTURE NOT NOTED BY	
DATE	

PROFILE	
DESIGNED BY	DATE
PLANNED BY	BY
NOTED BY	CHECKED BY
DATE	DATE
NOTED BY	
DATE	
STRUCTURE NOT NOTED BY	
DATE	

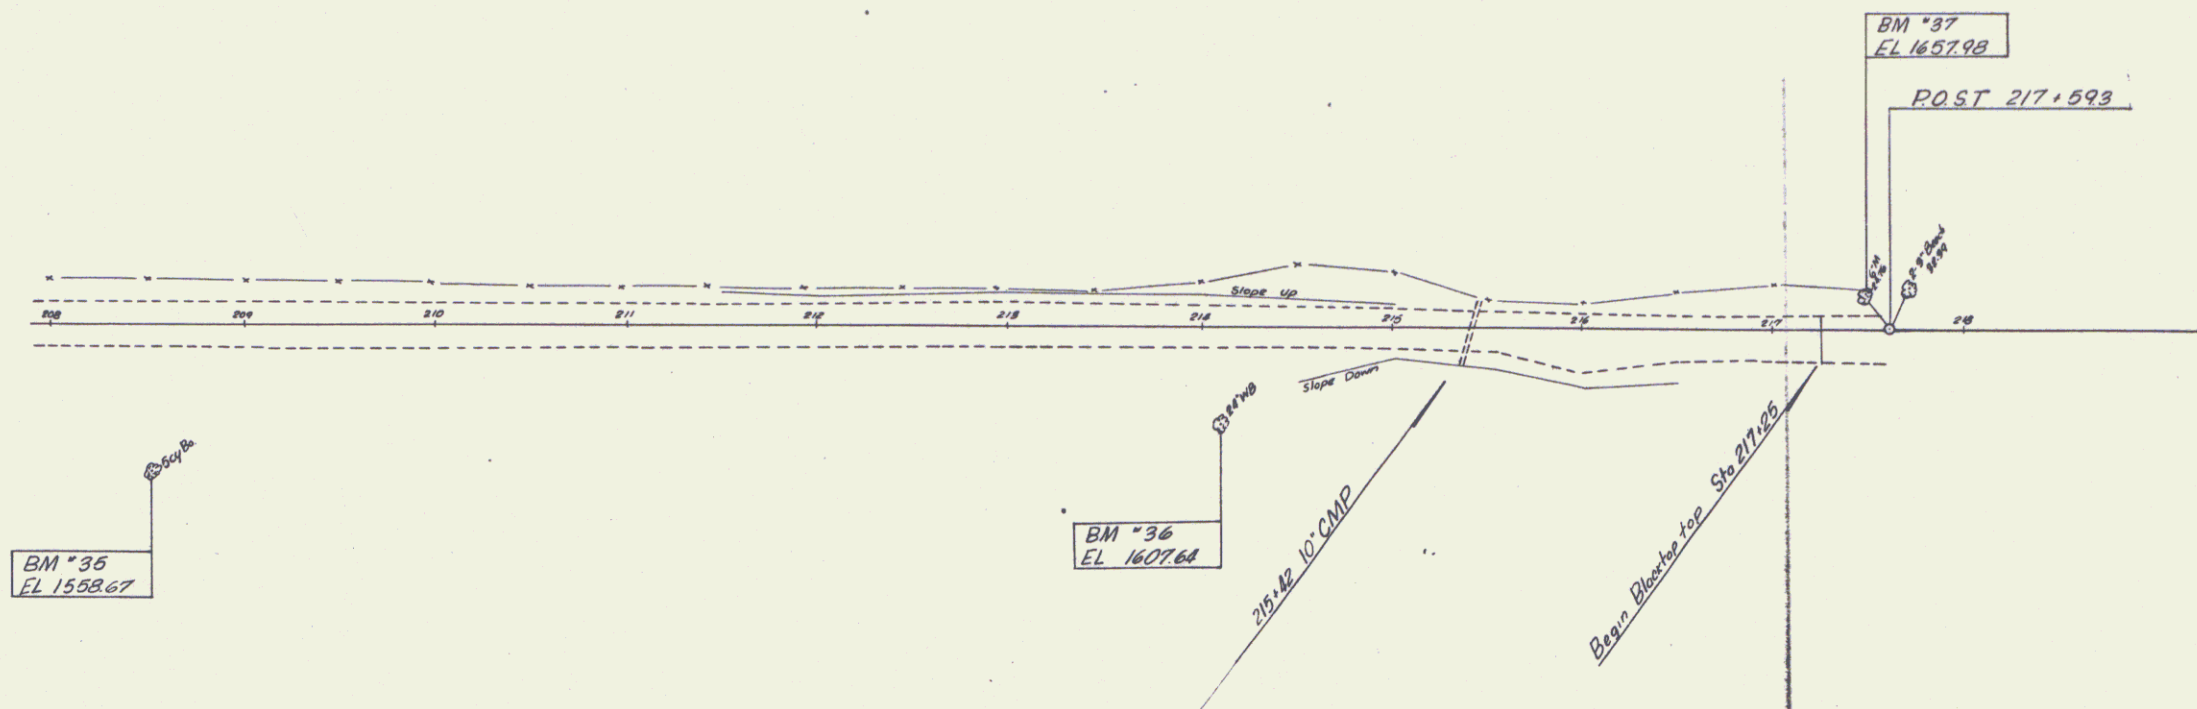

GOSHEN Route 129
 Putnam Dist. N.Y.
 Sta. 1598.67
 Sheet 17

PLATE 1 - PLAN - PROFILE O. R. & R. E. STANDARD
 KEUFFEL & ESSER CO., NEW YORK
 K & E CO. NO. 348-1