

INDEX OF SHEETS	
SHEET NO. 1	TITLE SHEET
2	TYPICAL CROSS-SECTION OF IMPROVEMENT (1 1/2" RETURNING CONCRETE PAVEMENT MODIFIED SPECIFIC COURSE MIX)
3	QUANTITY SHEET
4-4b	ITEM DETAIL AND DRAINAGE SHEETS
5-9	EARTHWORKS
10	B-1 (BANKING TABLES)
11	B-5 (TYPICAL SLOPE GRADING)
12	B-6 (MUCK EXCAVATION)
13	C-1 (TREATED TIMBER CURB)
14	D-2 (HEADWALLS AND UNDERDRAIN)
15	D-4 (SPECIAL ELBOWS)
16	D-8 (REINFORCED CONCRETE DROP INLET)
17	D-16 (CAST IRON GRATE, TYPE B)
18	E-1 (BARRICADES, SIGNS AND LIGHTS)
19	E-2 (BARRICADES, SIGNS AND LIGHTS FOR BRIDGES)
20	E-9 (FEDERAL AID CONSTRUCTION IDENTIFICATION SIGNS)
21	G-2a (TWO CABLE GUARD RAIL)
22	G-2b (DEAD END ANCHORS)
22a	G-3 (THREE CABLE GUARD RAIL)
23	G-4 (MARKER POSTS AND GUIDE POSTS)
24	J-1 (PROJECT MARKERS AND BOUNDARY MARKERS)
24a	SB-20-60
24b	SB-21-56
25-36	PLAN AND PROFILE S
37-41	DETAILS OF BRIDGE WIDENING
42-68	CROSS SECTIONS
69-70	CHANNEL SECTIONS
71-73	BANKING TRANSITION DIAGRAMS

**STATE OF VERMONT
DEPARTMENT OF HIGHWAYS
PROPOSED IMPROVEMENT**

**TOWNS OF ROCHESTER & CHITTENDEN
COUNTIES OF WINDSOR & RUTLAND
VERMONT ROUTE #73**

BRANDON ROCHESTER ROAD

BEGINNING AT A POINT 2.44 MILES EASTERLY OF THE GOSHEN, ROCHESTER TOWN LINE AND EXTENDING EASTERLY 2.617 MILES TO THE HAMLET OF ROBINSON.

LENGTH OF ROADWAY 13,782.2+2.610 MILES
LENGTH OF BRIDGE 38.9+0.007 MILES
LENGTH OF PROJECT 13,821.1+2.617 MILES

1960 ADT	= 120-140
1980 ADT	= 170-200
1980 DHV	= 45
D	= 67%
T	= 9%
V	= 40 MPH


PROJECT NAME & NUMBER TYPE PAVT. AREA
ROCHESTER S-FLH 0162(3) BIT. 33,785 S Y
CHITTENDEN S-FLH 0162(3) CONC.

RECORD PLANS MATERIALS
SUBBASE OF CRUSHED GRAVEL COARSE GRADED-KING PIT-ROCHESTER, VT.
SUBBASE OF SAND - J.P. CARRARA & SONS, INC. - RUTLAND, VT.
CUTBACK ASPHALT - MOBIL OIL CO. - PROVIDENCE, R. I.
CONCRETE CLASS B - AMERSON READY MIX - WATERBURY, VT.
REINFORCING STEEL - JOHN T. RYERSON & SON, INC. - BOSTON, MASS.
REINFORCED CONCRETE PIPE - MARTIN MARIETTA CO. - WINDSOR, VT.
ASPH. CTD. CORR. GALV. METAL PIPE - NEW ENGLAND METAL CULVERT CO. - FLORENCE, VT.
ELEVATION - WHITE RIVER JCT., VT.
PREC. R.C. CURB D.I. W/C GRATE & FRAME, GUARD RAIL, TREATED TIMBER CURB & WOOD GUIDE POSTS - S.T. GRISWOLD & CO., INC. - WILLISTON, VT.
BITUMINOUS CONCRETE - W.M. PIKE & SON, INC. (PLANT) - FLORENCE, VT.

CONTRACTOR - LEO B. ROLAND LAPERLE
ST. JOHNSBURY, VT.
RESIDENT ENGINEER - C. J. CROSSETT.
INSPECTOR - M. ROGERS & F. THORNE.
RECORD PLANS - C. J. CROSSETT.


CONTRACT:
DATED - APRIL 24, 1963.
STARTED - APRIL 29, 1963.
COMPLETED - AUG. 20, 1964.
ACCEPTED - AUG. 20, 1964.

BENCH MARK DATA FROM U.S.G.S.
STA. 405+00.0
PROJECT S-FLH 0162(3) BEGIN PROJECT EXTENSION ENDS
STA. 405+00.0
PROJECT S-FLH 0162(3) END PROJECT EXTENSION ENDS

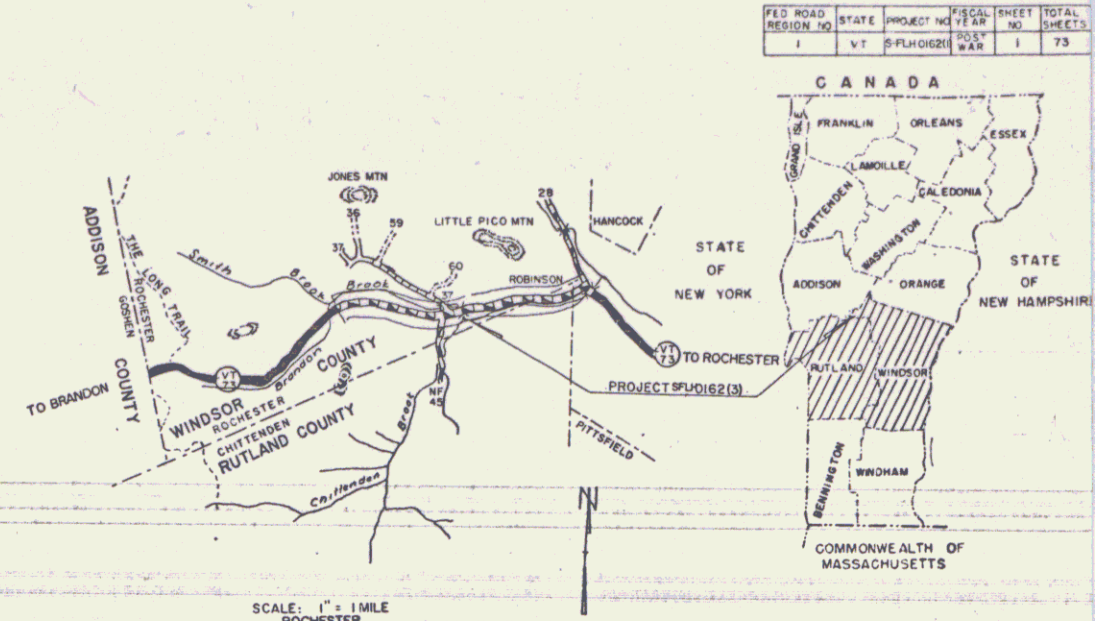

*Project: S-FLH 0162(3)
Plan: 00R421
Date: 10/30/62*

**RIGHT-OF-WAY DIVISION
TOWN FILE**
PERPETUAL
Town of VT 73
MP 4.920
(To Be Returned To R.O.W. Division)

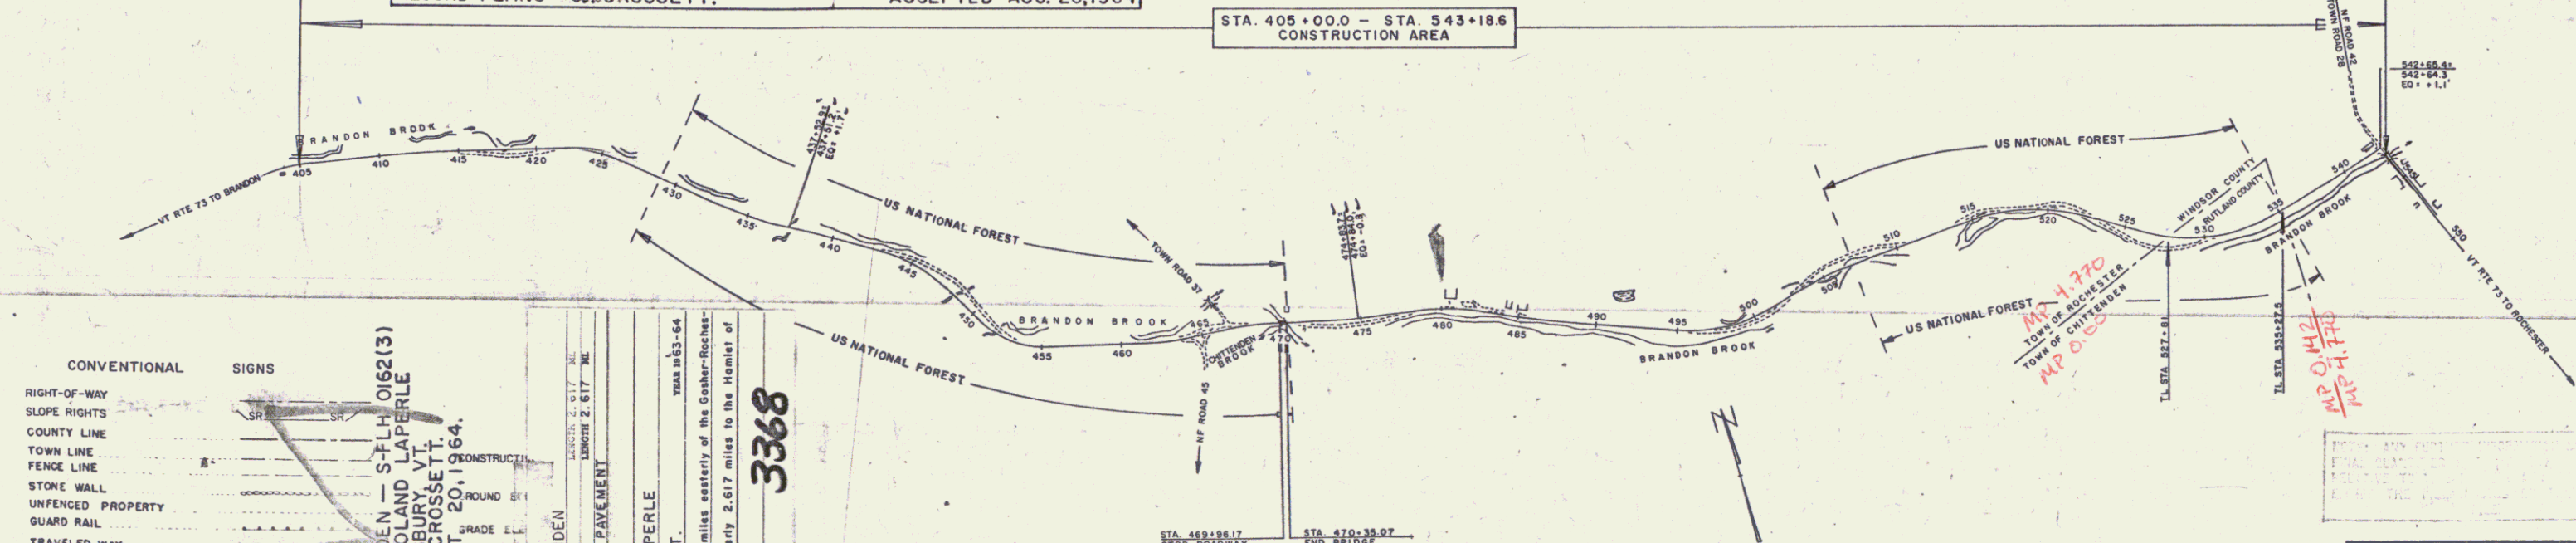

CONVENTIONAL SIGNS

- RIGHT-OF-WAY
- SLOPE RIGHTS
- COUNTY LINE
- TOWN LINE
- FENCE LINE
- STONE WALL
- UNFENCED PROPERTY
- GUARD RAIL
- TRAVELED WAY
- RAILROAD
- RETAINING WALL
- CENTER LINE
- SURVEY LINE
- CULVERT
- DROP INLET
- TROLLEY POLE
- POWER POLE
- TELEPHONE POLE
- TREES
- HEDGE

ROCHESTER-CHITTENDEN - S-FLH 0162(3)
CONTRACTOR LEO B. ROLAND LAPERLE
RECORD PLANS - C. J. CROSSETT
CONST. COMP. - AUGUST 20, 1964.

PROJECT S-FLH 0162(3)
TOWN OF ROCHESTER
TOWN OF CHITTENDEN
TYPE BITUMINOUS CONCRETE PAVEMENT

CONTRACTOR LEO B. ROLAND LAPERLE
ST. JOHNSBURY, VT.

Location: Beginning at a point 2.44 miles easterly of the Goshen-Rochester Town Line and extending easterly 2.617 miles to the Hamlet of Robinson.

Box 198 3368

SCALES

1" = 500'
1" = 50'
1" = 10'
1" = 10'

THESE PLANS ARE SUBJECT TO SUCH REVISIONS AS MAY BE REQUIRED BY THE BUREAU OF PUBLIC ROADS OR THE COMMISSIONER OF HIGHWAYS.

CONSTRUCTION IS TO BE CARRIED ON IN ACCORDANCE WITH THE PLANS AND THE STANDARD SPECIFICATIONS FOR HIGHWAY AND BRIDGE CONSTRUCTION OF JANUARY 1956 SUBMITTED TO THE BUREAU OF PUBLIC ROADS AS APPROVED JULY 5, 1956, INCLUDING ALL SUBSEQUENT APPROVED REVISIONS AND SUCH REVISED SPECIFICATIONS AND SPECIAL PROVISIONS AS ARE SUBMITTED WITH THE PLANS.

DEPARTMENT OF COMMERCE
BUREAU OF PUBLIC ROADS

APPROVED _____
DIVISION ENGINEER DATE _____

PROJECT S-FLH NO. 0162(3)
SHEET 1 OF 73 SHEETS

APPROVED <i>C.A. Lewis</i> DATE <i>October 29/62</i>	APPROVED <i>R.K. Howe</i> DATE <i>9/20/62</i>	APPROVED <i>E. H. O'Rourke</i> DATE <i>10/19/62</i>	APPROVED <i>Sam Brown</i> DATE <i>10/29/62</i>	APPROVED <i>G.P. Sullivan</i> DATE <i>10/30/62</i>	APPROVED <i>G.M. Lane</i> DATE <i>10/30/62</i>	APPROVED <i>A.D. Julek</i> DATE <i>10/29/62</i>
---	--	--	---	---	---	--