
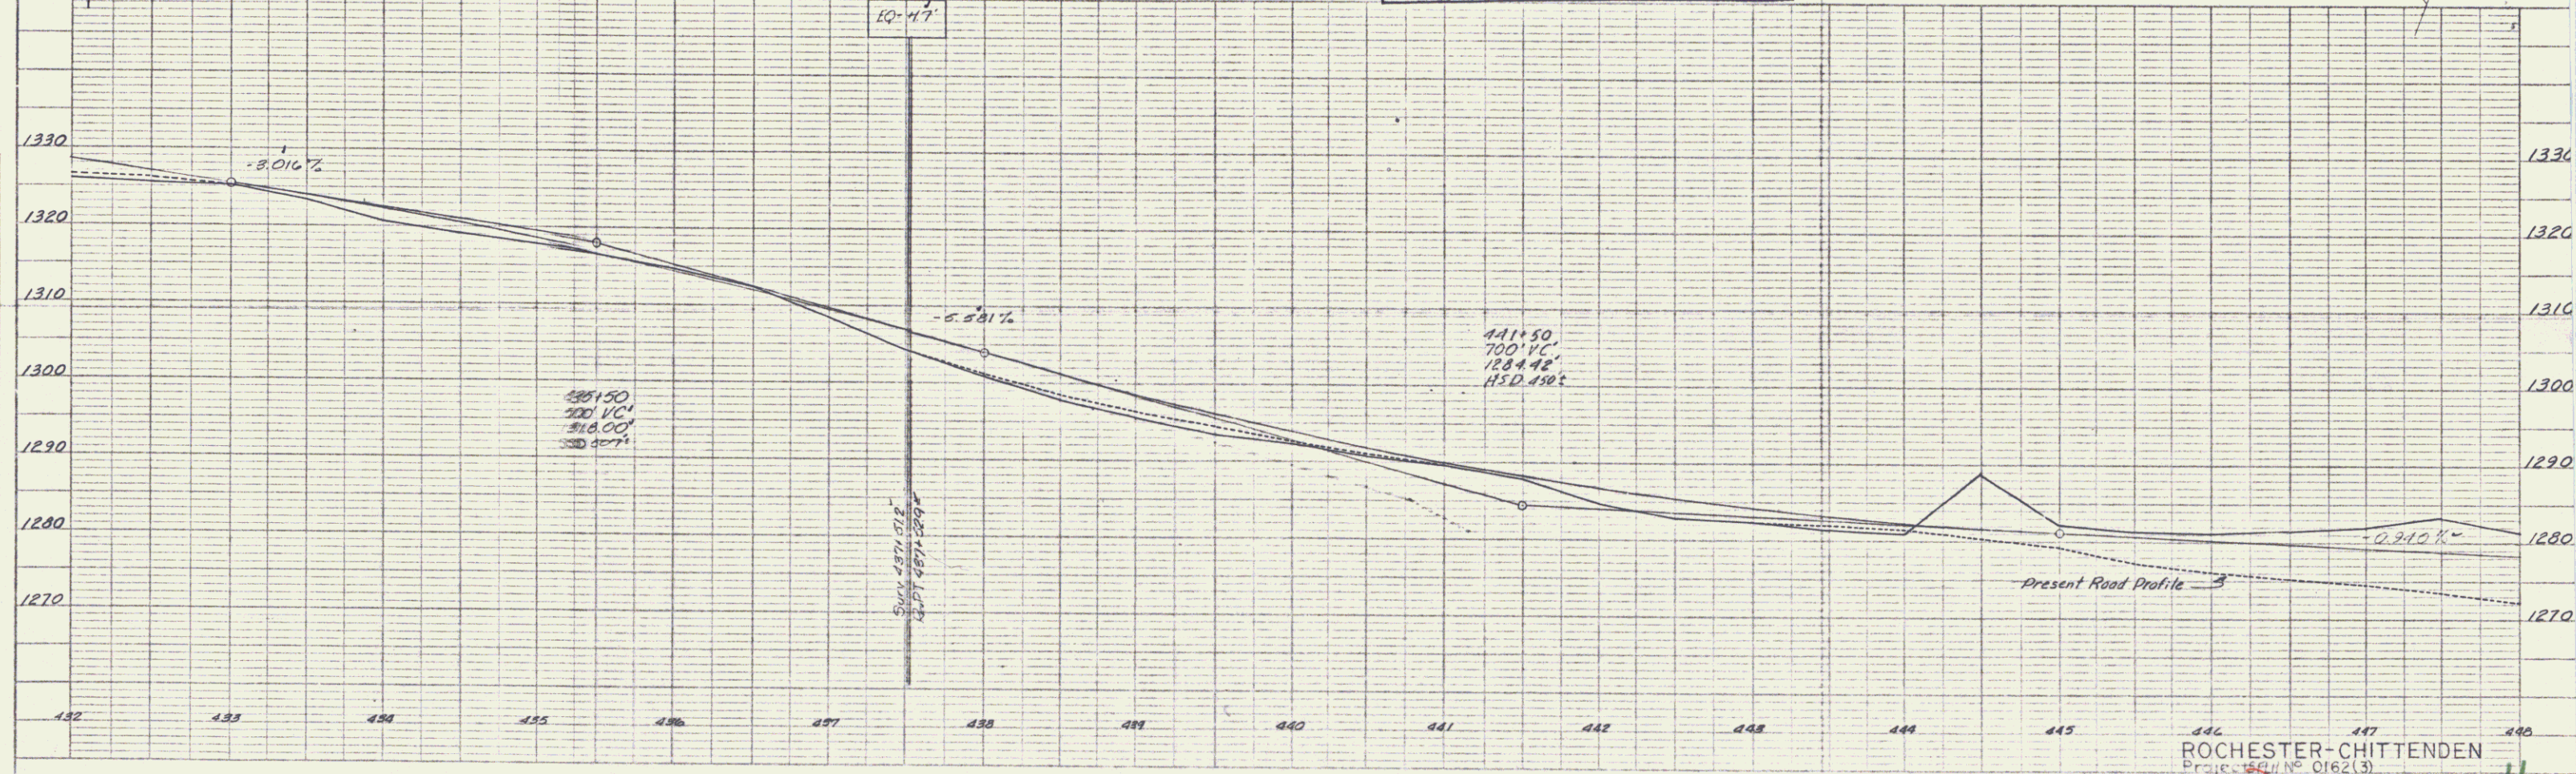


O CABLE GUARD RAIL
 UNCLASSIFIED CHANNEL ELEVATION
 STONE FILL FOR SLOPE PROTECTION
 DRILLING AND BLASTING
 OF SOLID ROCK SUB-GRADE

PARCEL	11C	STA. 429+02 - 445+00 ±
GRANTOR	GREEN MOUNTAIN NATIONAL FOREST	
TAKING RIGHTS	E. S. A. 1	REM.
TITLE TAKEN RECORDED	SPECIAL USE PERMIT	8/15/62
	BK. 1	PG. DT.
	NONAPPLICABLE	

PLAN	DATE	BY
REVISIONS		
NO.	DATE	DESCRIPTION
1	7/1/62	INITIAL

PROFILE	DATE	BY
REVISIONS		
NO.	DATE	DESCRIPTION
1	7/1/62	INITIAL

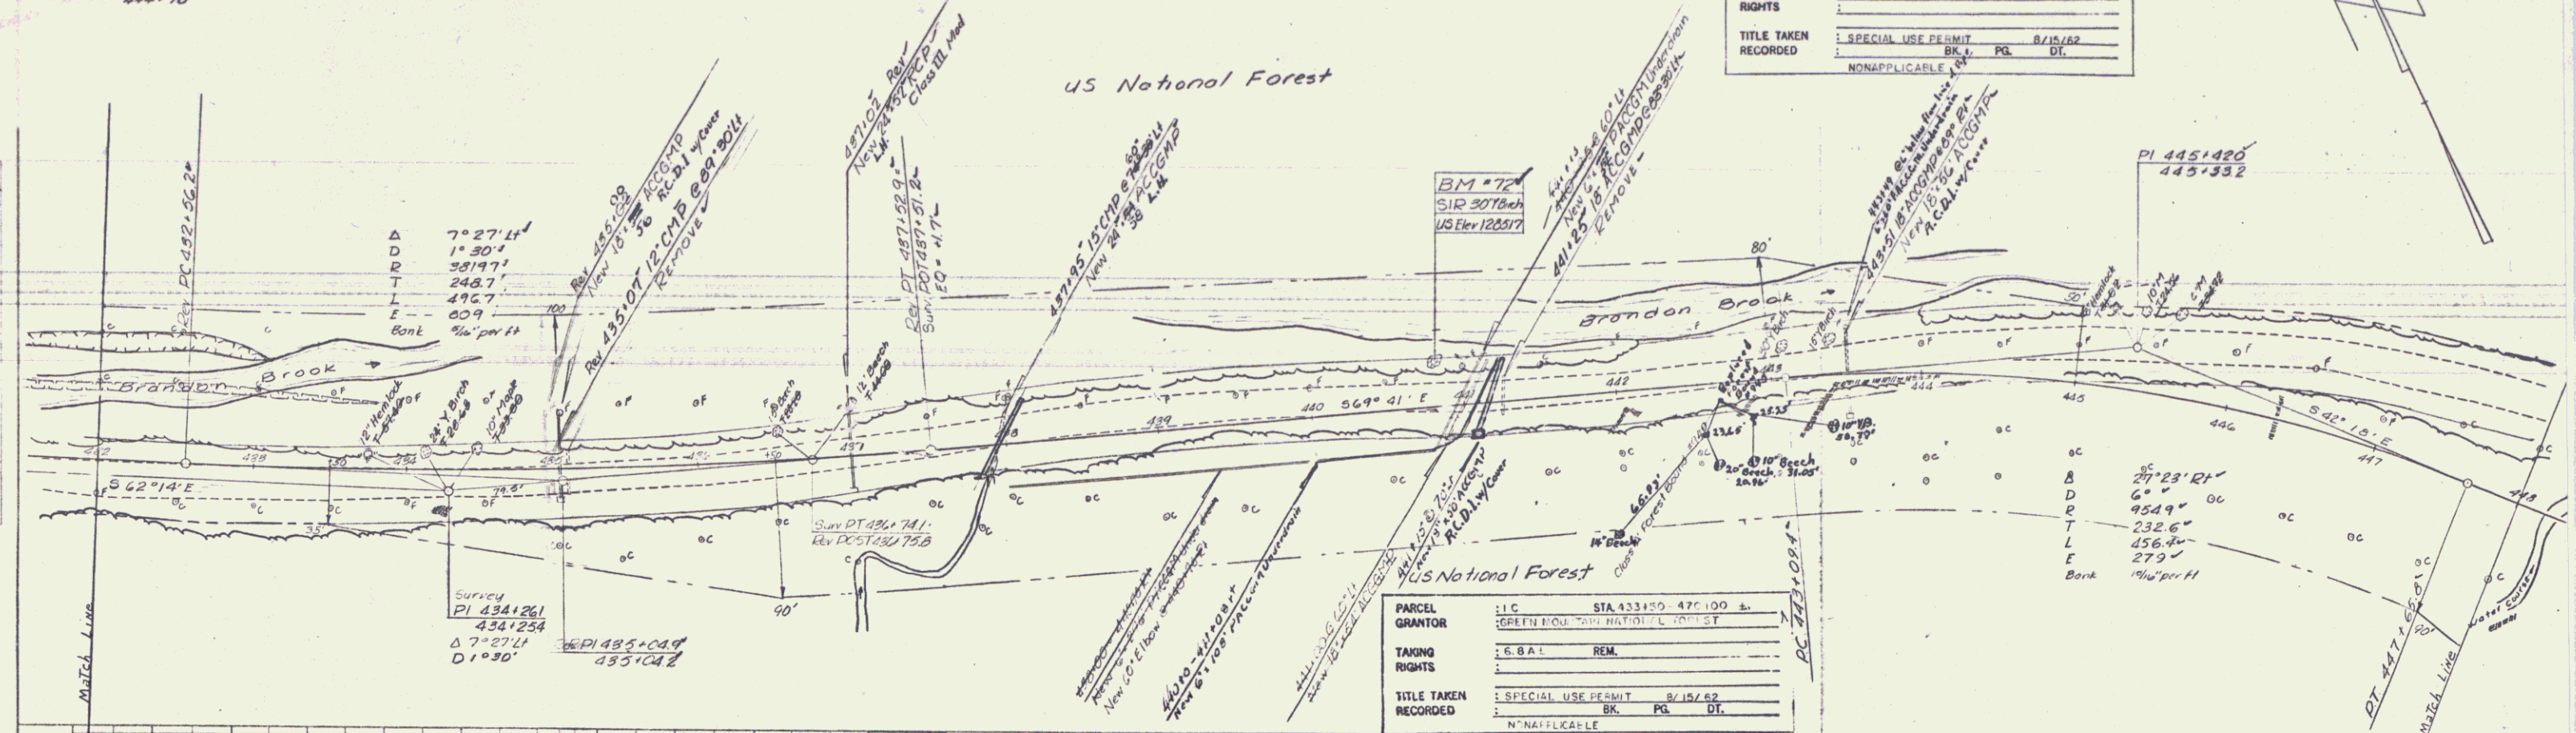

ROCHESTER-CHITTENDEN
 Project No. 0162(3)
 Sheet 27 of 28

PLATE 1 - ROAD PROFILE & SUB-GRADE
 REVISIONS & CHECKS ON PLAN