

INSTRUCT DRIVE
 480+00 - 490+10
 481+60
 485+00
 80°
 80°

TWO CABLE GUARD RAIL
 480+42 - 480+80
 477+35 - 491+00

STONE FILL FOR SLOPE PROTECTION
 477+90 - 484+70

UNCLASSIFIED CHANNEL EXCAVATION
 478+20 - 490+00
 483+00 - 485+50

PARCEL STATIONS	140
TAKING	147+00 - 493+00
	1.0825



REV. 7-14-62
JED

A 3°26'11"
 D 5724'
 T 1717'
 L 3435'
 E 257'
 Remove Crown

PARCEL STATIONS	14C
TAKING	147+00 - 493+60
	1.2745

PLAN
 DATE: 10/1/62
 DRAWN BY: JED
 CHECKED BY: JED
 IN CHARGE: JED

PROFILE
 DATE: 10/1/62
 DRAWN BY: JED
 CHECKED BY: JED
 IN CHARGE: JED

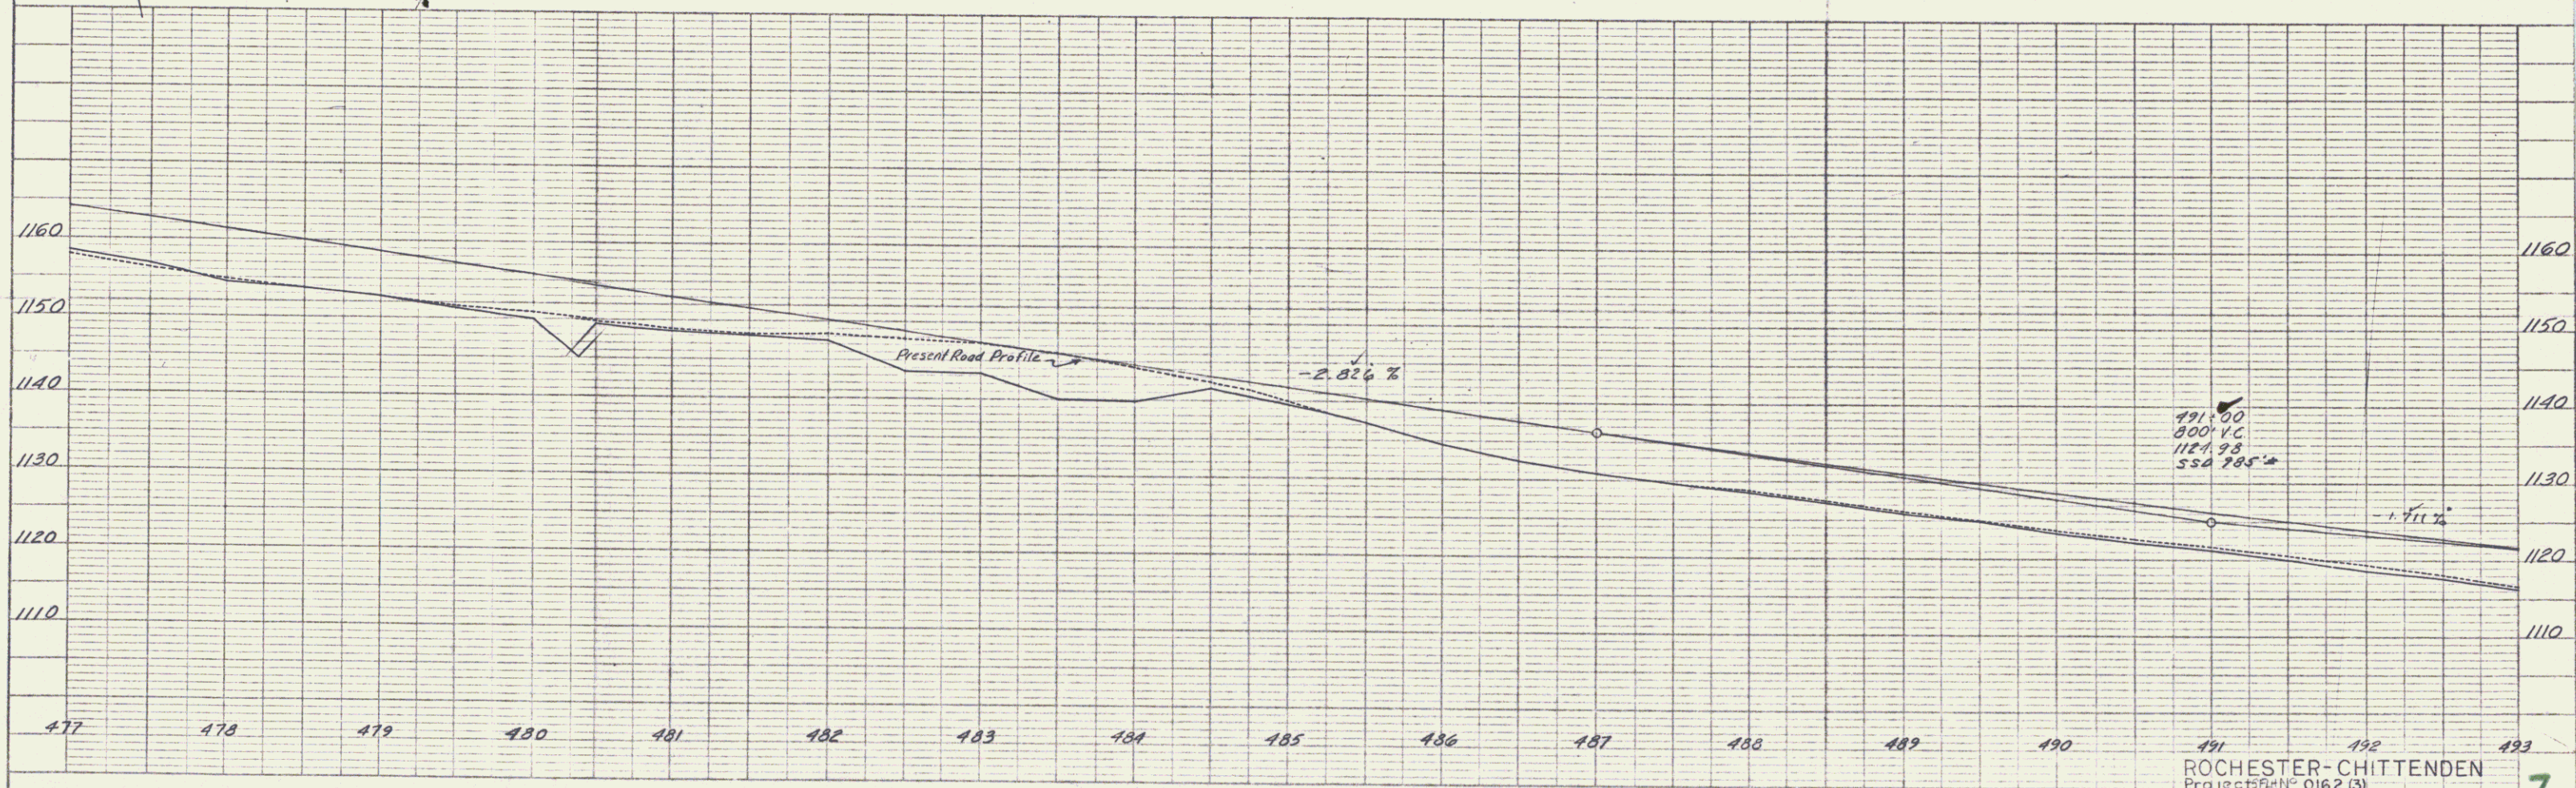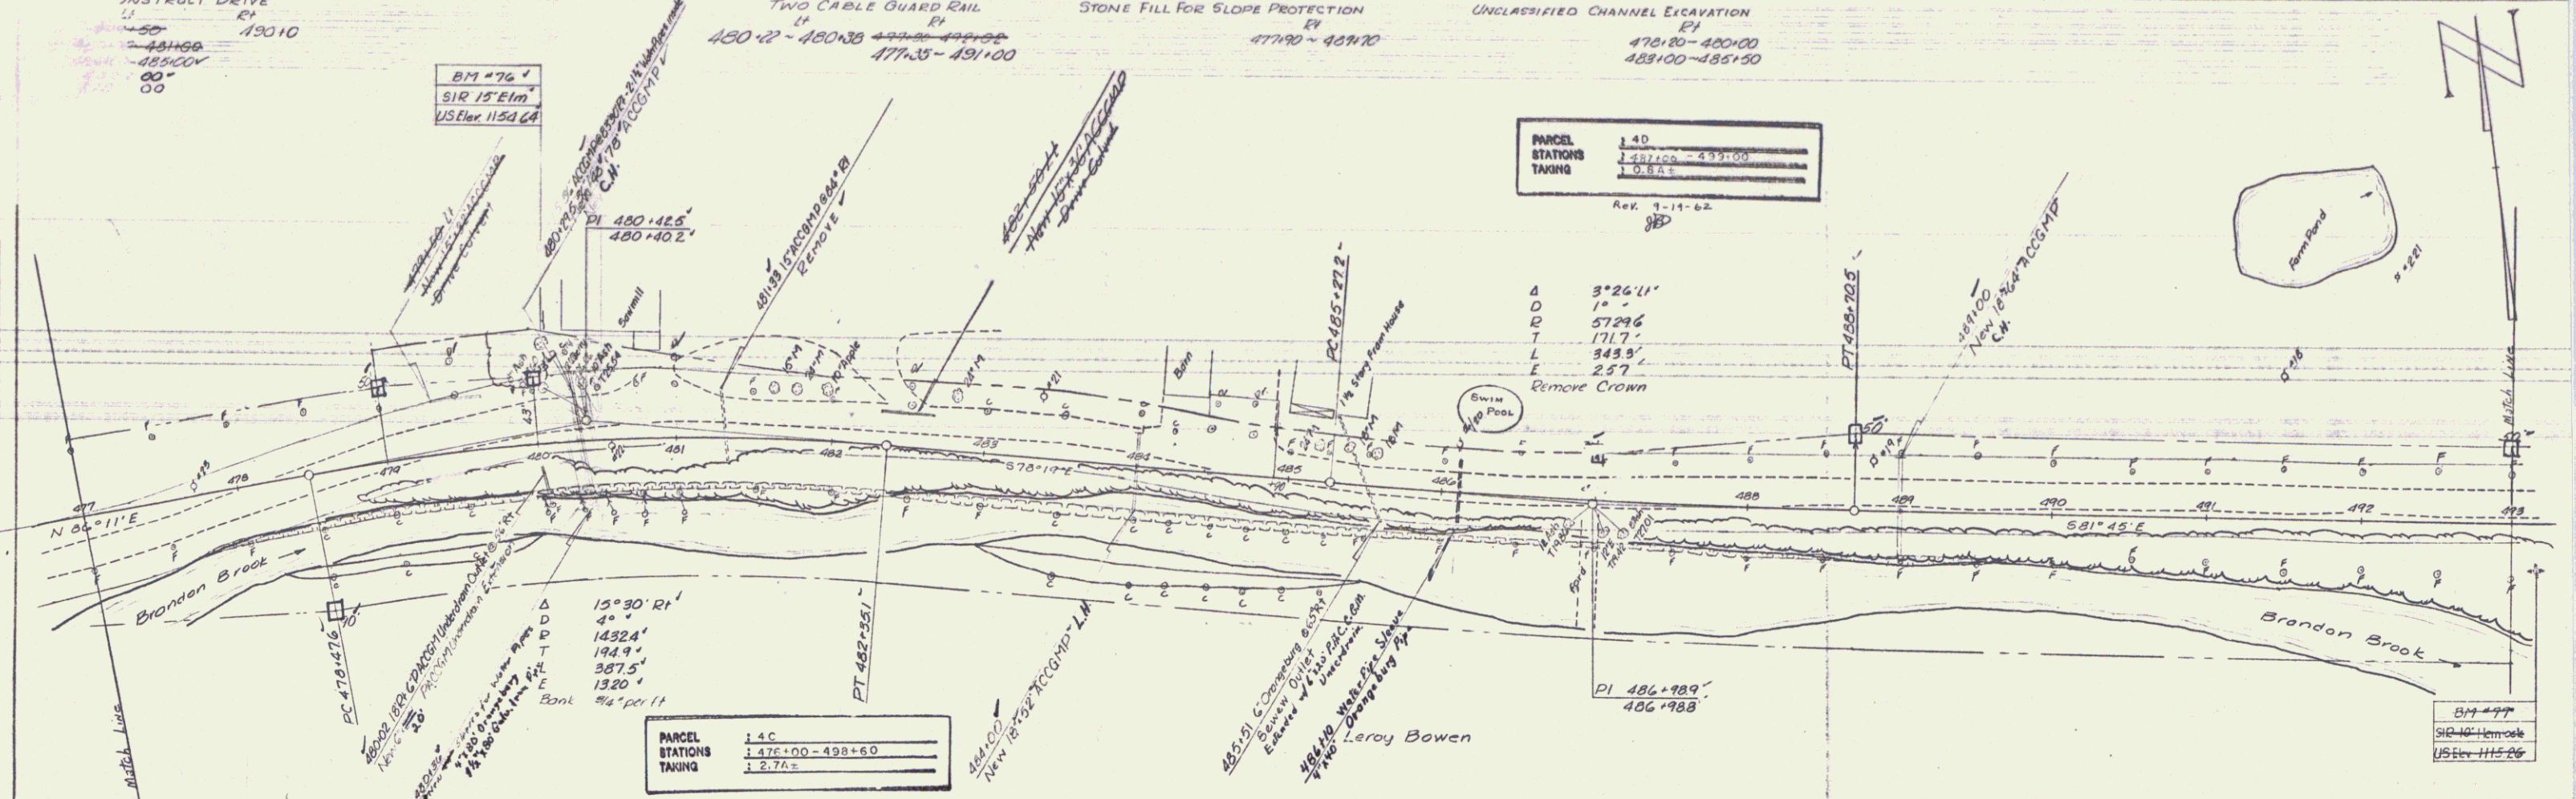

ROCHESTER-CHITTENDEN
 PROJECT # 0162 (3)
 SHEET 7 OF 7

PLAN, PROFILE, D.P. & E. STANDARD
 RIGHTS & LICENSES, NEW YORK
 R. & E. CO. 248-103
 1962