

CABLE GUARD RAIL 209+30-309+00
 UNCLASSIFIED CHANNEL EXCAVATION 305+50-309+00
 STONE FILL FOR SLOPE PROTECTION 305+50-309+00

GRADING ITEM 602
 506+00-508+00

PARCEL GRANTOR	I 7A B	STA 498+50-507+22 ±
TAKING RIGHTS	RE.M.	
TITLE TAKEN RECORDED	8/14/62	
	ROCHESTER BK 34 PG 252 DT 11/15/62	

PARCEL STATIONS TAKING	I 7 B	1498+77-505+50
		49.7A 1

PARCEL STATIONS TAKING	I 7 A	1498+77-507+22
		49.7A 1

PARCEL GRANTOR	I F	STA 506+64-525+00 ±
TAKING RIGHTS	RE.M.	
TITLE TAKEN RECORDED	SPECIAL USE PERMIT	8/15/62
		NONAPPLICABLE

PLAN
 SHEET NO. 33
 DATE 11/15/62

PROFILE
 SHEET NO. 33
 DATE 11/15/62

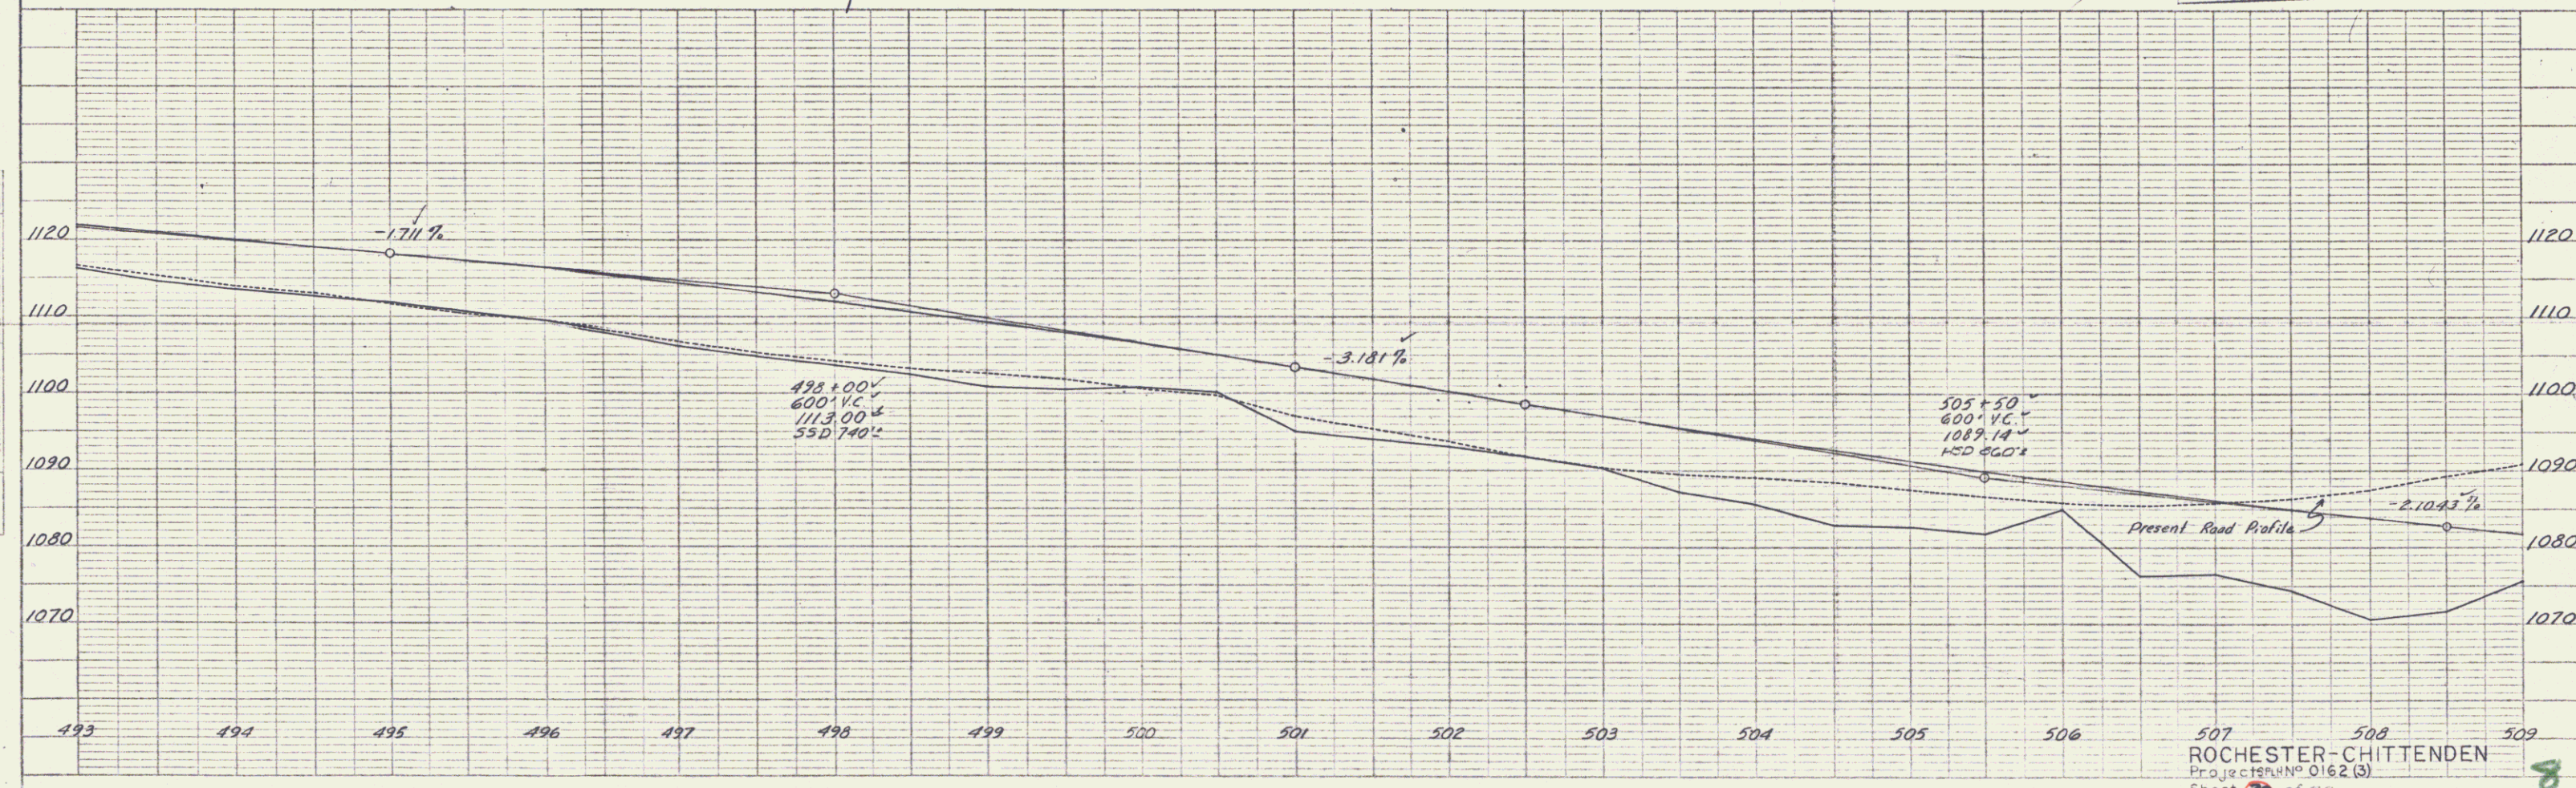
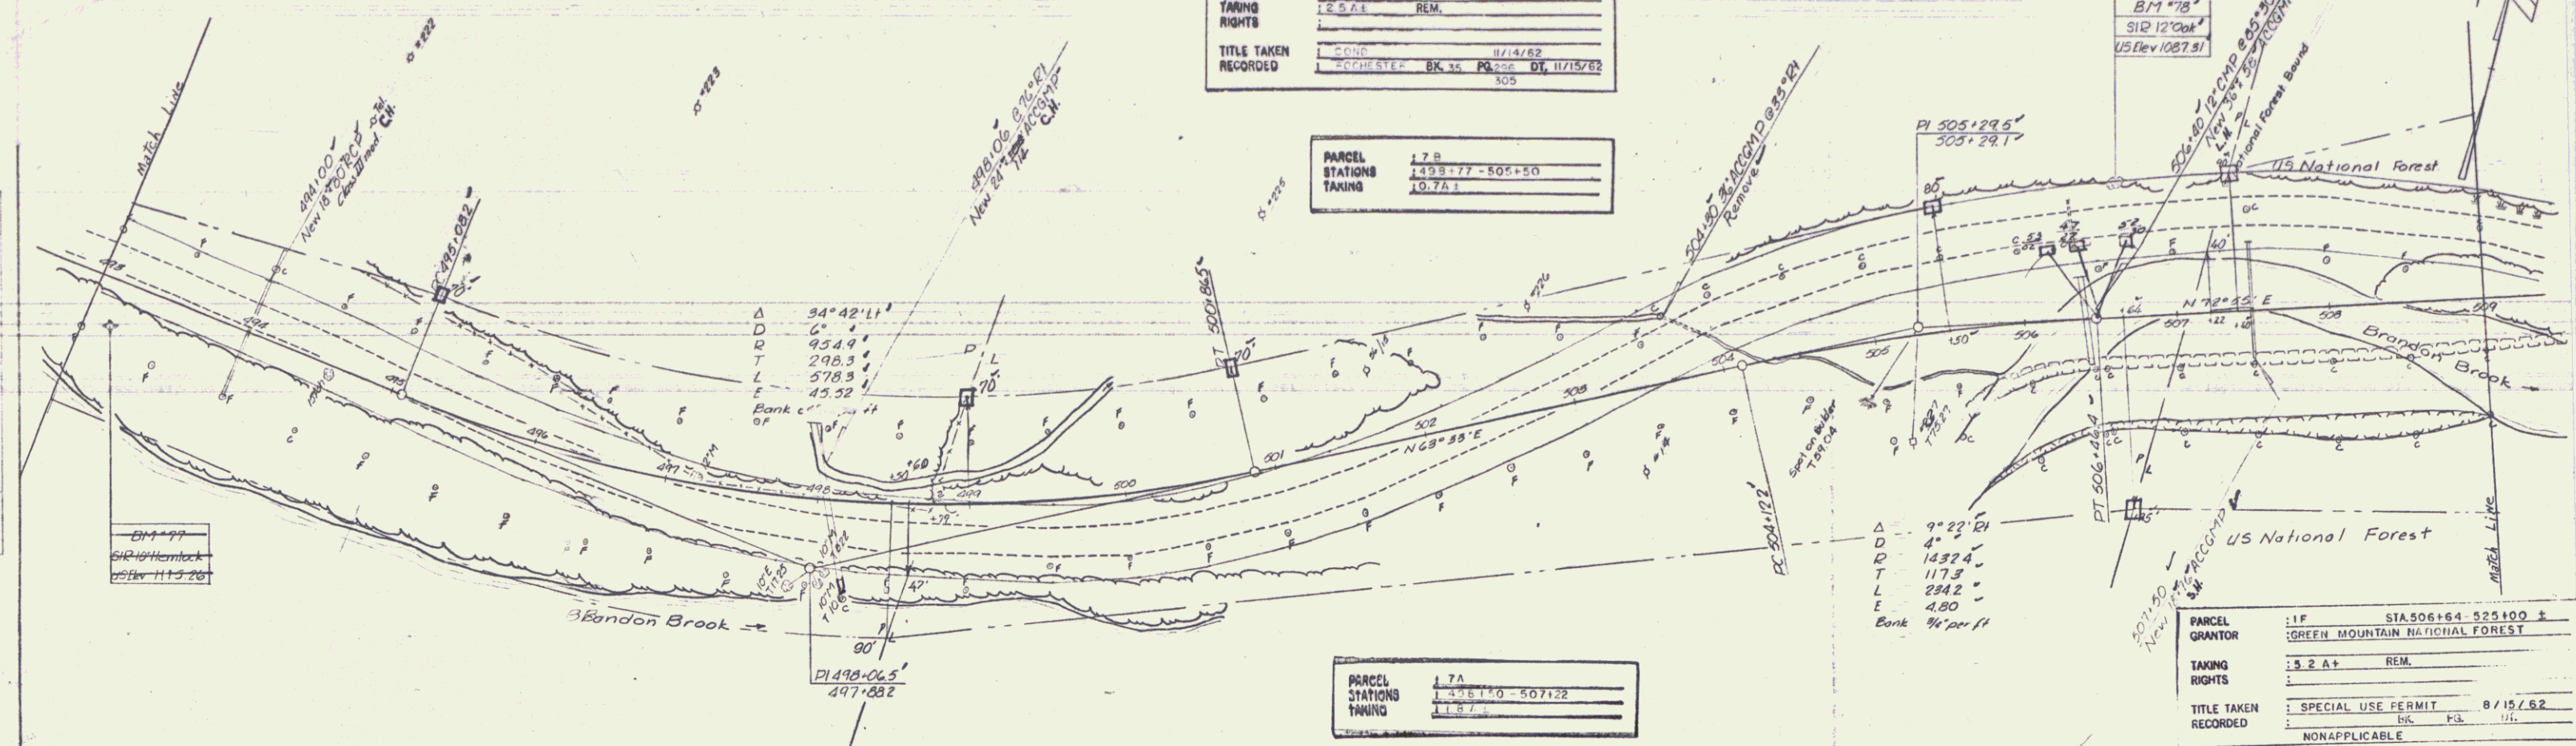


PLATE 1: PLAN - PROFILE. D. P. & R. E. BRADDOCK
 BRADDOCK & ASSOCIATES, INC.
 100 N. WASHINGTON ST., ROCHESTER, N.Y.

ROCHESTER-CHITTENDEN
 PROJECT NO. 0162 (3)
 Sheet 33 of 38