

TWO CABLE GUARD RAIL
RT
509+00 - 510+28
510+75 - 511+25
509+00 - 510+14
515+70 - 523+78

UNCLASSIFIED CHANNEL EAVATION
RT
509+00 - 509+57
515+00 - 523+22

CONSTRUCT DRIVE
RT
515+00 - 515+00

STONE FILL FOR SLOPE PROTECTION
RT
509+00 - 509+57
515+00 - 523+22

CONSTRUCT EARTH DIKE FOR STREAM DIVERSION
RT
515+00 - 514+50
GRADING ITEM 602
LI
521+00 - 522+00



Blasting of Solid Rock
Grade from 114
509+50 - 510+60

PARCEL	1:1 G	STA. 507+40 - 514+00 ±
GRANTOR	1: GREEN MOUNTAIN NATIONAL FOREST	
TAKING RIGHTS	1: I.O.A. ±	REM.
TITLE TAKEN	1: SPECIAL USE PERMIT	8/15/62
RECORDED	1: BK.	PG. 01.
	NONAPPLICABLE	

PARCEL	1:1 H	STA. 522+00 - 523+62 ±
GRANTOR	1: GREEN MOUNTAIN NATIONAL FOREST	
TAKING RIGHTS	1: I.O.A. ±	REM.
TITLE TAKEN	1: SPECIAL USE PERMIT	8/15/62
RECORDED	1: BK.	PG. 01.
	NONAPPLICABLE	

PLAN
DATE: 10/1/62
DRAWN BY: [Signature]
CHECKED BY: [Signature]
NO. 1

PROFILE
DATE: 10/1/62
DRAWN BY: [Signature]
CHECKED BY: [Signature]
NO. 1

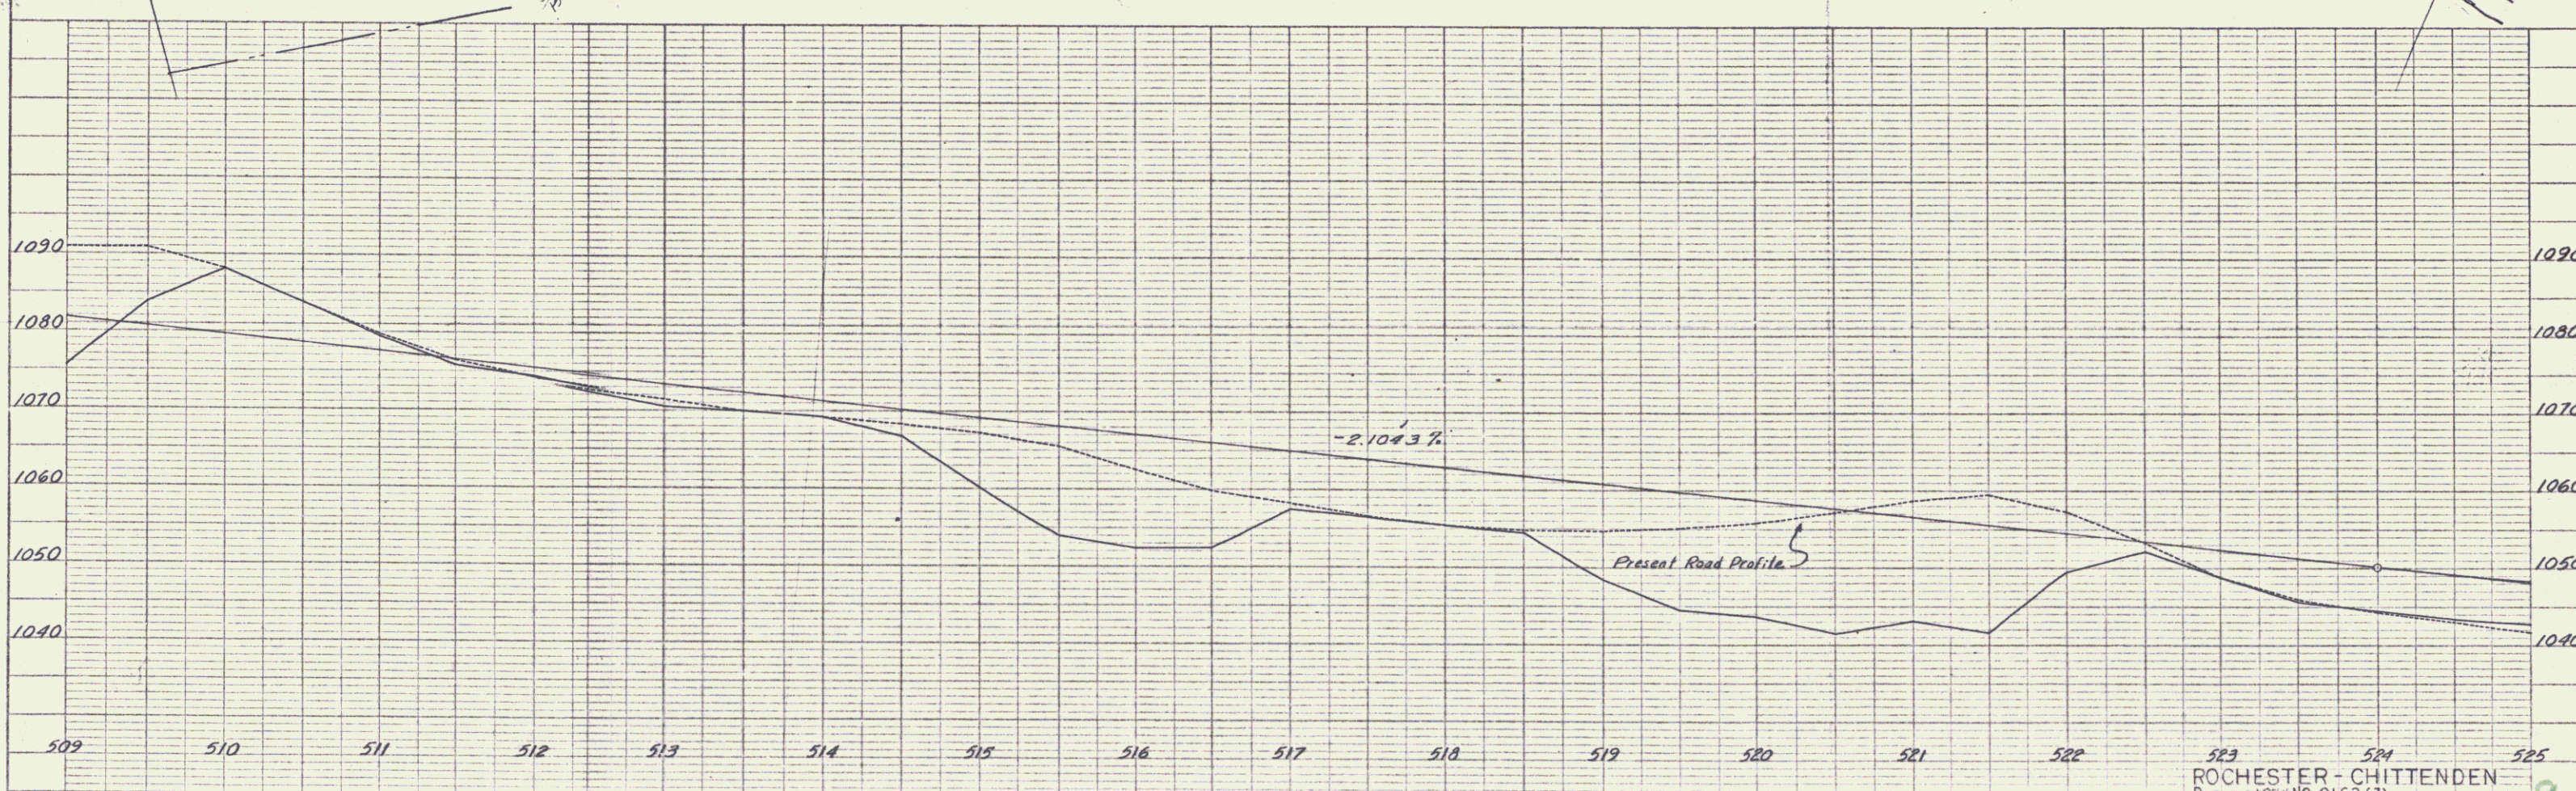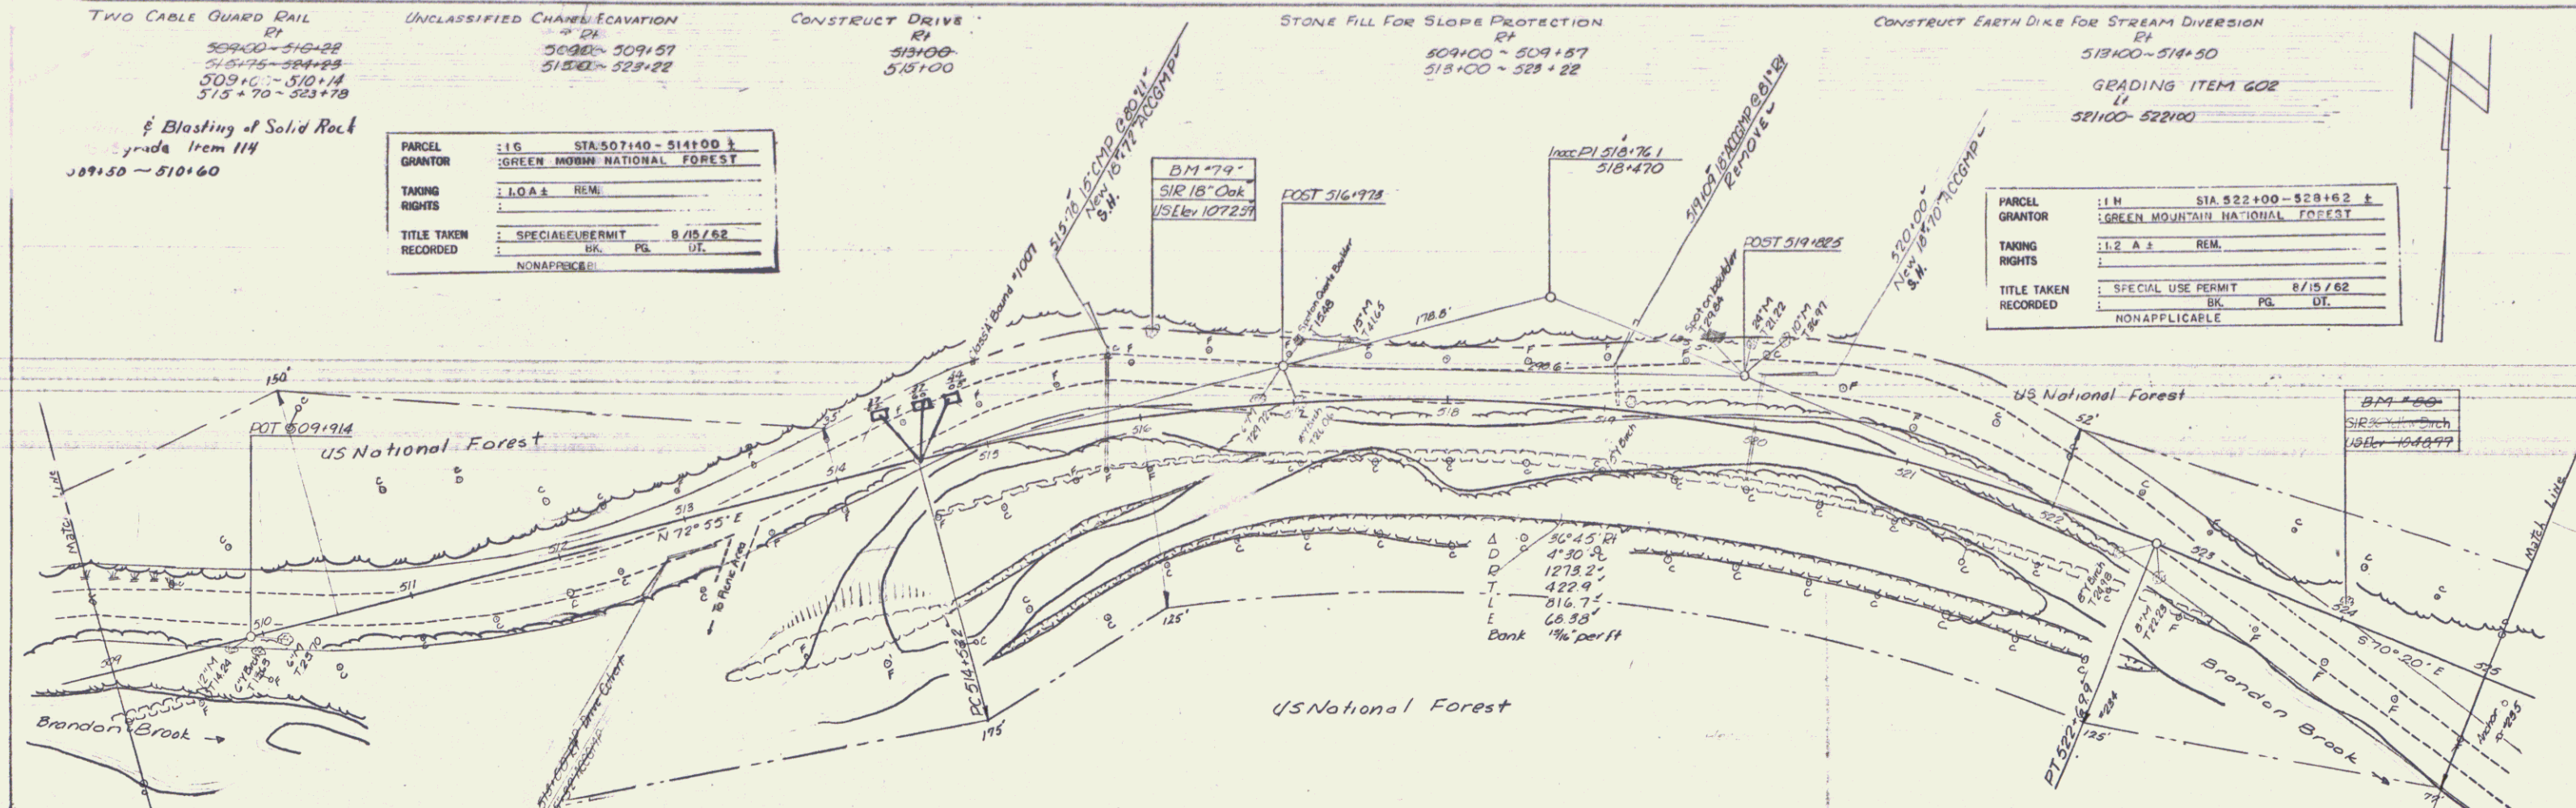

523 524 525
ROCHESTER - CHITTENDEN
Project No. 0162 (3)
Sheet 22 of 73

PLATE 1 - PLAN PROFILE C.H.A. & E. STANBARD
MADELL & FISHER CO. NEW YORK
110 N. 2nd St. NEW YORK
10012