

TWO CABLE GUARD RAIL
 LT 265+32-266+00 RT 265+32-266+00
 265+32-266+00
 Wood Guide Posts
 265+80-266+10

CONSTRUCT APPROACH
 LT 250+25 RT 250+25

CONSTRUCT DRIVES
 LT 259+00 RT 259+00
 250+20 RT 250+20
 258+33 RT 258+33
 262+10 RT 262+10



⊕ Indicates Cutting and Removing Trees, Item 110

PLAN

DATE	7/56
BY	LaKasa
CHECKED	LaKasa
IN CHARGE	MJ
SCALE	1"=50'
TRACED	

PROFILE

DATE	
BY	
CHECKED	
IN CHARGE	
SCALE	
TRACED	

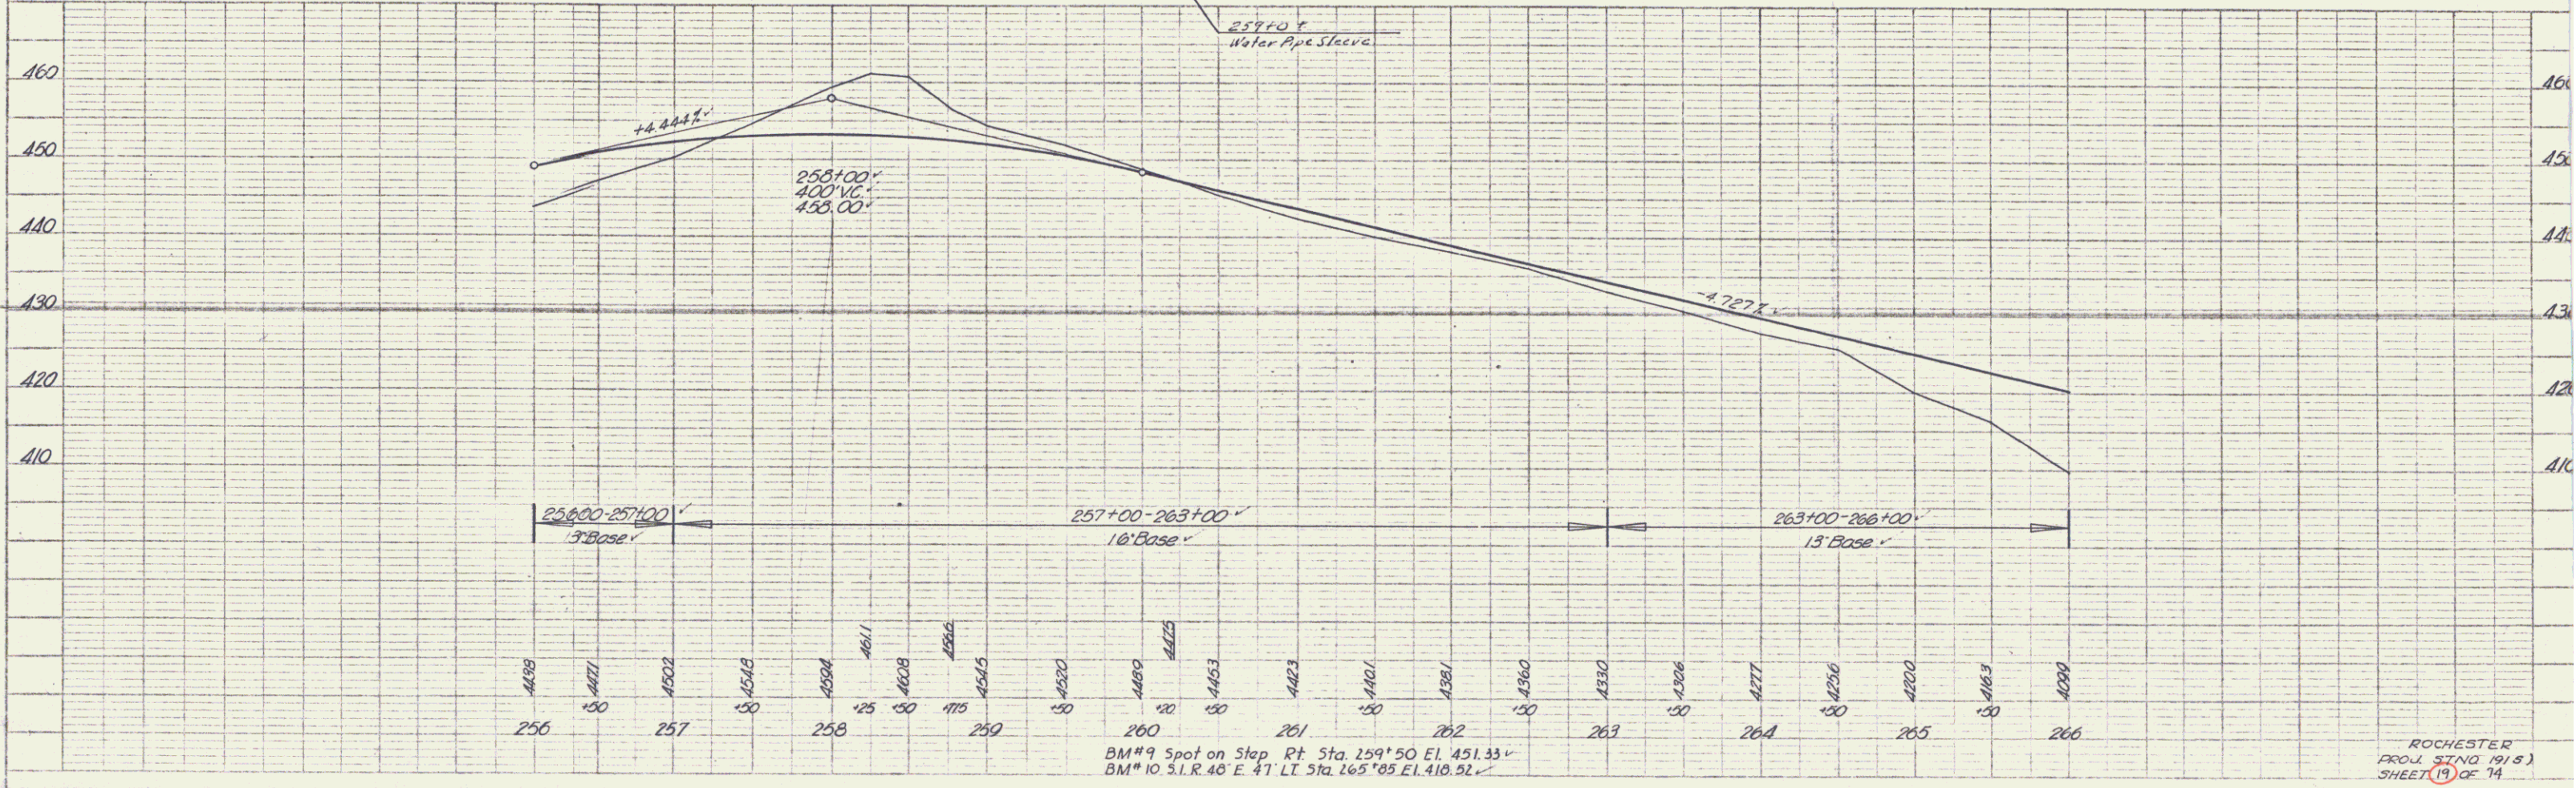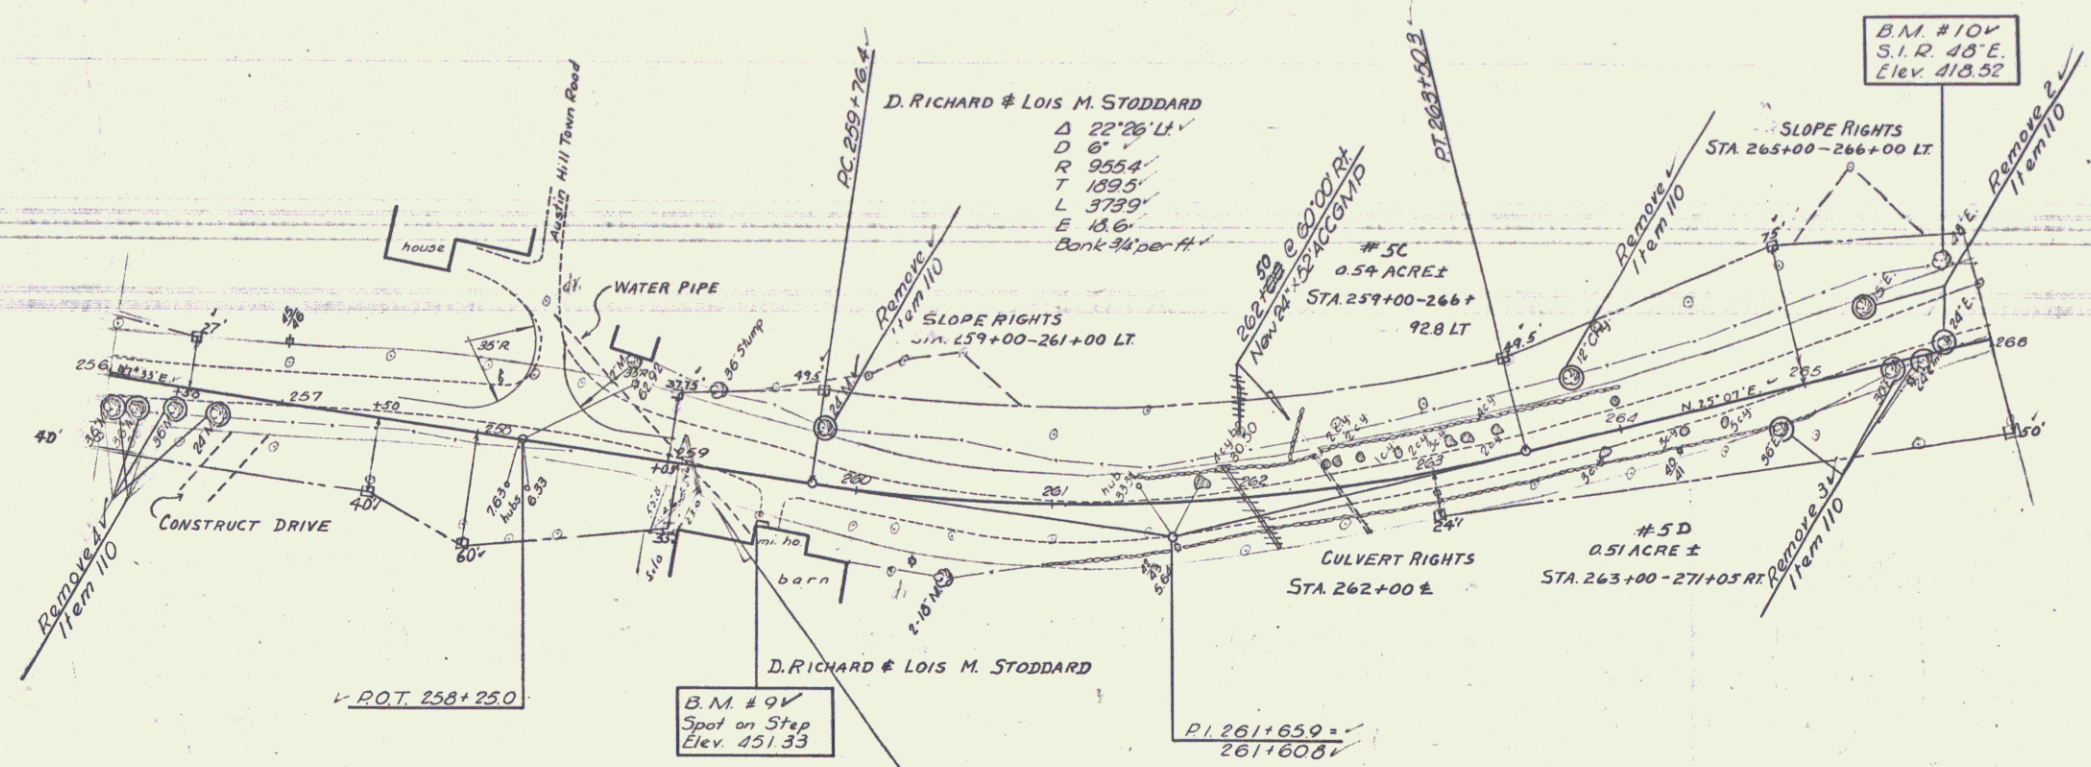

BM # 9 Spot on Step Rt Sta. 259+50 El. 451.33
 BM # 10 S.I.R. 40° E. 47' LT Sta. 265+05 El. 410.92