
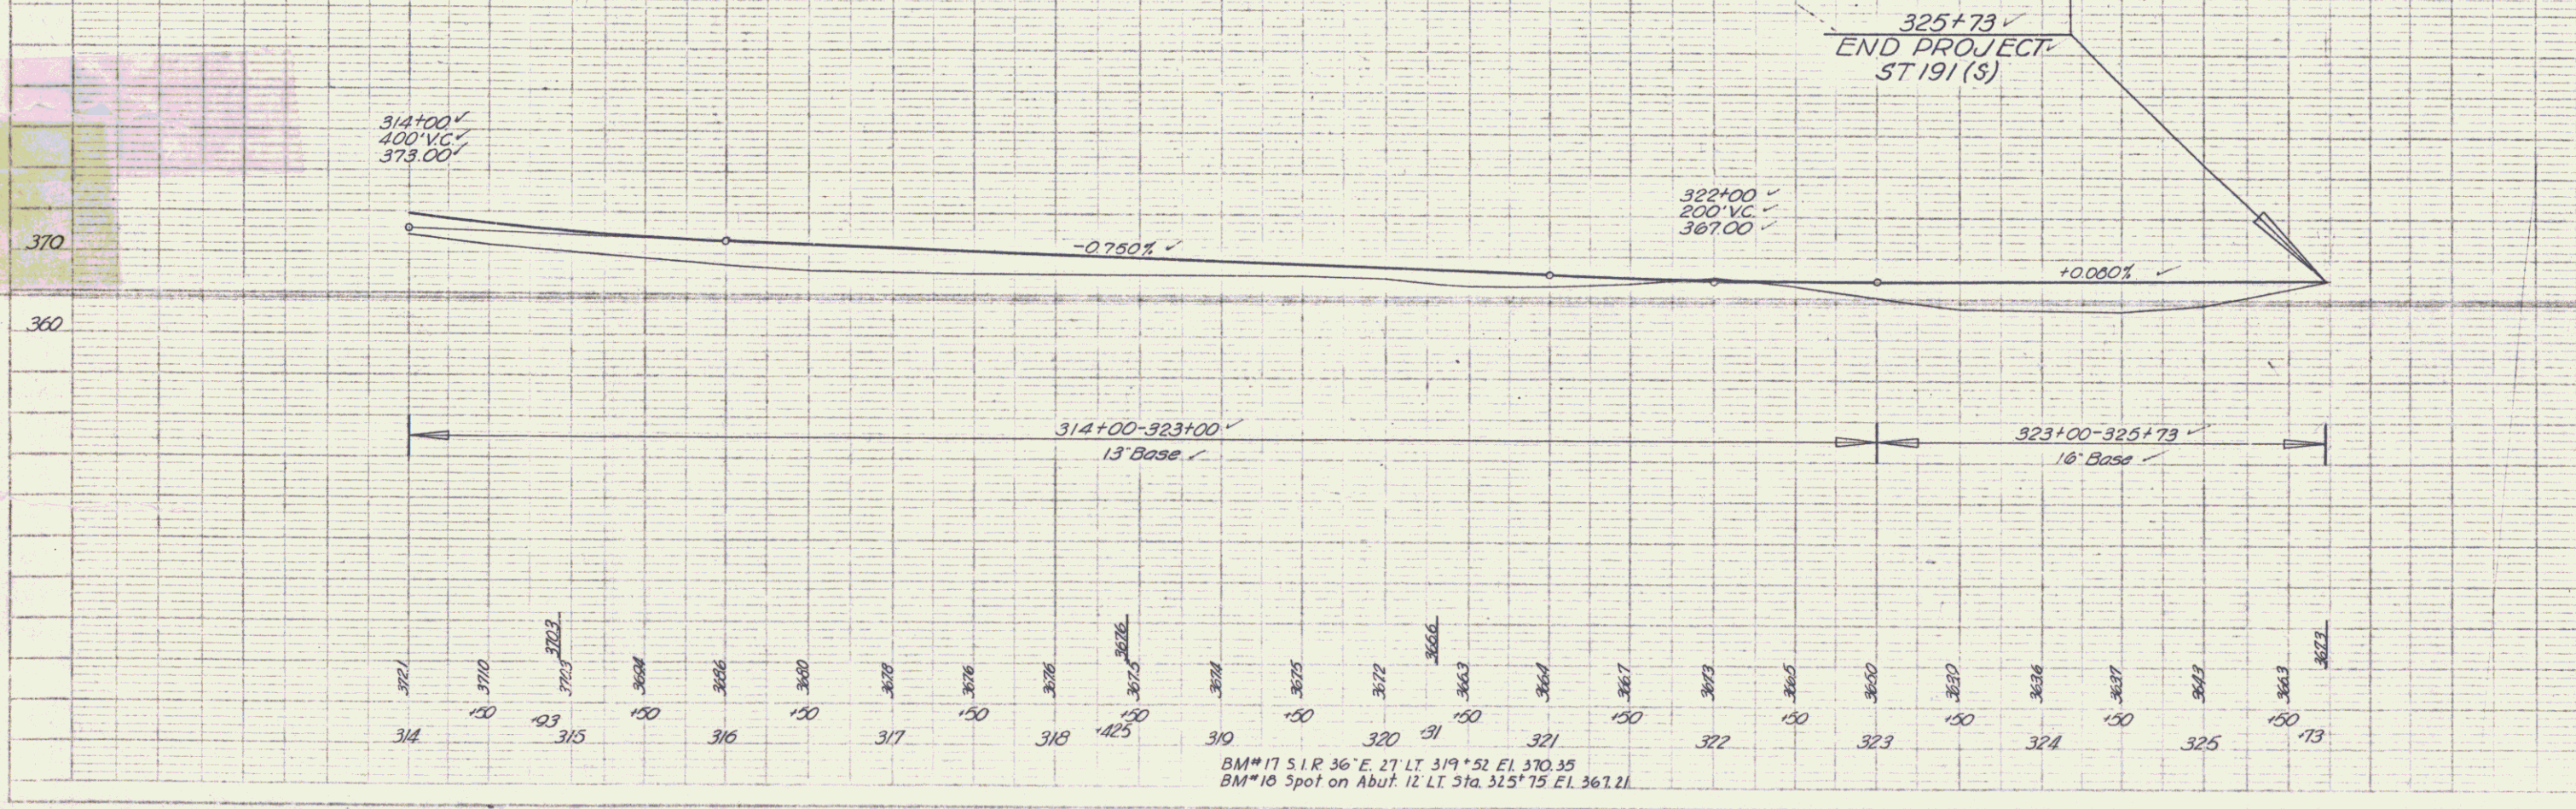


PLAN  
 DATE: 11/28  
 DRAWN BY: [unclear]  
 CHECKED BY: [unclear]  
 NO. 10  
 SHEET NO. 13 OF 14

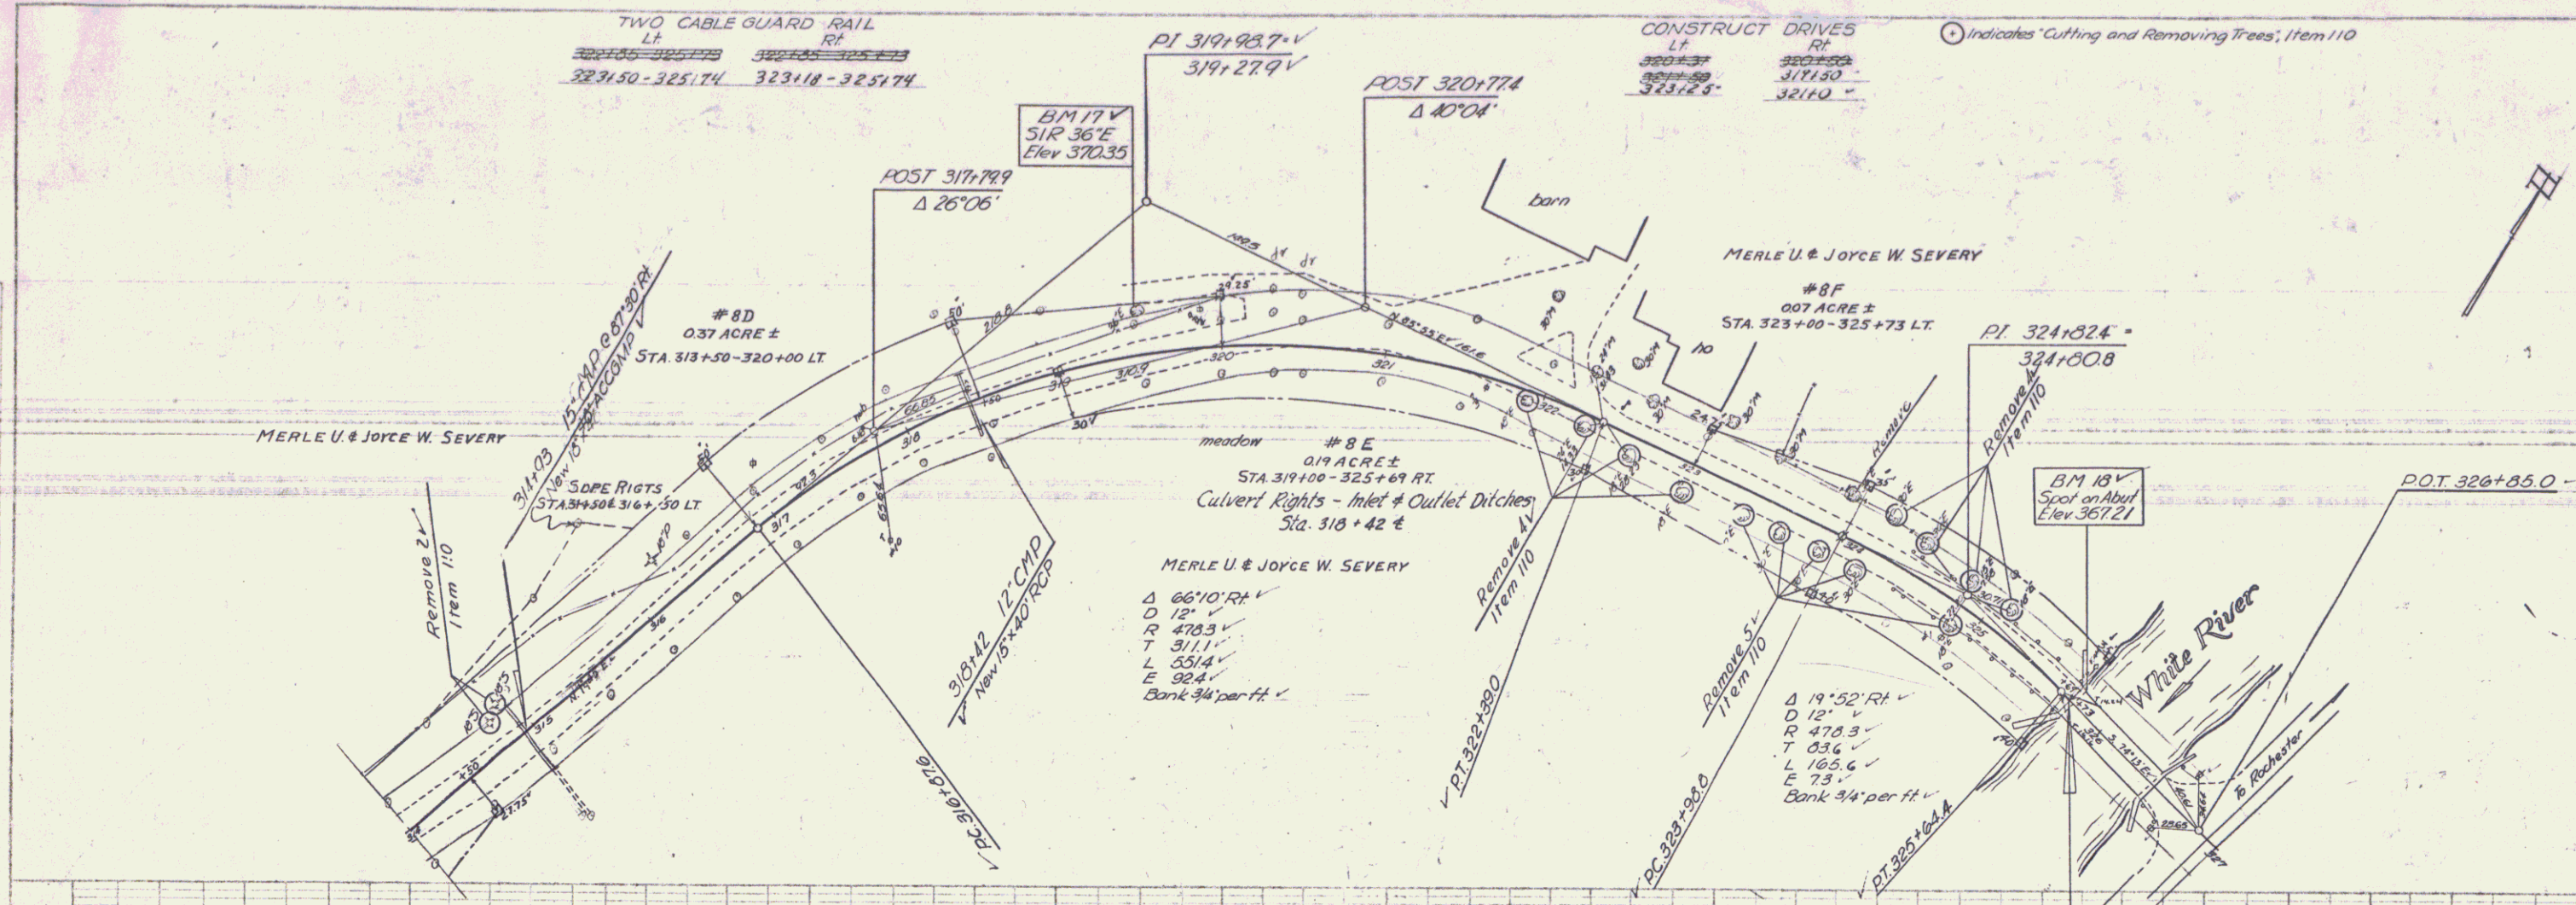

Rochester  
 Project 37 No. 191  
 Sheet 13 of 14