
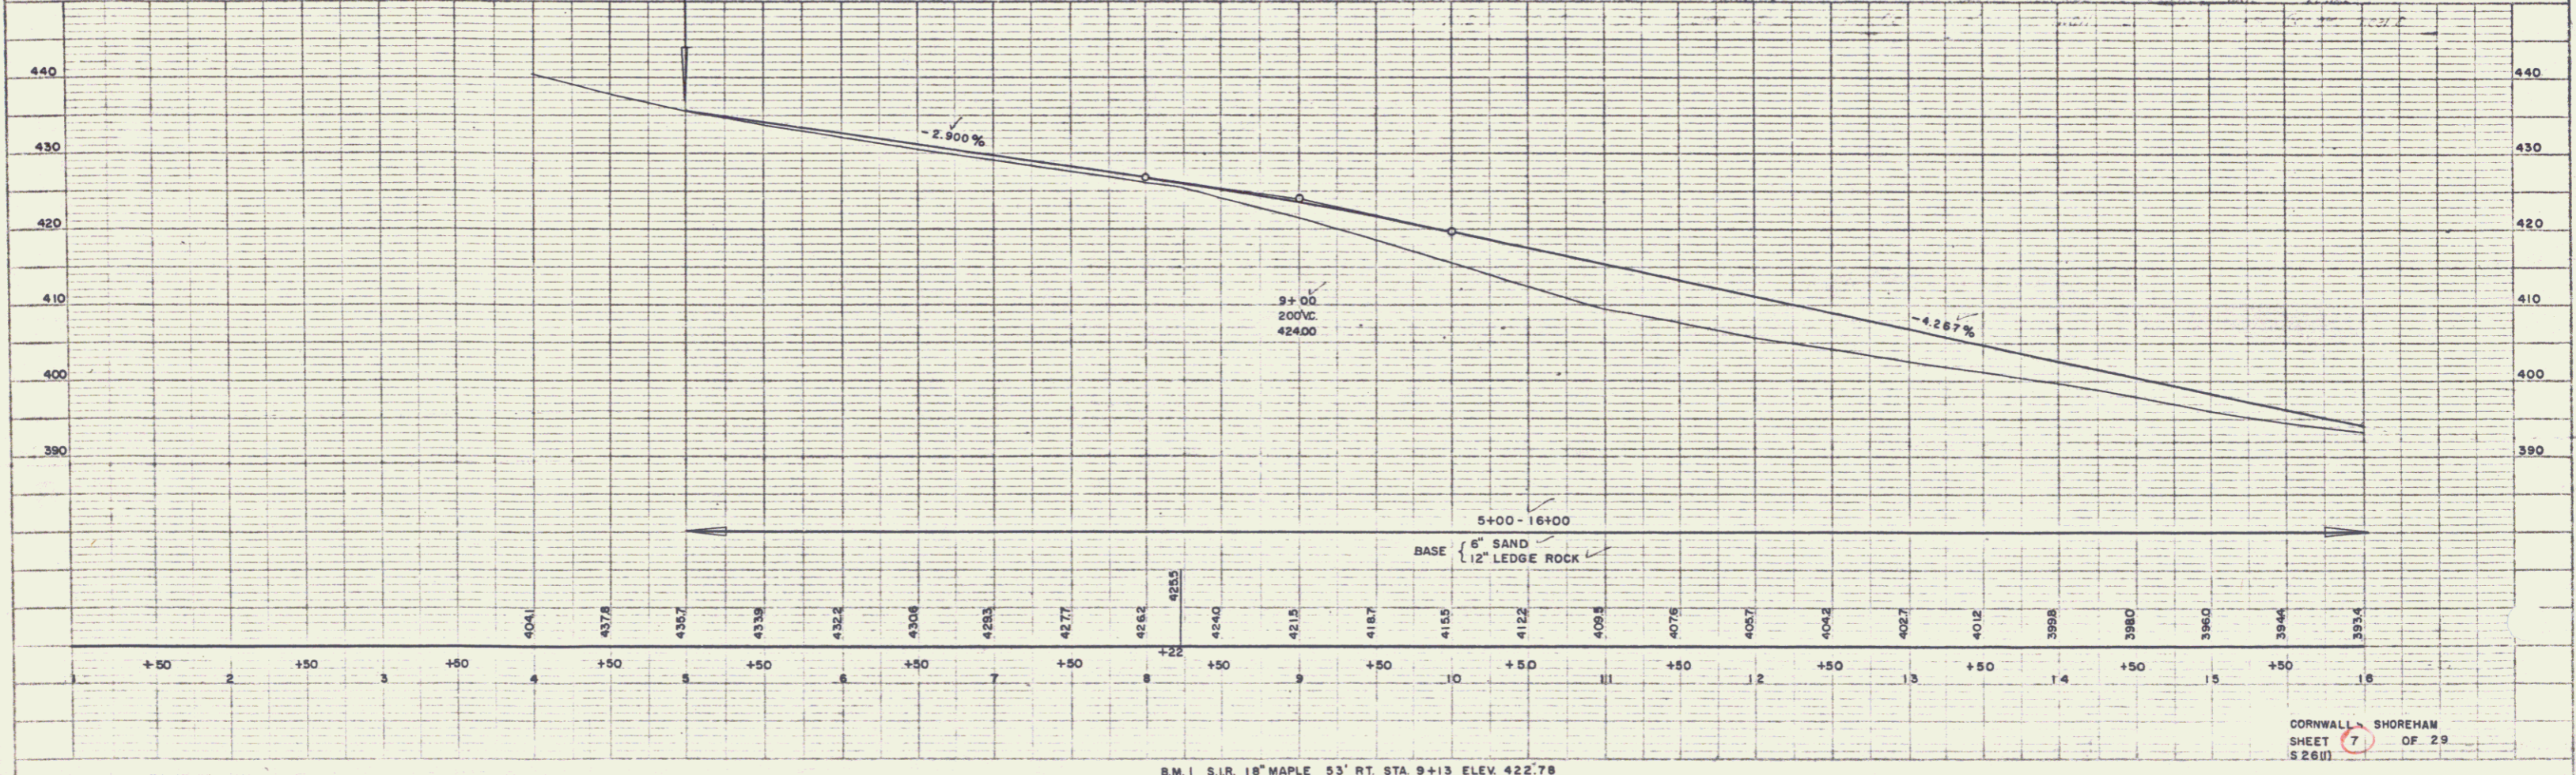


PLAN
 WESTER-MARTIN, INC.
 1001 W. 10th St.
 Des Moines, Iowa 50319

PROFILE
 WESTER-MARTIN, INC.
 1001 W. 10th St.
 Des Moines, Iowa 50319

CONSTRUCT APPROACHES	
STA.	RT. / LT.
8+22	RT.
8+30	LT.

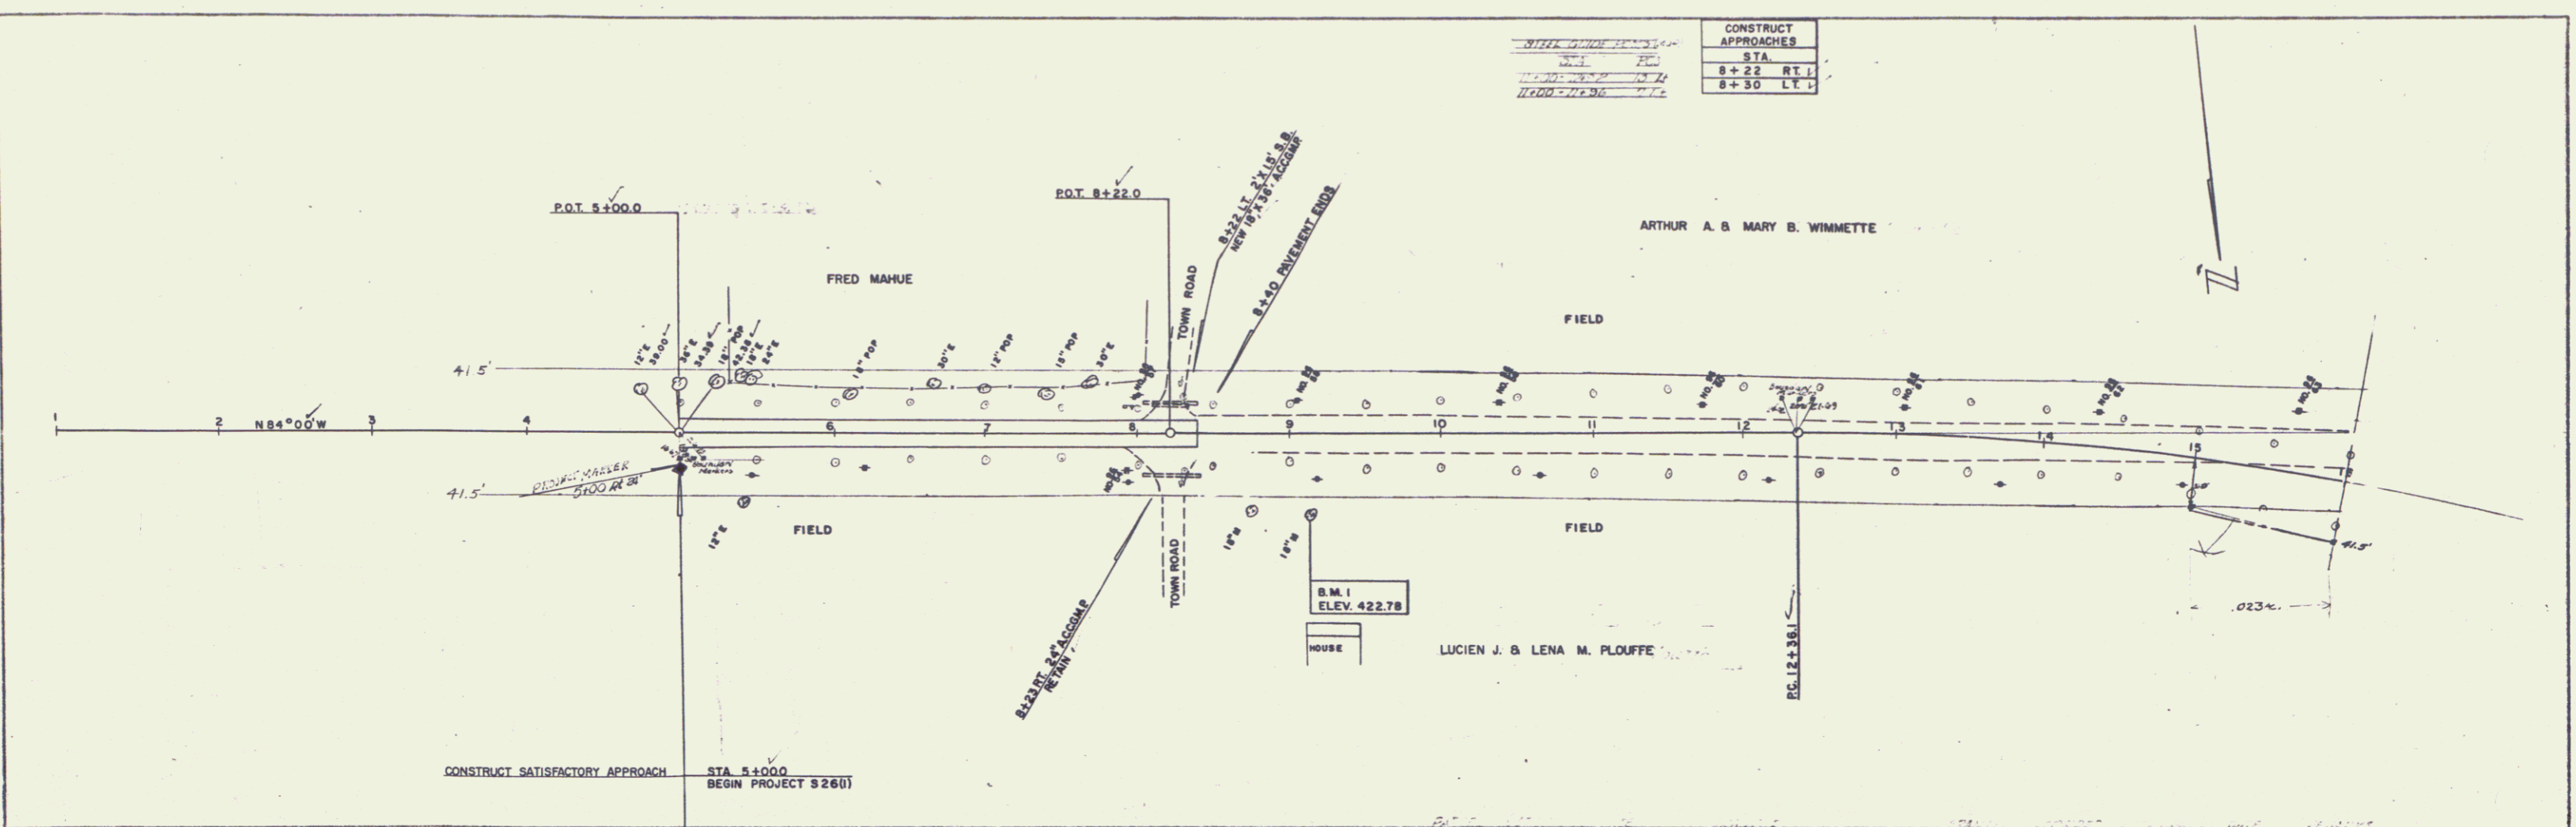

2