


WESTER-MARTIN, INC.  
 WESTER-MARTIN, INC.  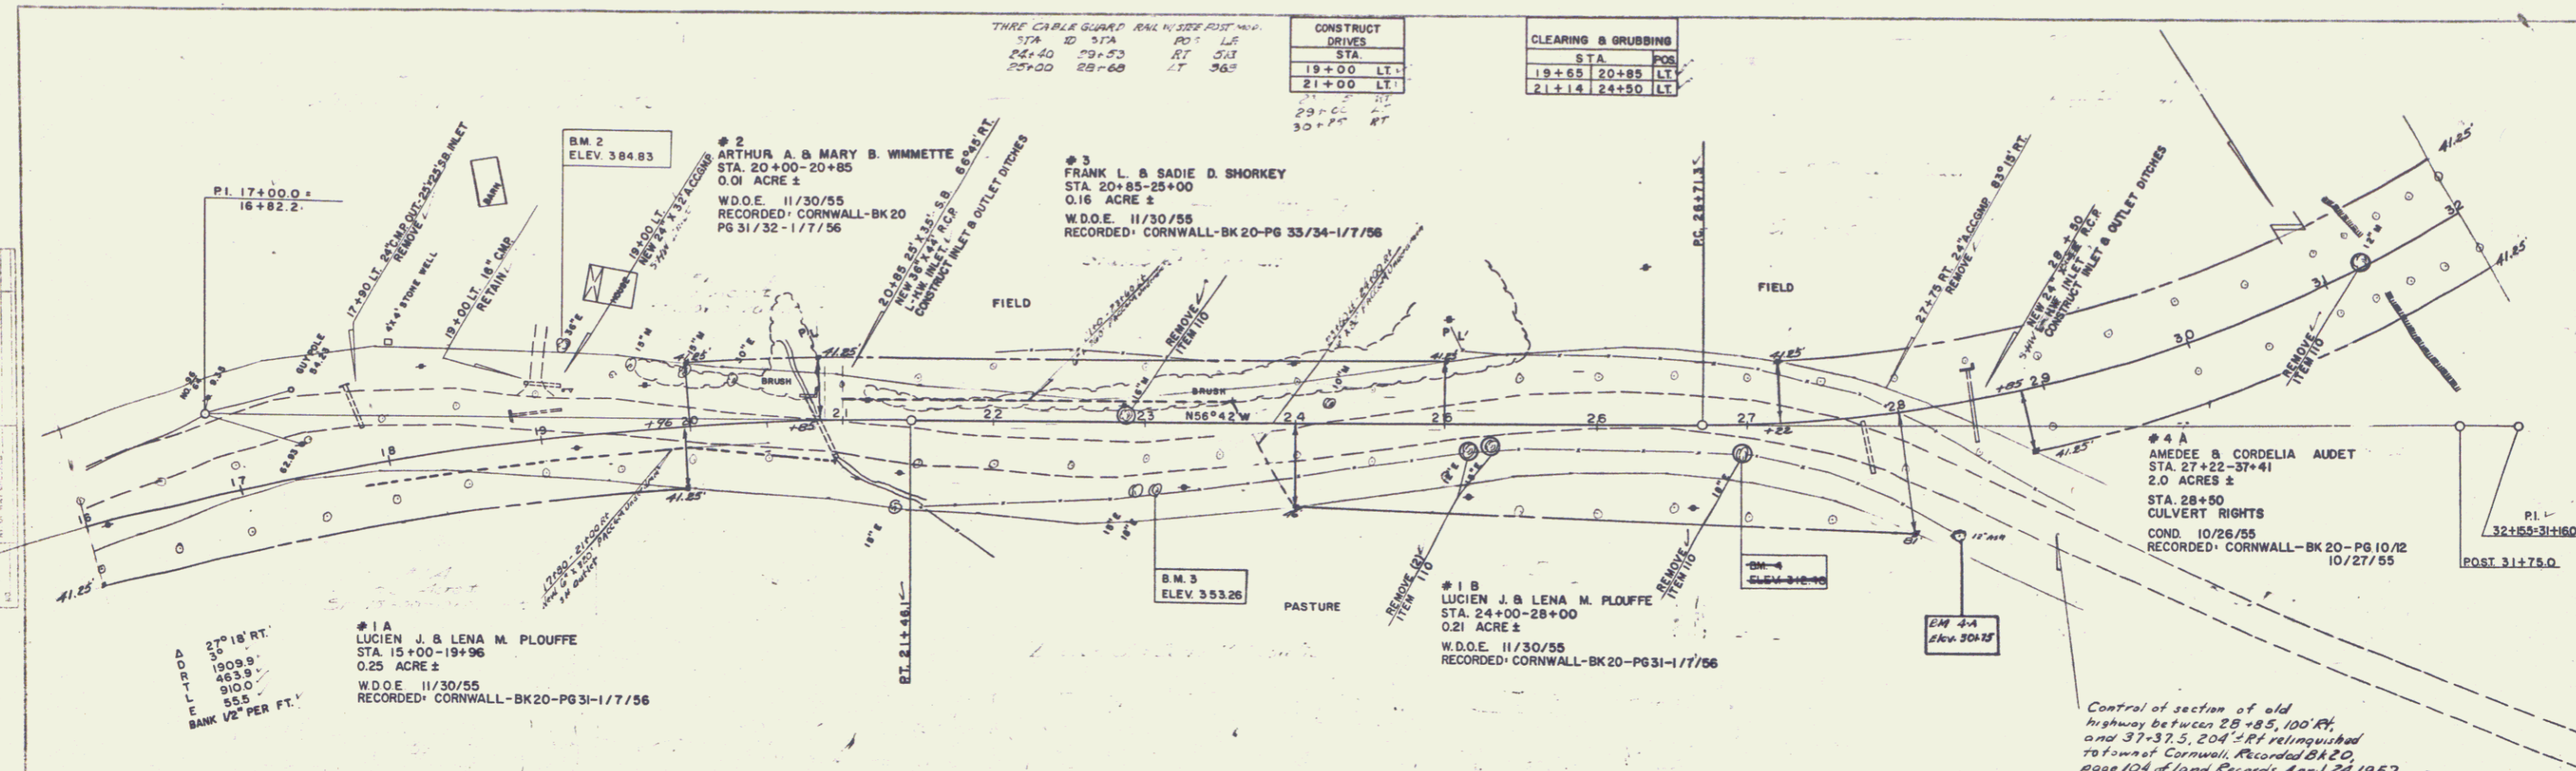
THREE CABLE GUARD RAIL W/ 3RD RISE  
 STA 10-51A PO 1 LR  
 24+40 29+53 RT 51A  
 25+20 28-60 LT 96S

CONSTRUCT DRIVES	
STA	POS
19+00	LT
21+00	LT

CLEARING & GRUBBING	
STA	POS
19+55	20+85 LT
21+14	24+50 LT

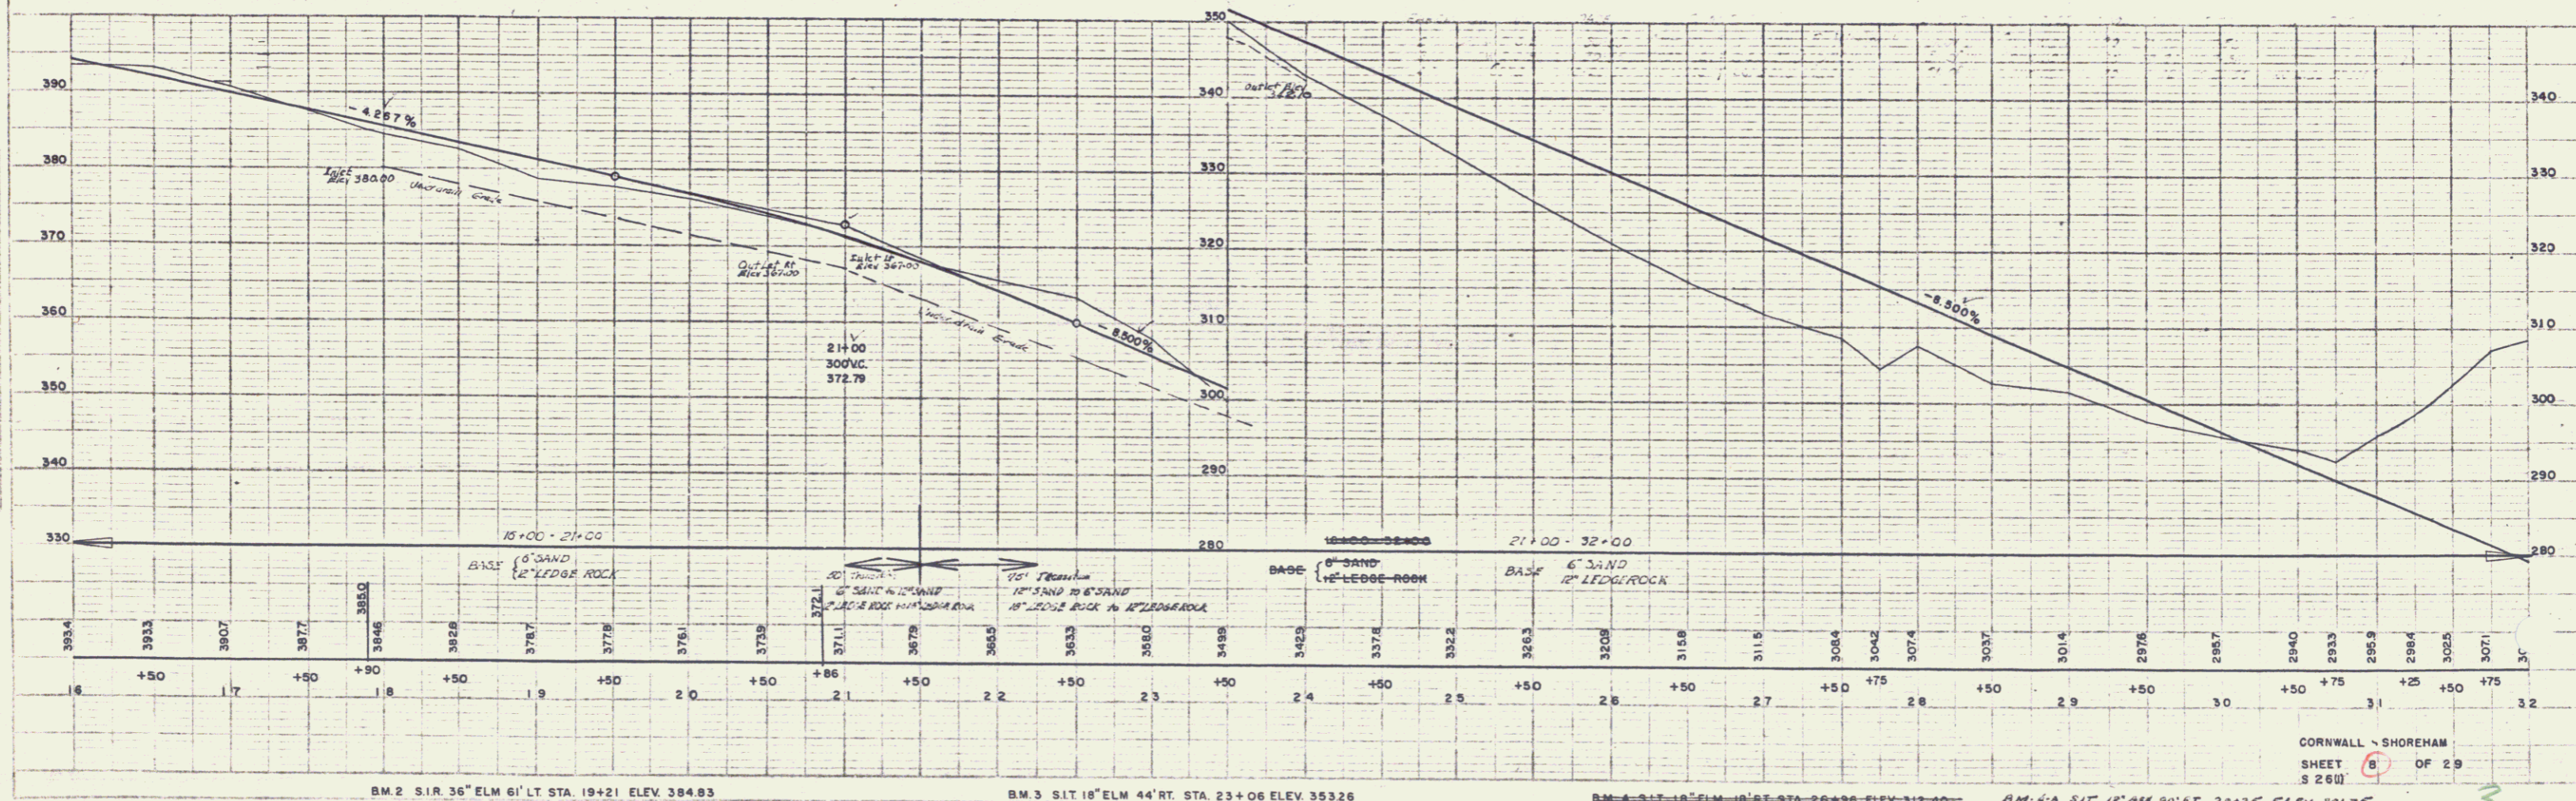

BM 2 S.I.R. 36" ELM 6' LT. STA. 19+21 ELEV. 384.83

BM 3 S.I.T. 18" ELM 44" RT. STA. 23+06 ELEV. 353.26

BM 4 S.I.T. 18" ELM 10' RT. STA. 26+96 ELEV. 312.10

BM 4-A S.I.T. 18" AM 90" RT. 23+26 ELEV. 304.25

CORNWALL - SHOREHAM  
 SHEET 6 OF 29  
 S 260