

THREE CABLE GUARD RAIL W/STEEL POSTS (N.C.)

STA TO	STA	POS	LT
44+03	54+33	RT	1000
44+03	54+33	RT	3000
45+03	54+11	RT	110

CLEARING & GRUBBING	
STA	POS
48+00	48+10 LT



CONSTRUCT DRIVES	
STA	POS
49+50	RT

4 D  
 AMEDEC & CORDELIA AUDET  
 STA. 45+00-55+27  
 0.23 ACRE ±  
 STA. 48+50  
 CULVERT RIGHTS  
 COND. 10/26/55  
 RECORDED SHOREHAM-BK 25-PG 530/531-10/27/55  
 514.45+00 = 27.45

P.O.T. 56+02.6  
 USGS BM  
 ELEV. 155.072

PLAN  
 WESTERN-MARTIN, INC.  
 1000 WESTERN AVENUE  
 WASHINGTON, D.C. 20004  
 1000 WESTERN AVENUE  
 WASHINGTON, D.C. 20004

PROFILE  
 WESTERN-MARTIN, INC.  
 1000 WESTERN AVENUE  
 WASHINGTON, D.C. 20004  
 1000 WESTERN AVENUE  
 WASHINGTON, D.C. 20004

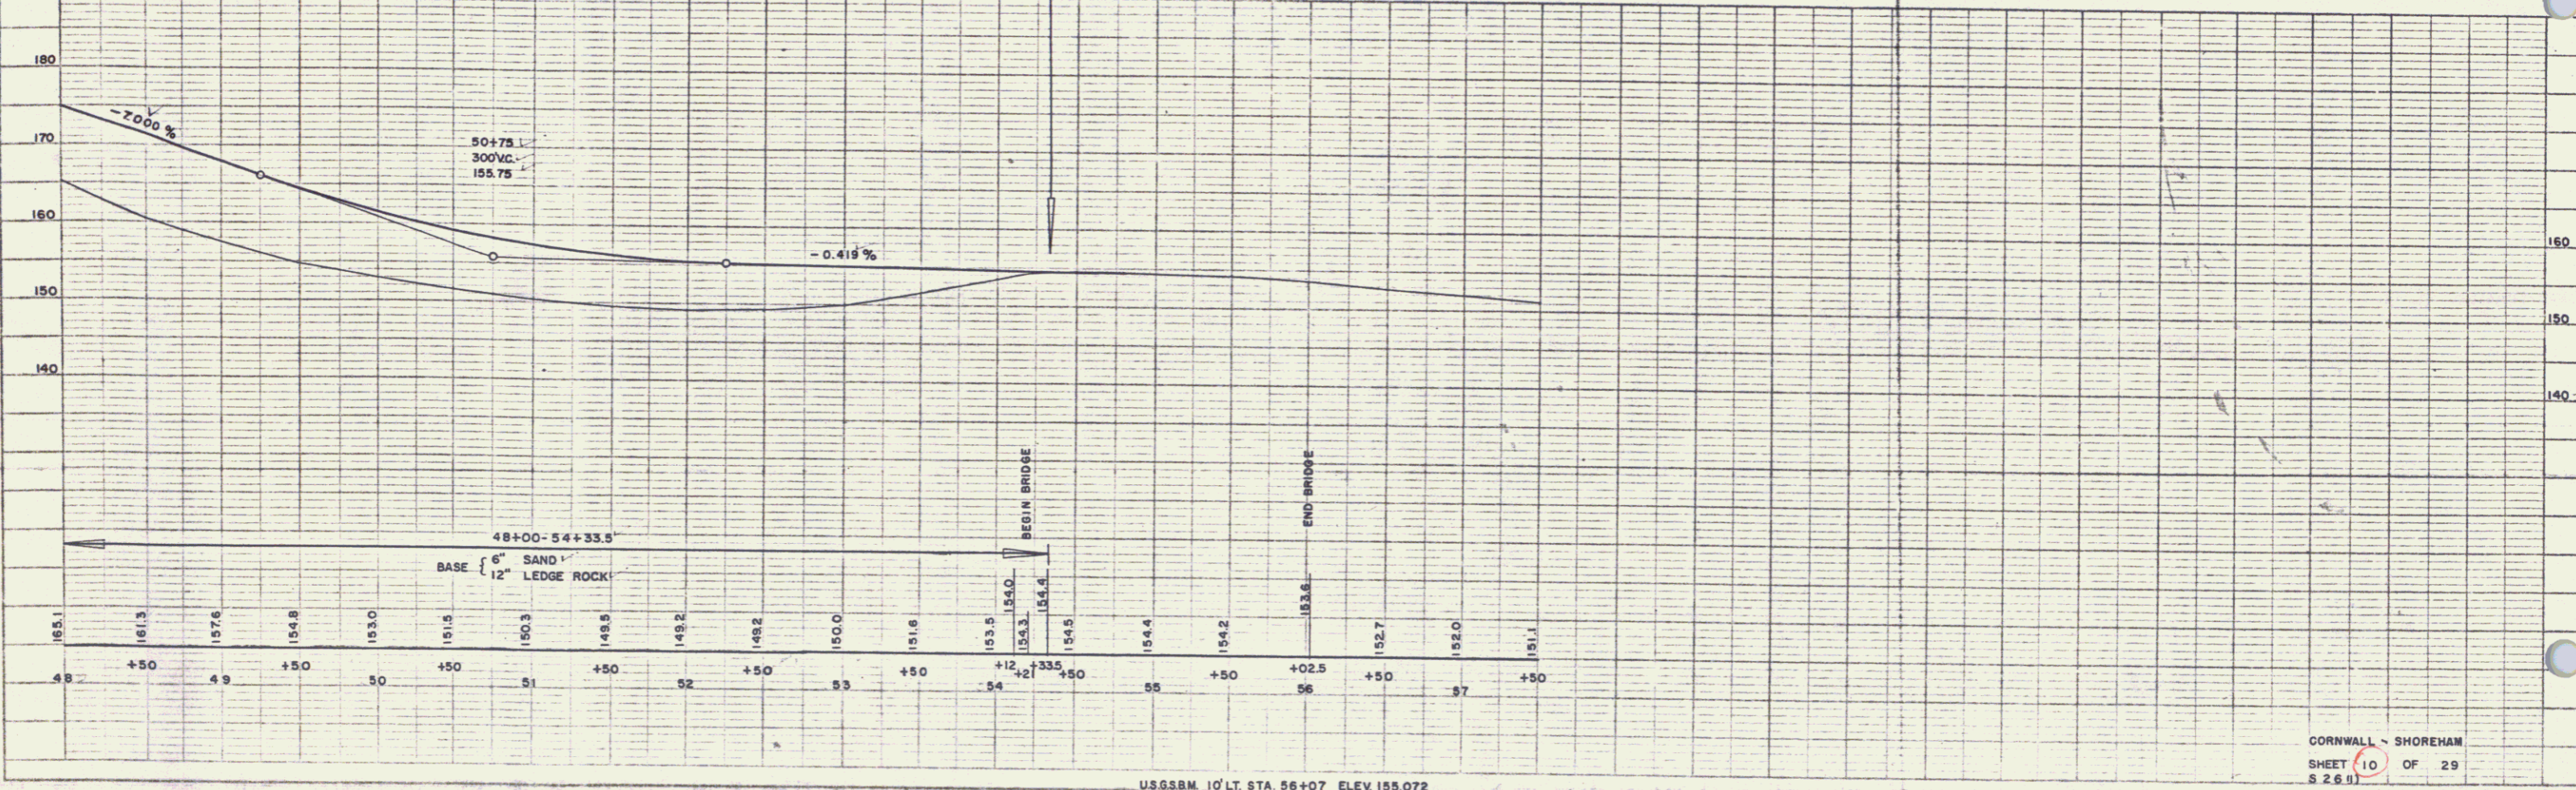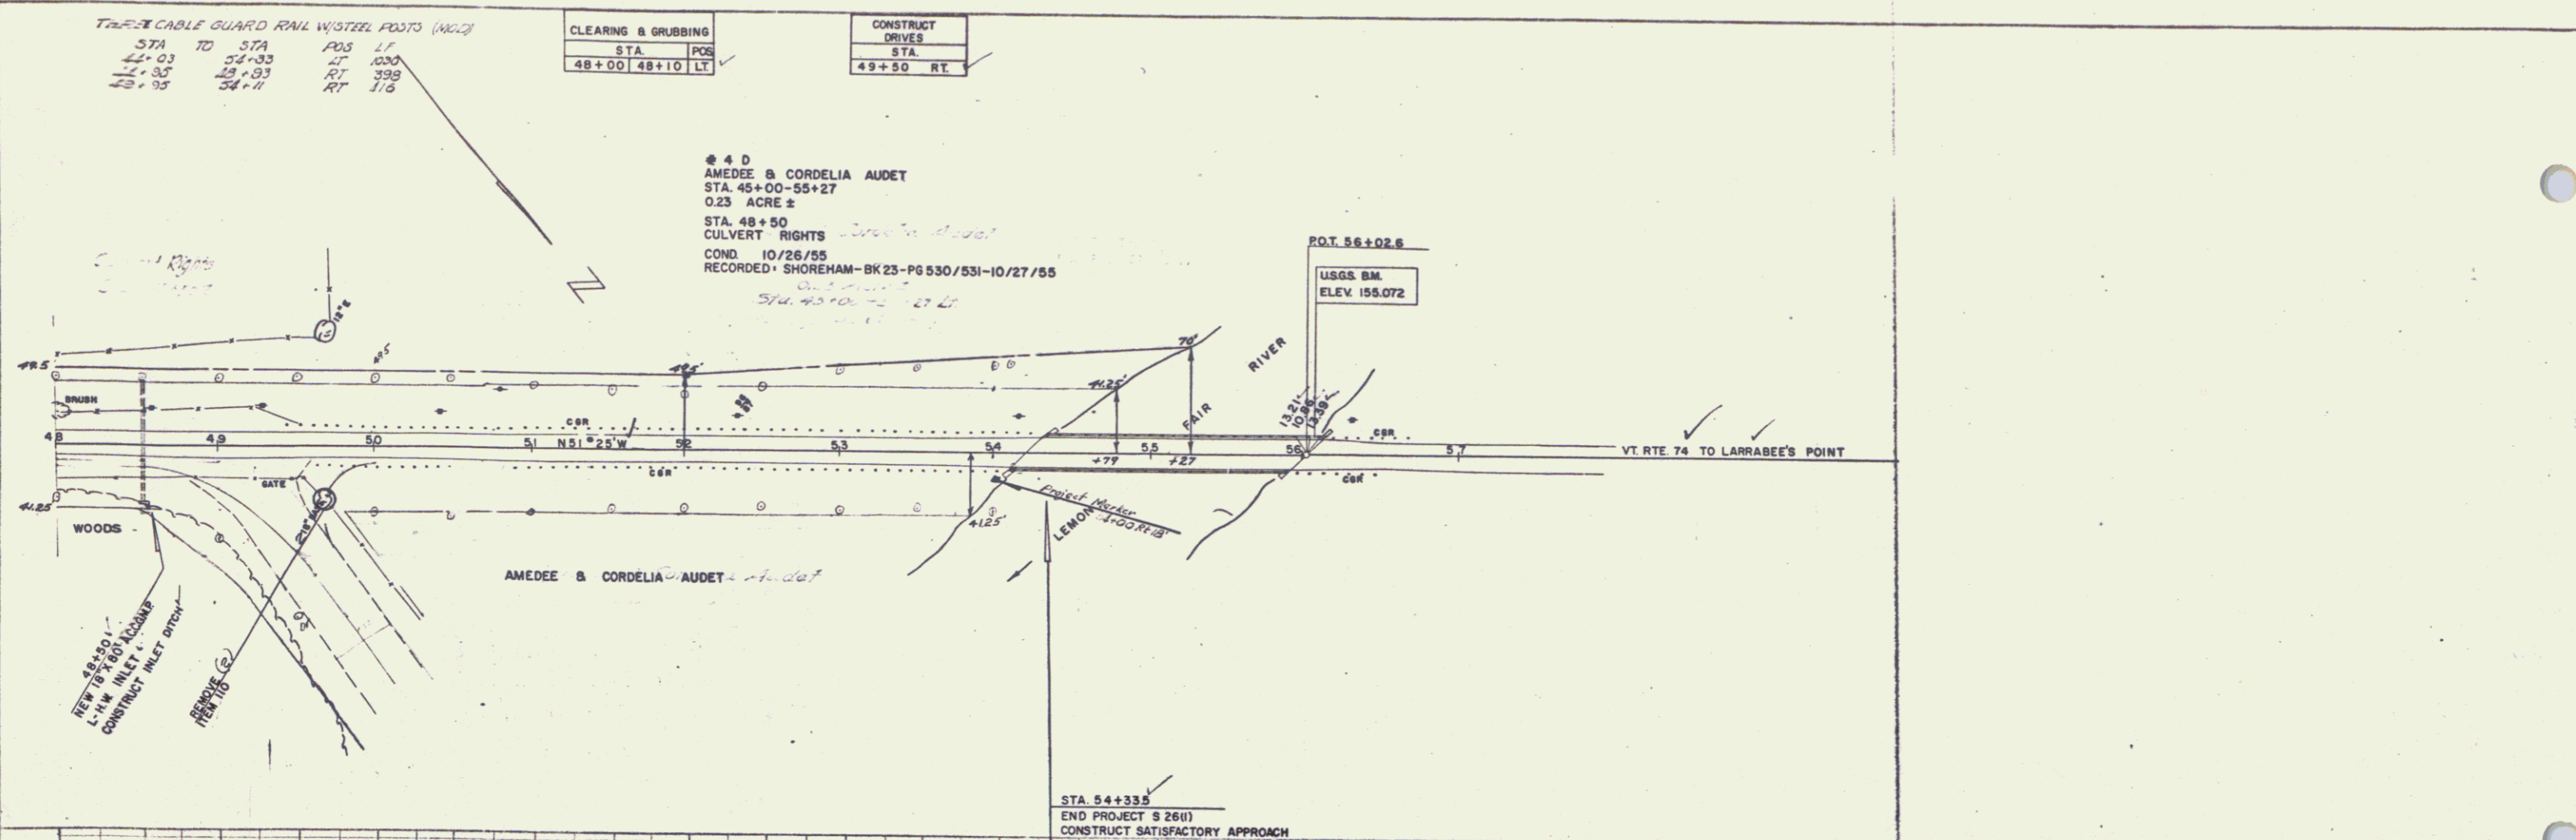

USGS BM 10' LT. STA. 56+07 ELEV. 155.072

5