


PARCEL	INSTRUMENT	DATE	GRANTOR	GRANTEE	RECORDED	REMARKS
A-B	W.D.	6-25-36	A. S. HILLIKER	SR. OF VT.	ALBANY BOOK PAGE DATE 29 490-31 6-29-36	

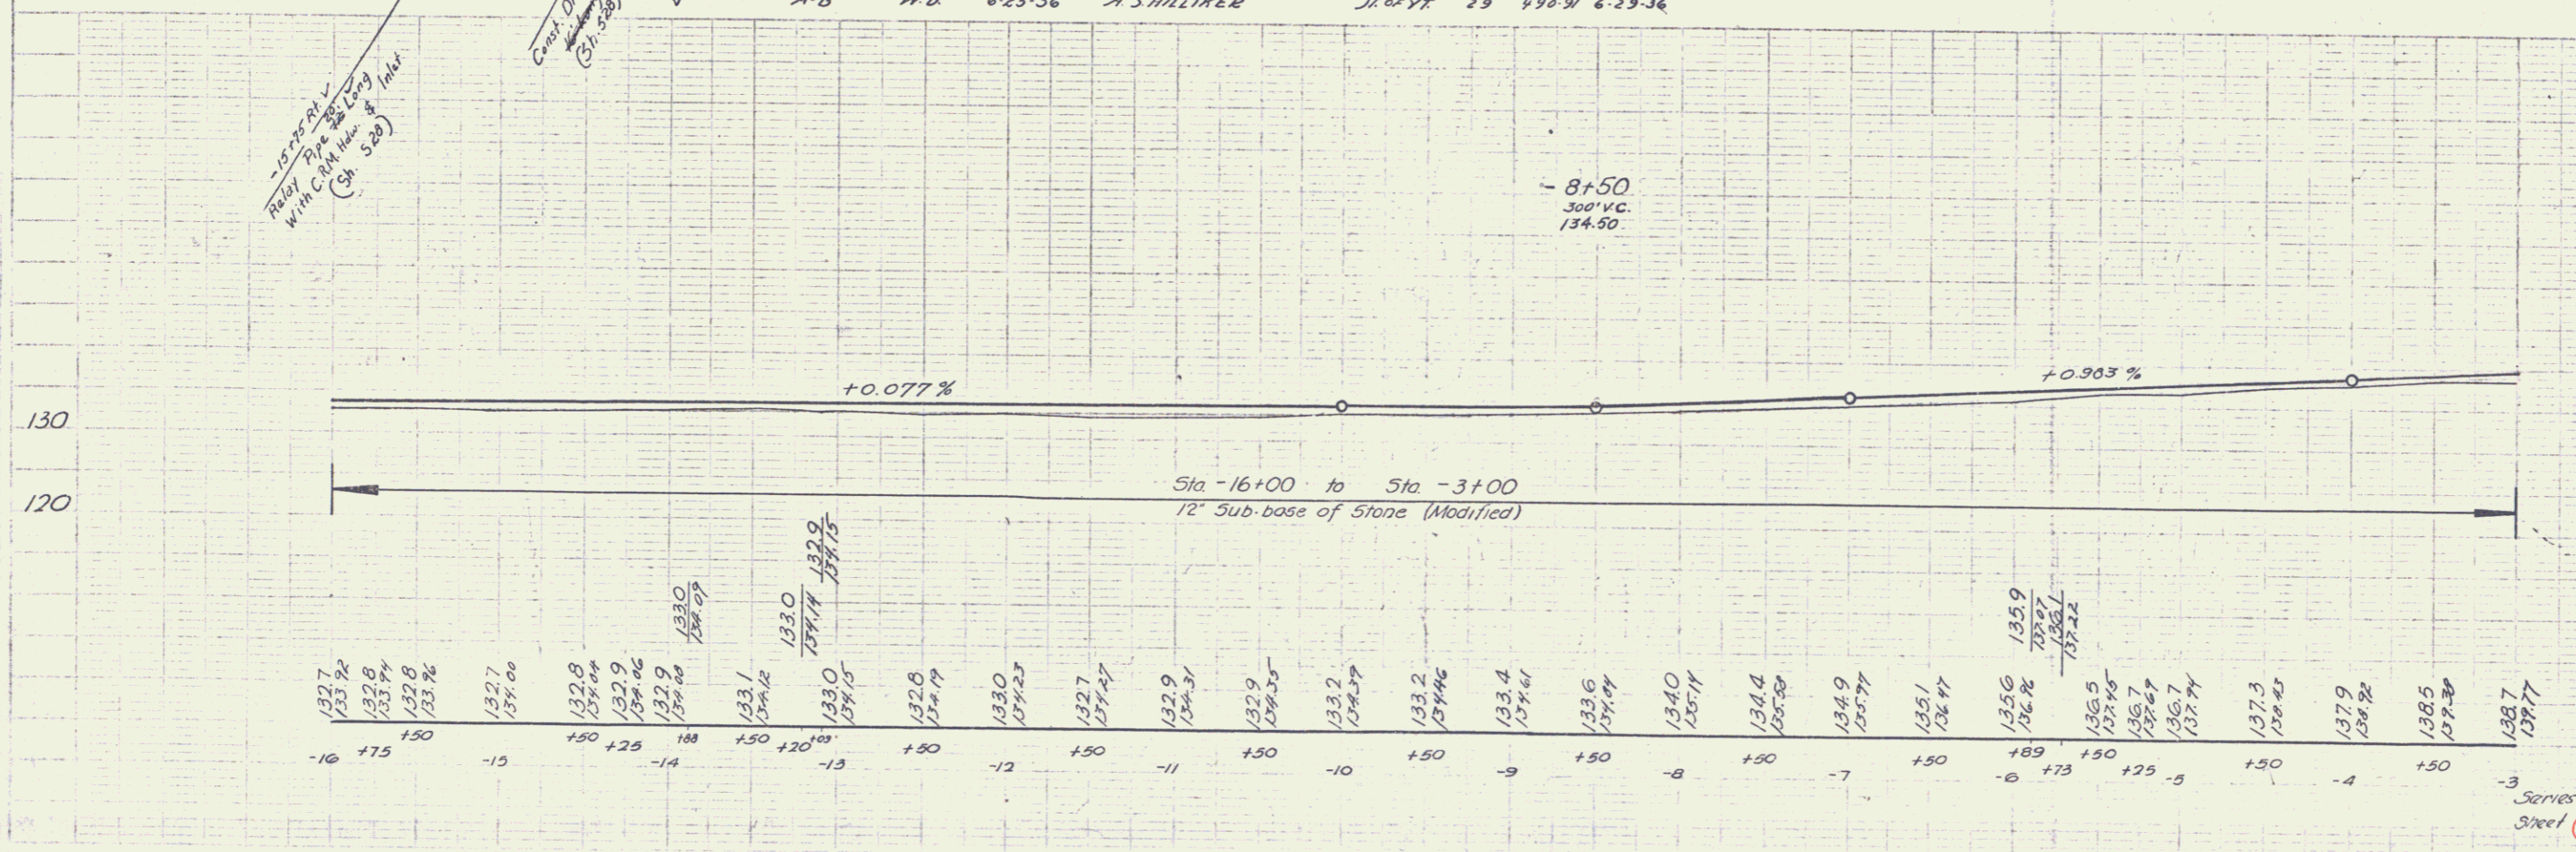

Station	Elevation
-16	137.7
-15	133.92
-14	133.9
-13	133.0
-12	133.0
-11	132.9
-10	133.2
-9	133.4
-8	134.0
-7	134.9
-6	135.6
-5	136.5
-4	137.3
-3	138.5
-2	138.7