


PARCEL	INSTRUMENT	DATE	GRANTOR	GRANTEE	RECORDED ALBURN	REMARKS
A-B	W.D.	6-9-37	Delia Boutah	St. of H.	BOOK 30 PAGE 243-6	6-12-37
A'	G.C.O.	6-9-37	A.S. Hilliker	"	BOOK 30 PAGE 237-8	6-12-37

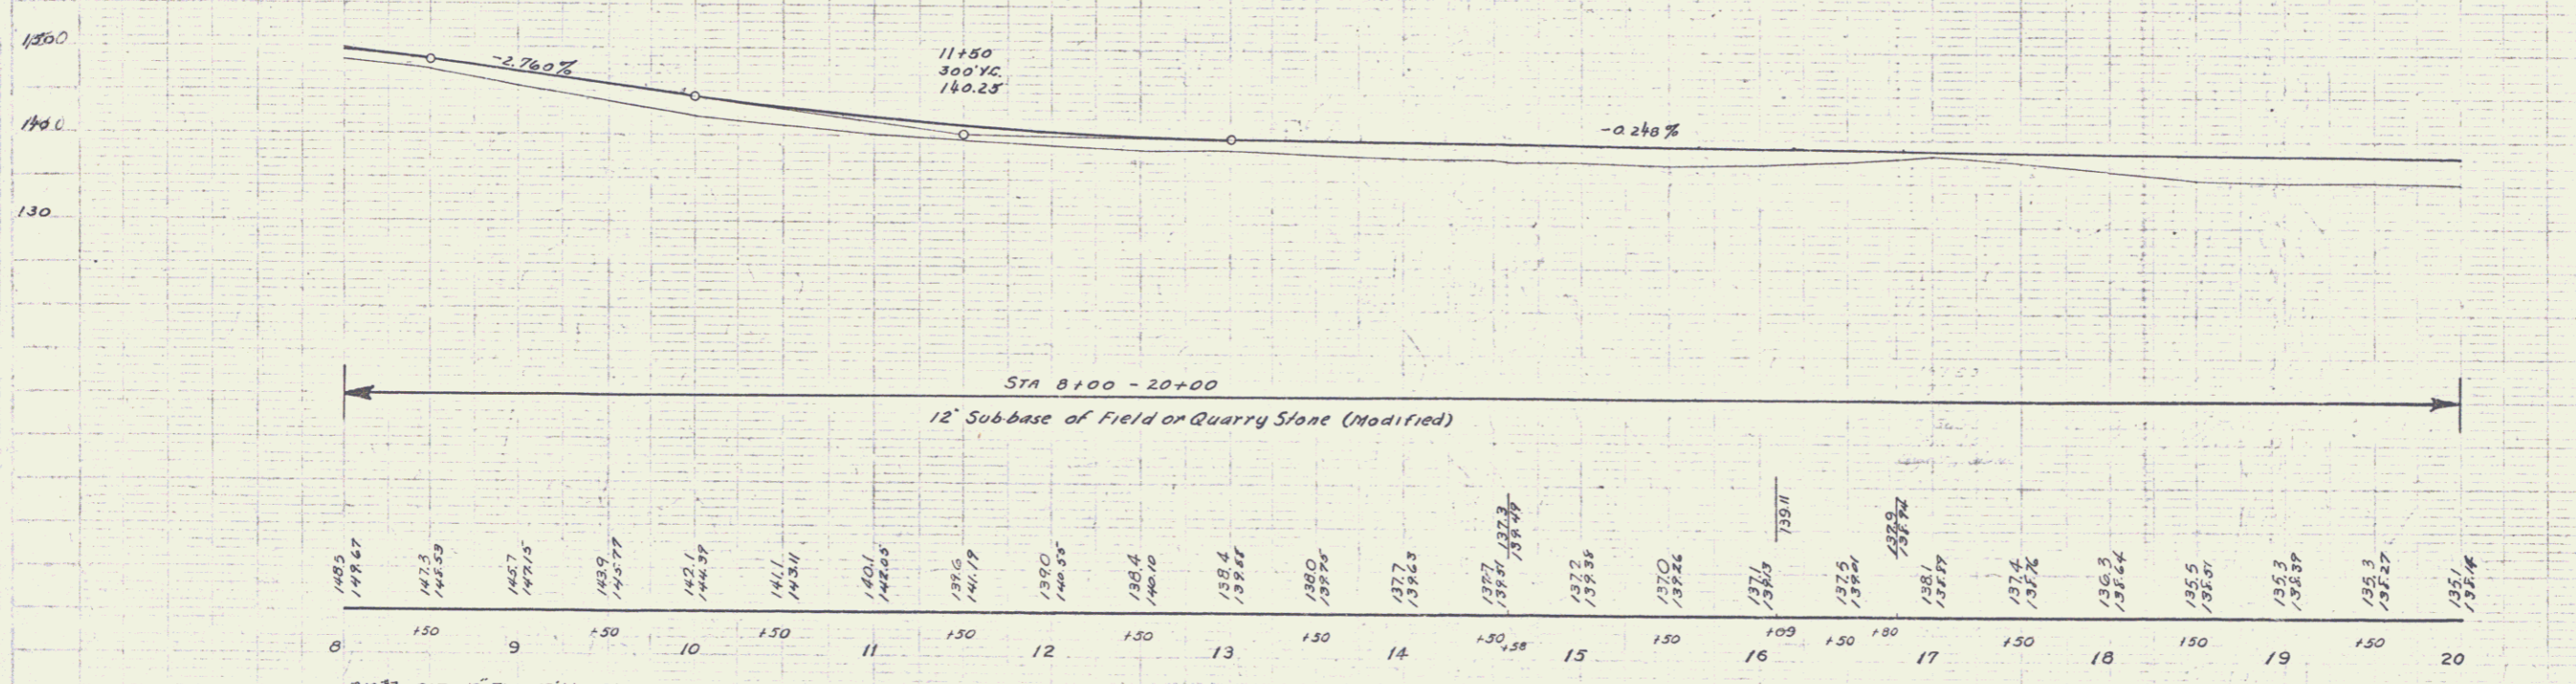

B.M. 3 51R 18' Elm 32' Lt Sta 16+06 Elev 13704