


PARCEL	INSTRUMENT	DATE	GRANTOR	GRANTEE	RECORDED ALBURS	REMARKS
A	G.C.O.	6-9-37	MARY A. CRELLER	STOFFY	BOOK 30 PAGE 27-3	6-2-37
B	WD	6-24-41	MISSISSOQUI BAY BRIDGE COM'N ST. OF VT.		32 67	6-27-41 Purchased by Bridge Com'n from Mary A. Creller, Q.C.D.

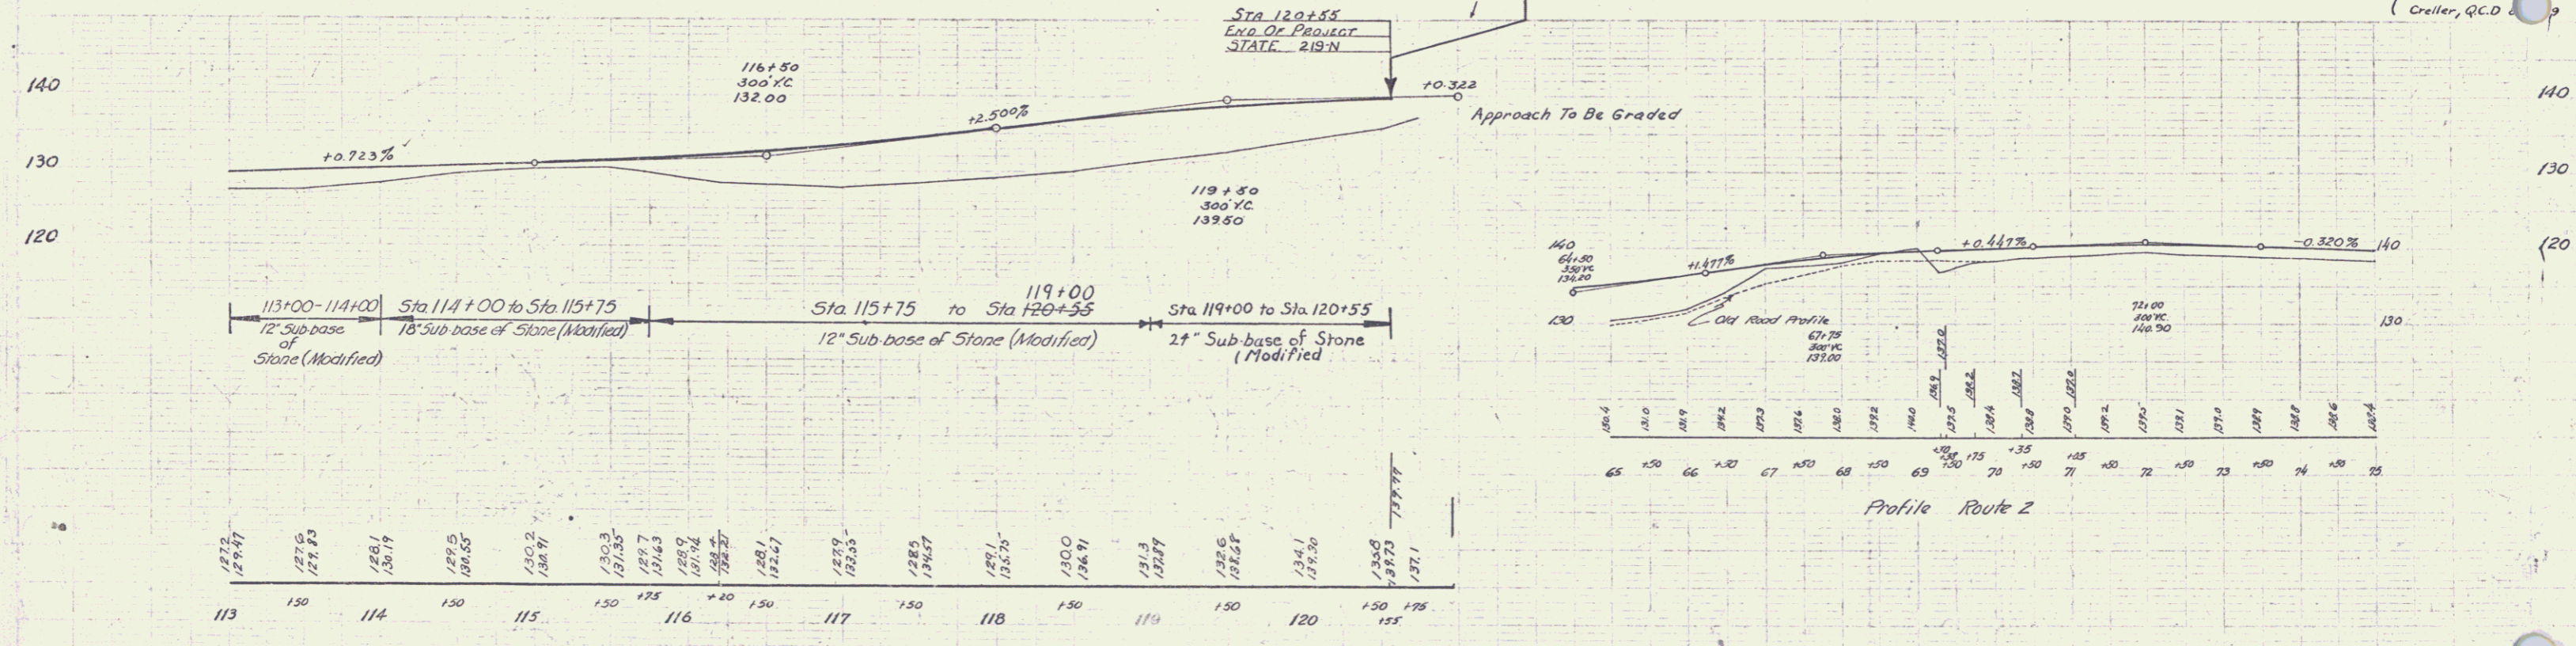

BM # 11 Spike In Roof 30' Maple 30.0' Rt. Sta. 121+0 Elev. 139.51

Series St. No. 219-N
Sheet 15 of 59 Sheets