



STATE  
2/19/1937 4 95

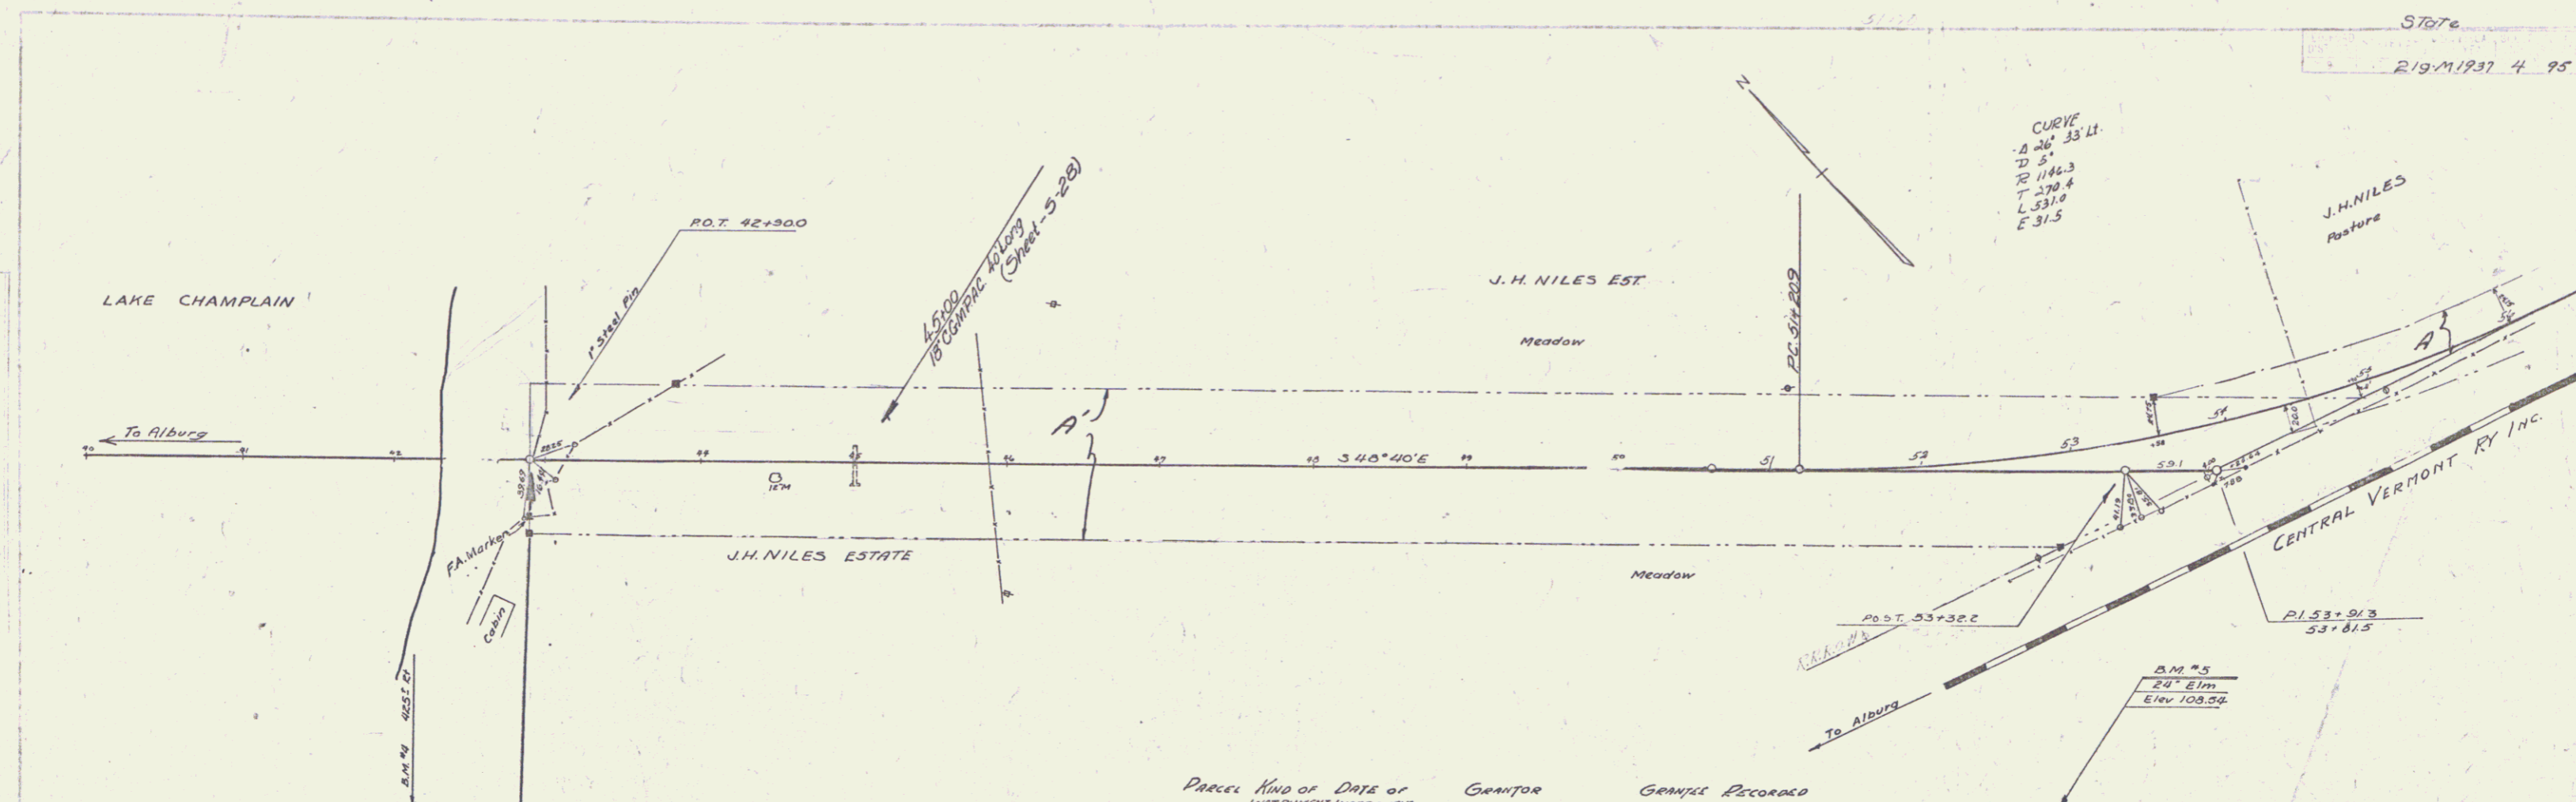

Parcel	Kind of Instrument	Date of Instrument	Grantor	Grantee	Recorded
A	W.D.	11-14-36	J.H. NILES ESTATE	STORIT	57 423 11-25-36
A'	R.D.	5-29-36	" "	" "	53 43 6-18-36

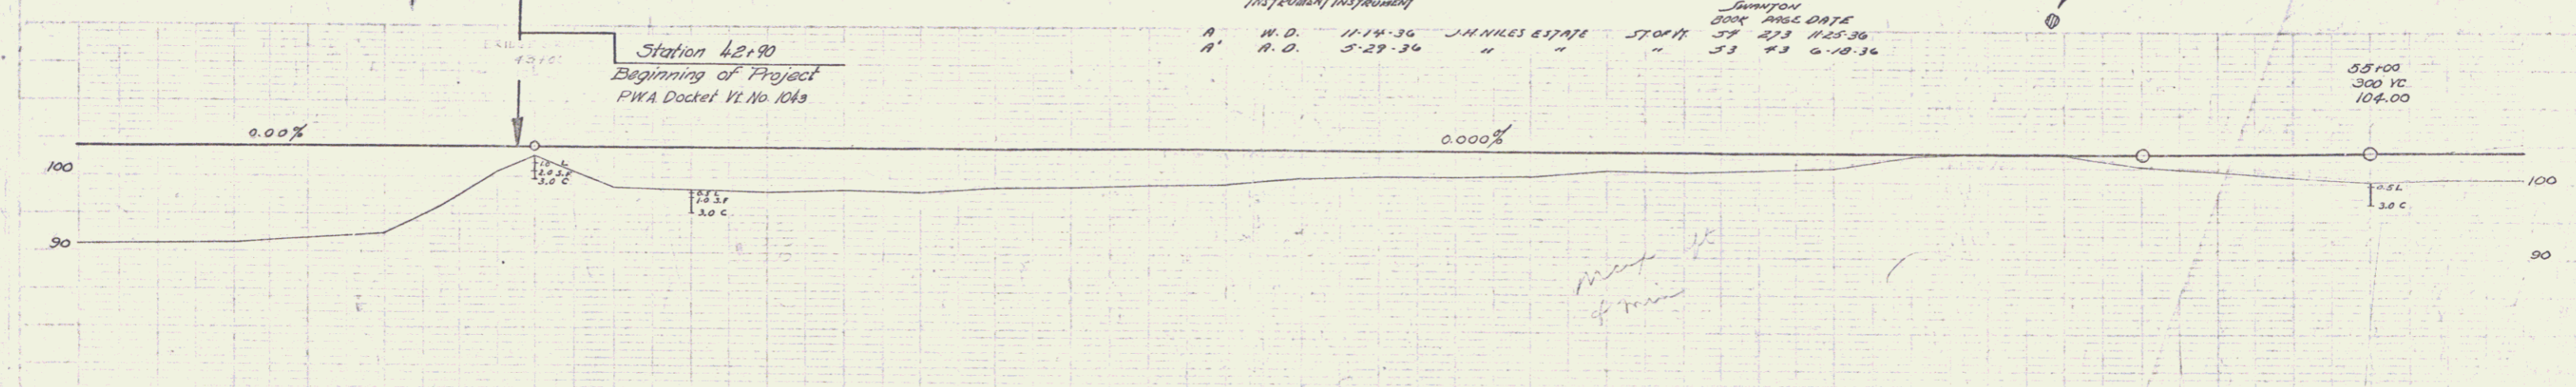

Sta 42+90 to Sta 56+00  
12" Sub-base Stone (Modified)

Station	Elevation
40	90.9
41	91.1
42	92.4
43	97.5
44	100.7
45	102.0
46	104.0
47	104.0
48	104.0
49	104.0
50	104.0
51	104.0
52	104.0
53	104.0
54	104.0
55	104.0
56	104.0

B.M. #4 U.S.G.S. P.B.M. D-1 1922 Bronze disc in 1'x1' conc. base 50' N.E. of Lottwood Station Elev. 105.649  
 B.M. #5 Spike in root of 24" Elm 250' E of Sta 52+42 Elev. 100.54

SERIES ST 102 19-M.  
SHEET 12 OF 95