


Parcel	Kind of	Date of	Grantor	Grantee	Recorded	Remarks
Ref.	Instrument	Instrument			Instrument	
24	W.D.	11-4-36	Etta B. Soule	Hoff	54 270 11-10-36	Cal Sta. 104+53 114+50 114+50

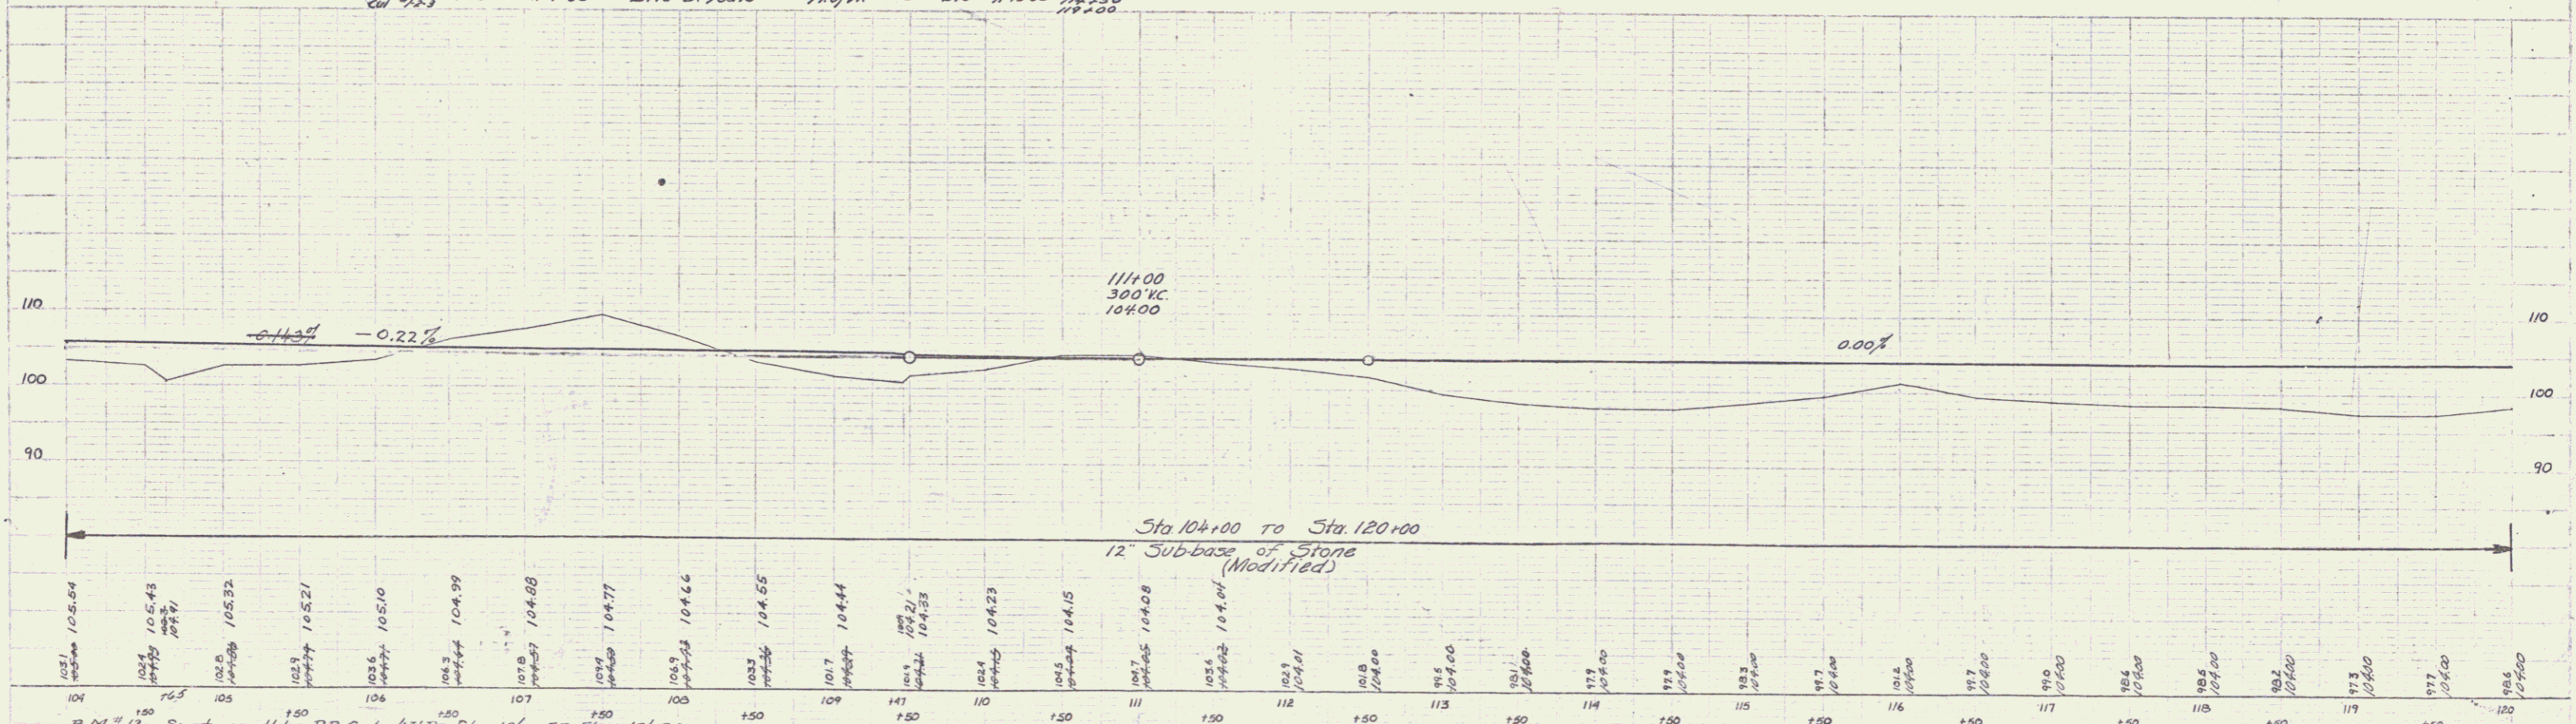

B.M. #12 Spot on Hwy. R.R. Curb 43' R. Sta. 104+53 Elev. 104.92  
 B.M. #13 Spk. in Trunk 10' Pop 24' L. Sta. 111+85 Elev. 103.38