


Parcel	Kind of Instrument	Date of Instrument	Grantor	Grantee	Recorded Location	DATE
A	W.D.	11-4-36	ETTO C. SOULE	H. J. H.	BOOK 888	11-10-36
A'	Q.C.D.	11-6-36	DAVID DUVAL	..	SP 270	11-20-36

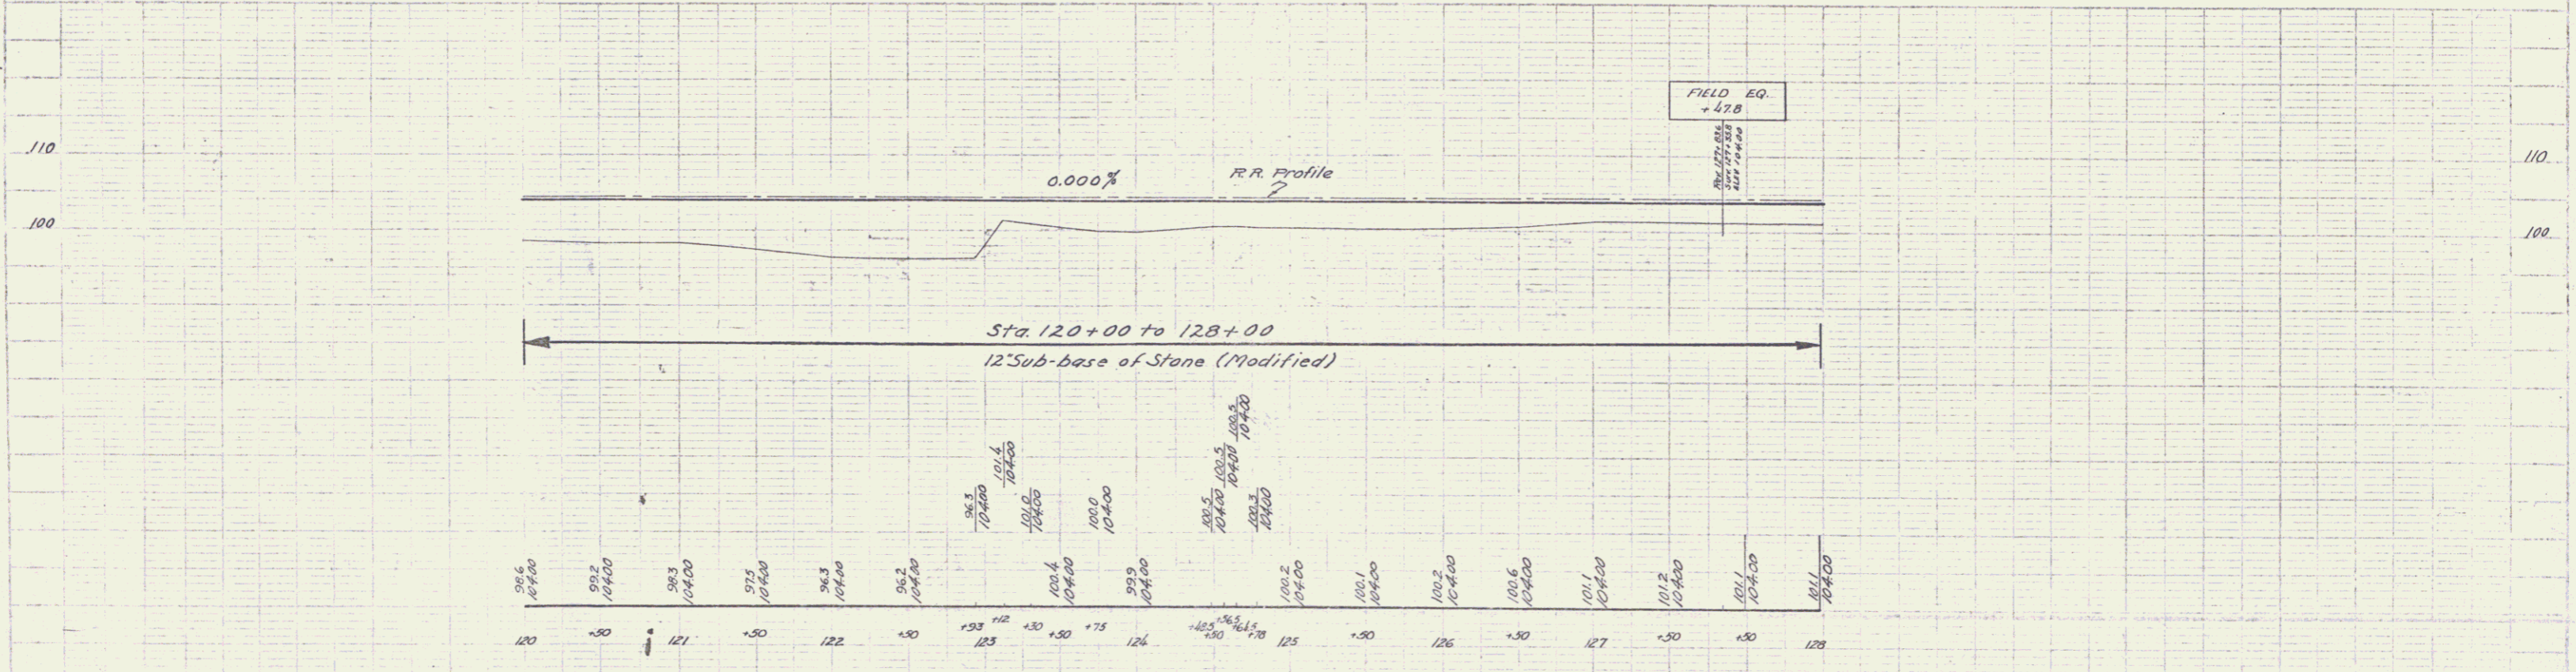

B.M. #14 Spot on Headwall 44' R.R. Sta. 124+44 Elev. 103.86