
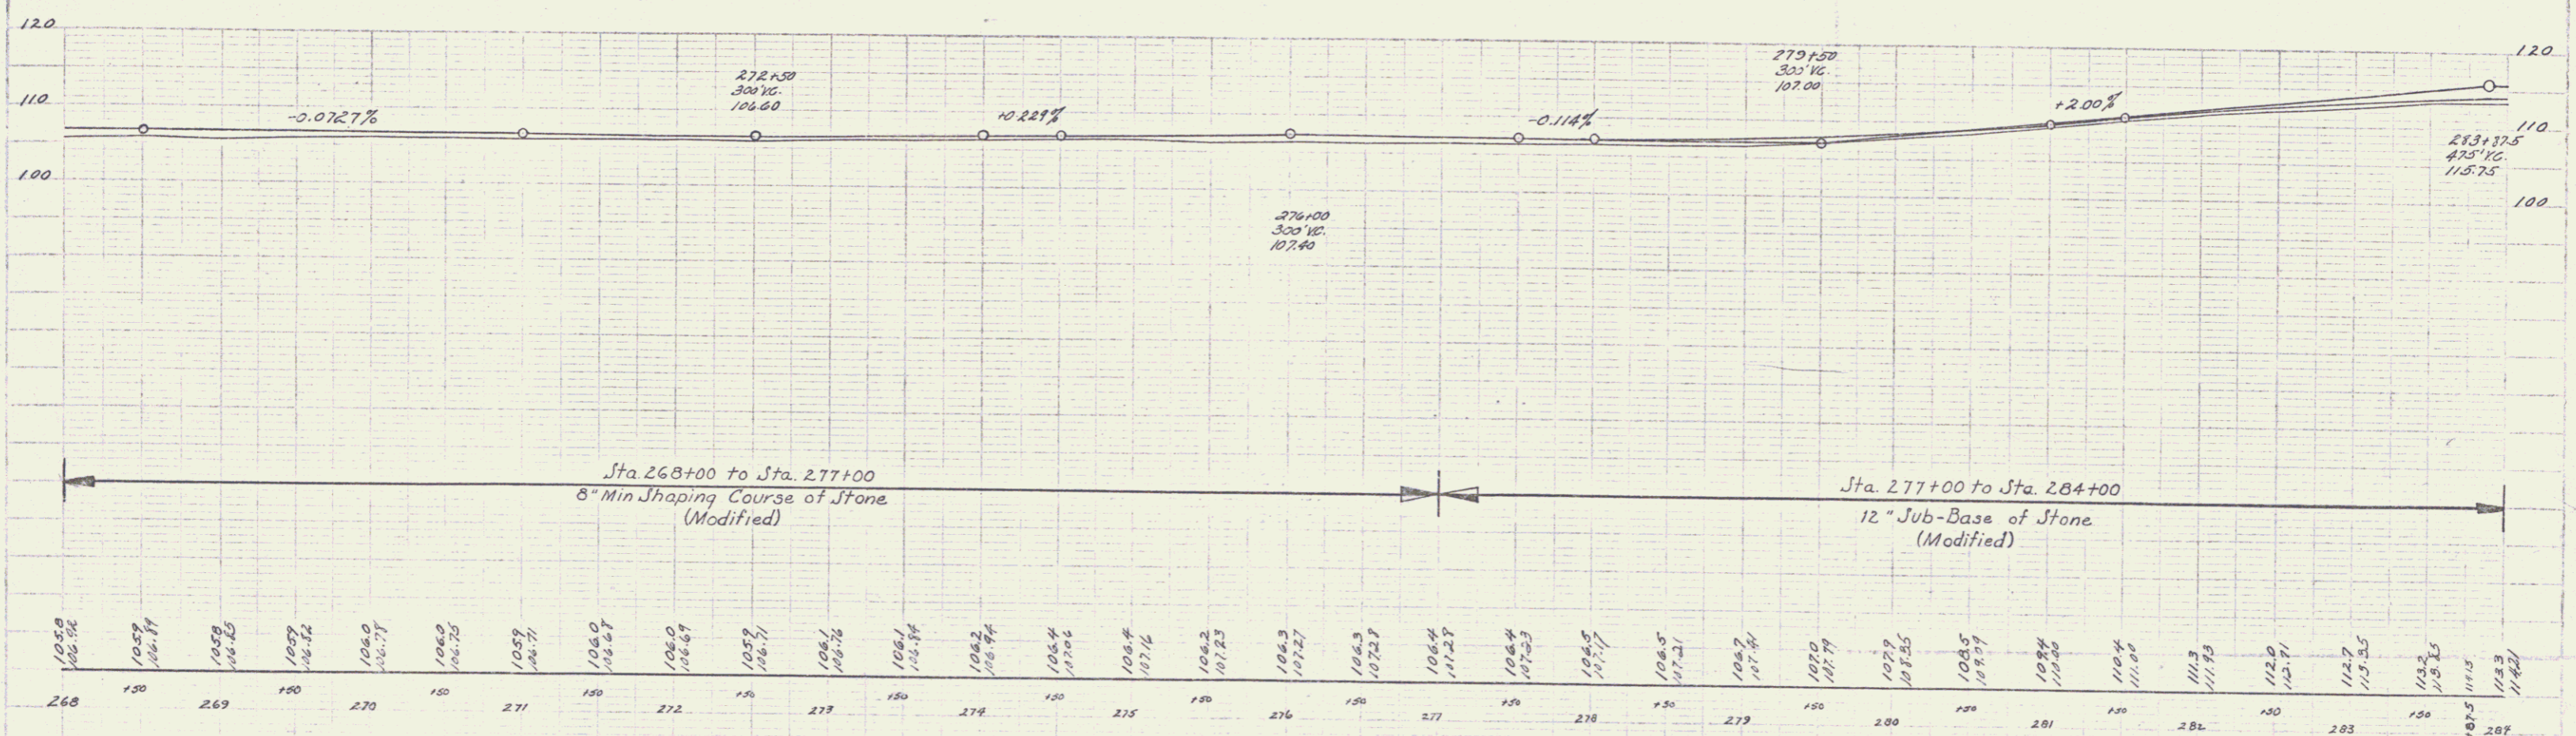


Parcel Kind of Part of Greater Greater Recorded  
 Instrument Instrument  
 2004 2005 0118  
 4-B-C R.C.D. 11-6-36 Mrs. Maud A. Young St. of H. 48 489 11-10-30

STATE NO. 219-M 1937 20 95

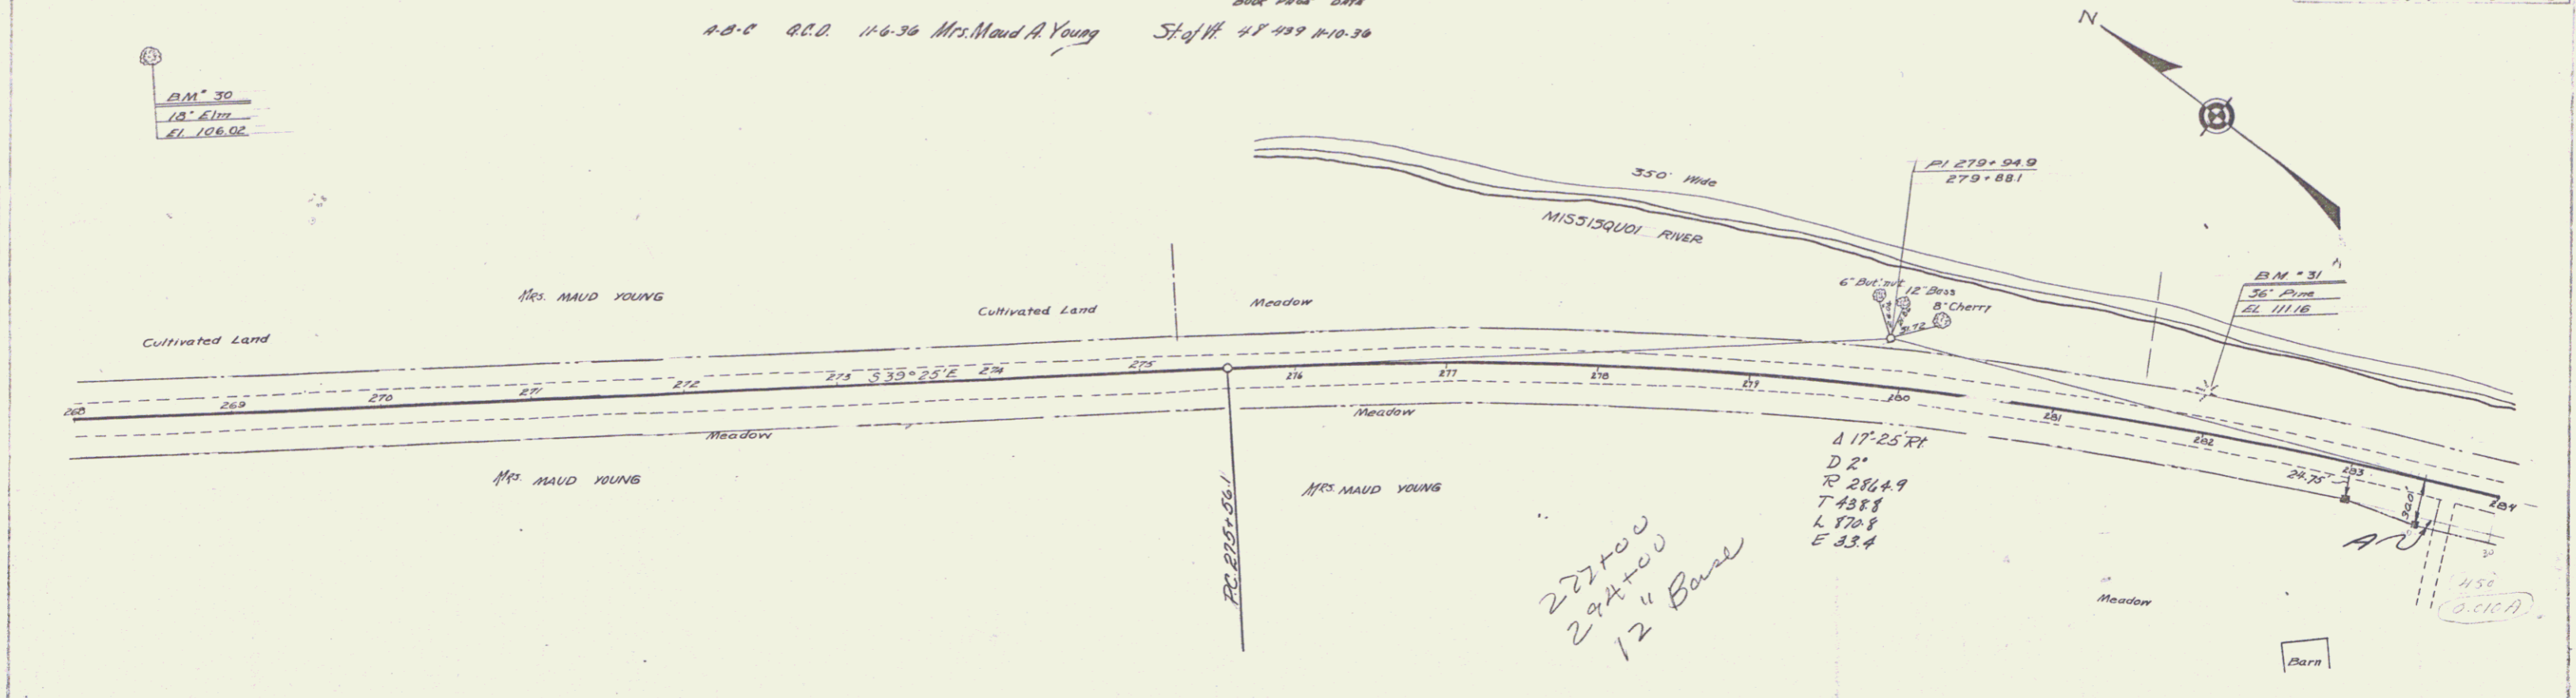

B.M. 30 SPIKE IN TRUNK OF 18' ELM 234' LT STA 268+63 EL 106.02  
 B.M. 31 ROOT - 36' PINE 265' LT STA 282+00 EL 111.16

SERIES STATE NO 219-M SHEET 20 OF 95

18