


Parcel Map of Date of Grantor Grant Recorded
 A-B-C Q.C.D. 11-6-36 Mrs. Maud A. Young Staff. 48 439 11.10.36
 A-B-C Q.C.D. 11.13.36 Horras Campbell " 48 443 11.20.36

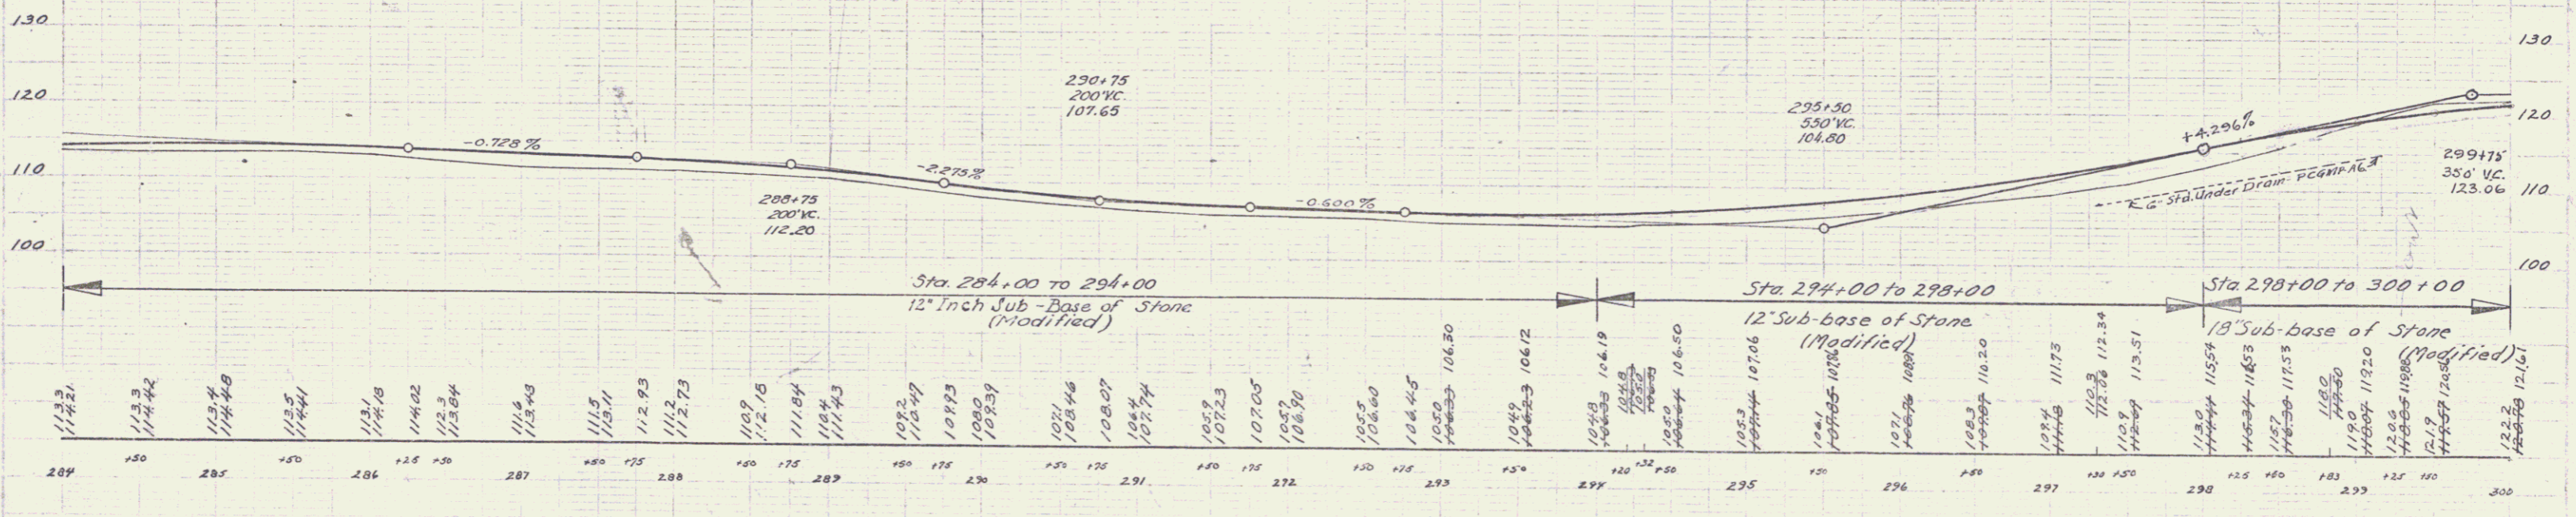

B.M. 32 SPIKE IN 36" PINE STUMP 33' LT OF STA. 292+54 EL. 108.82