
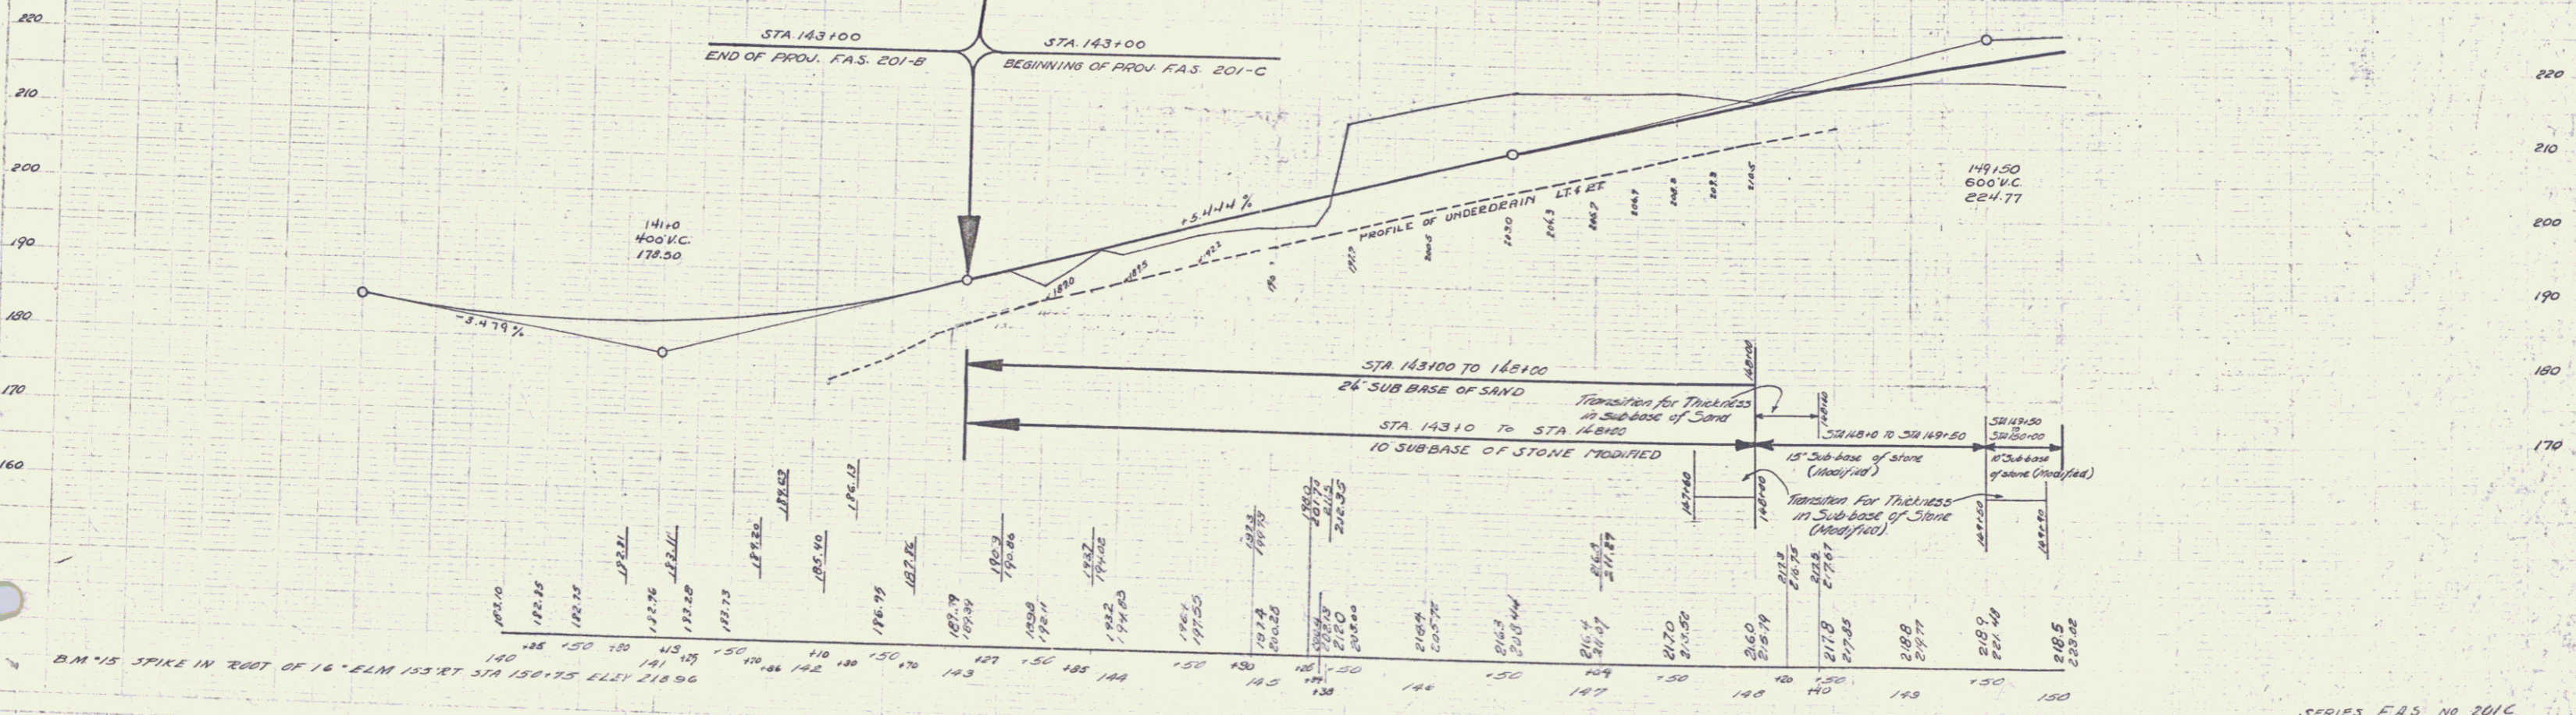


1. Name of Engineer
 2. Name of Client
 3. Name of Project
 4. Name of Road
 5. Name of Section
 6. Name of Sheet
 7. Name of Date
 8. Name of Scale
 9. Name of Drawing
 10. Name of Drawing

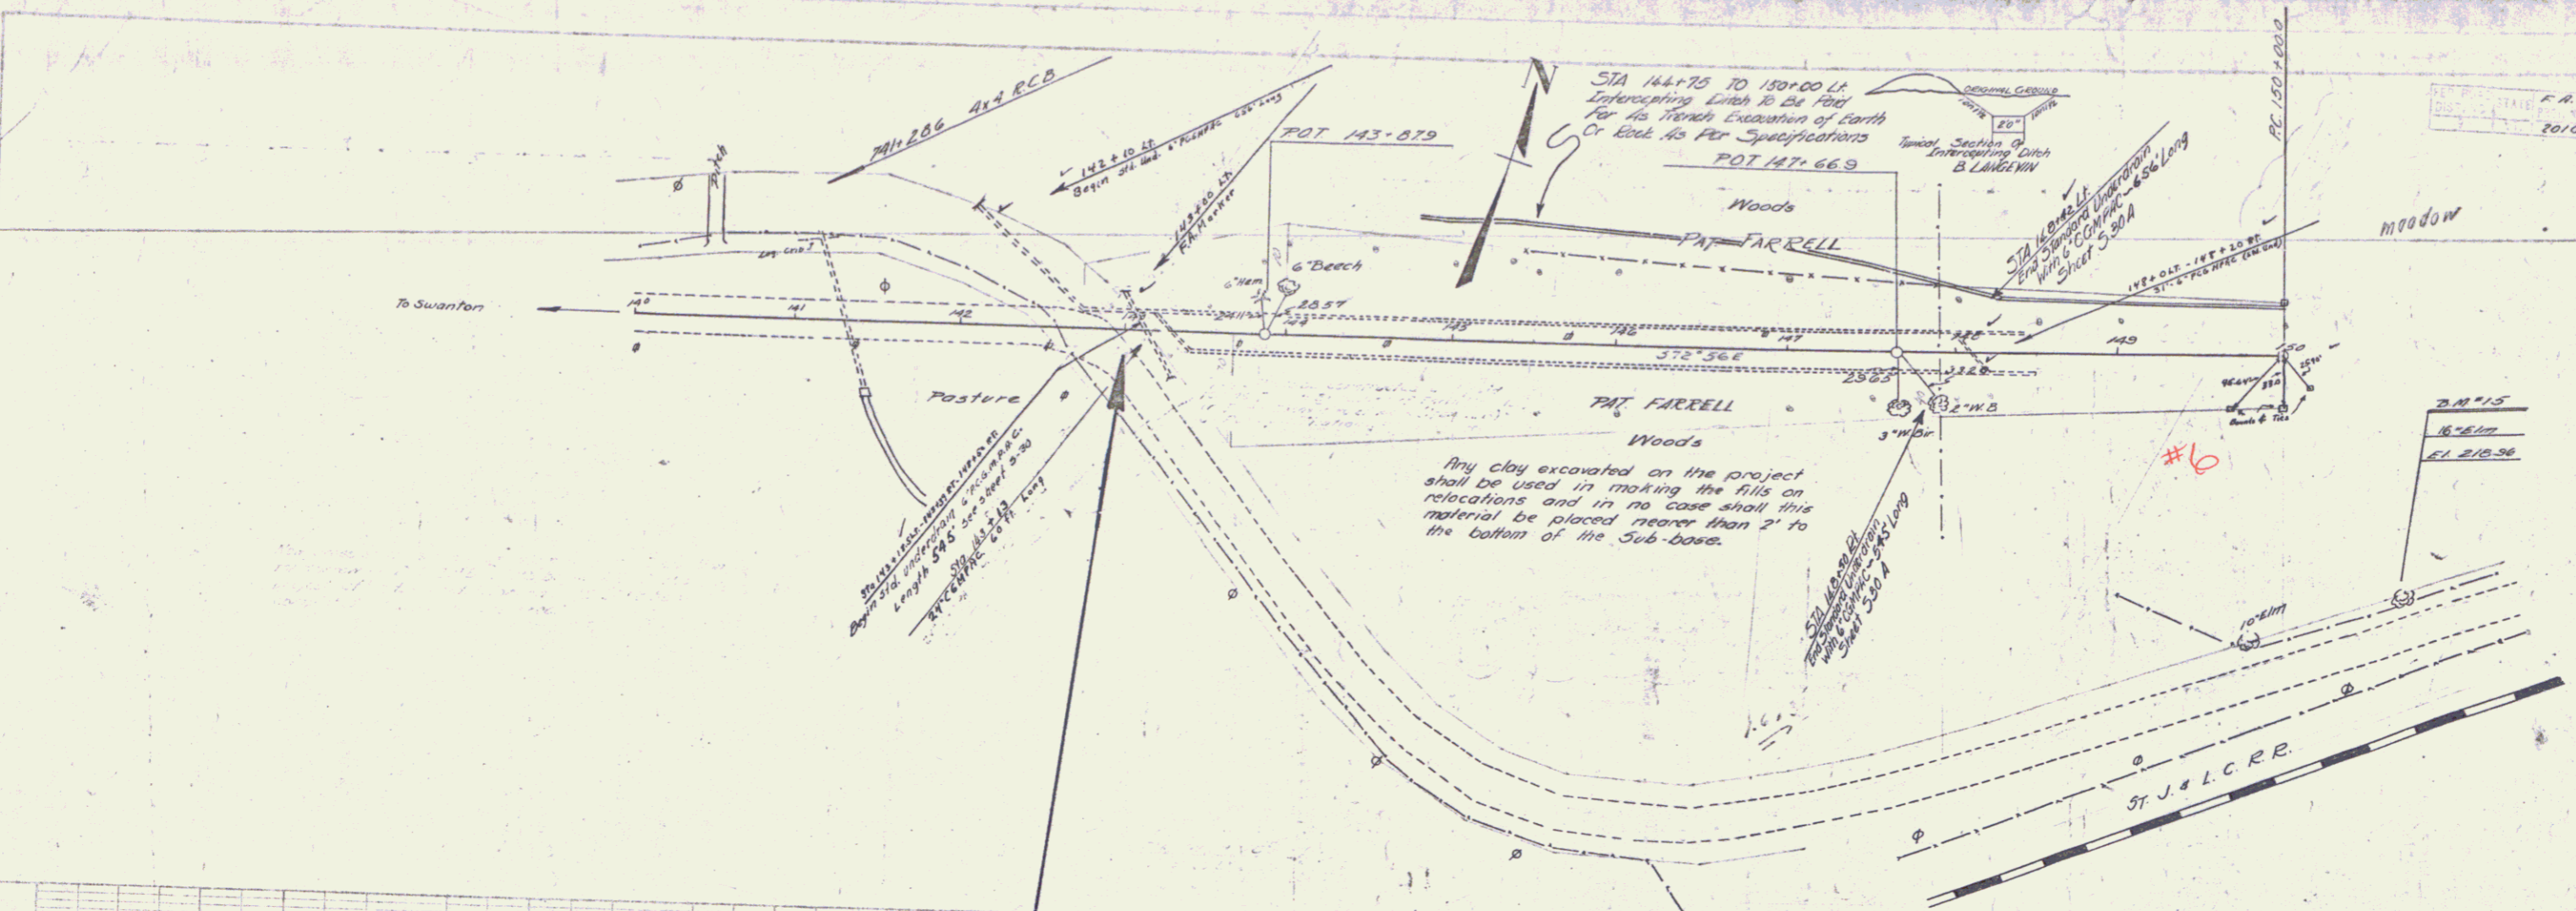

B.M. #15 SPIKE IN ROOT OF 16" ELM 155 FT STA 150+75 ELEV 218.96