


REG. NO.	STATE	FISCAL YEAR	SHEET NO.	TOTAL SHEETS
107355.70	PA	1957	7	20



Note:
 For Floor Foundation Material
 to be Removed See Cross Section
 Sheets 35 of 60, 36 of 60 & STA 60.

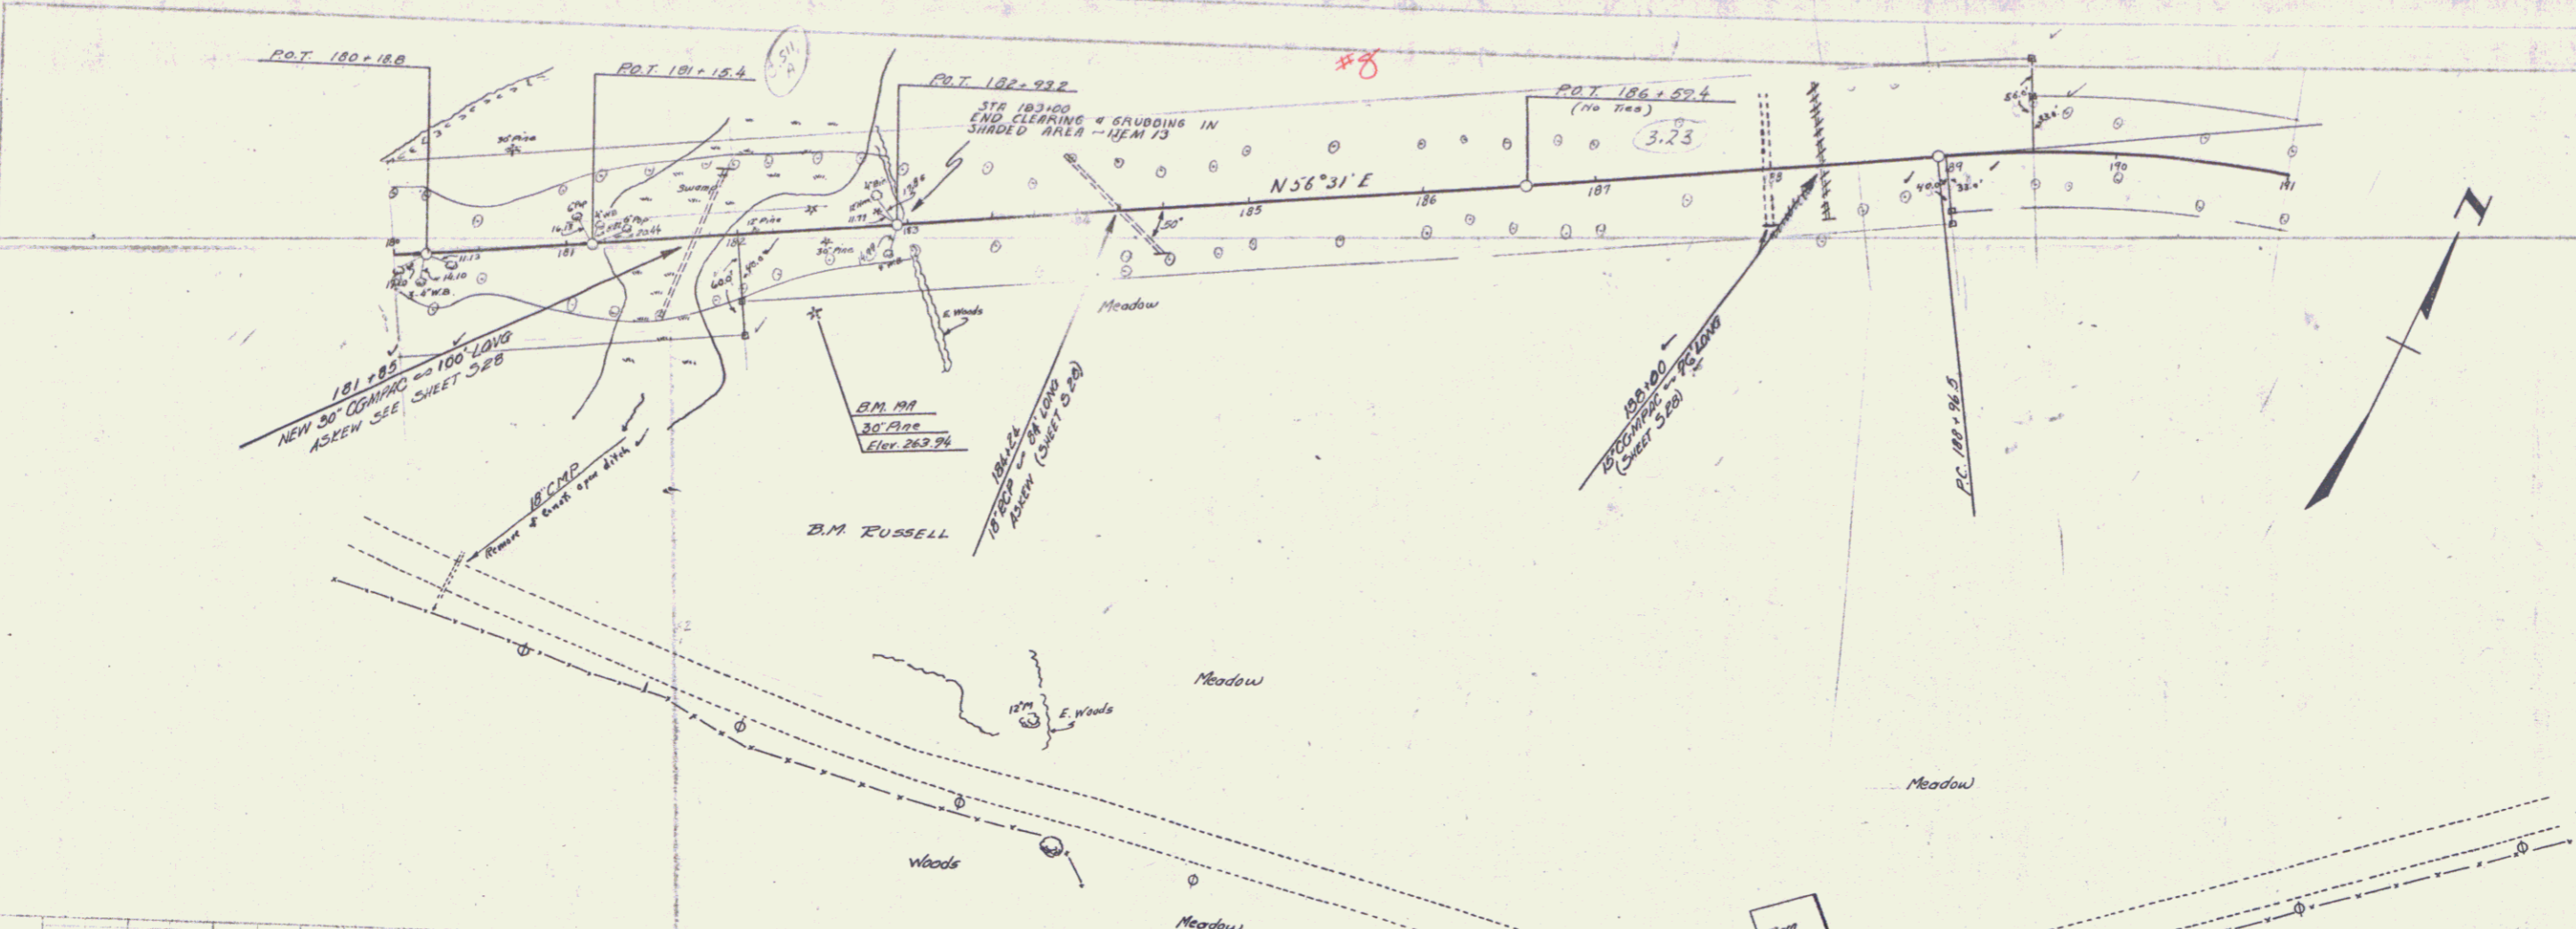