
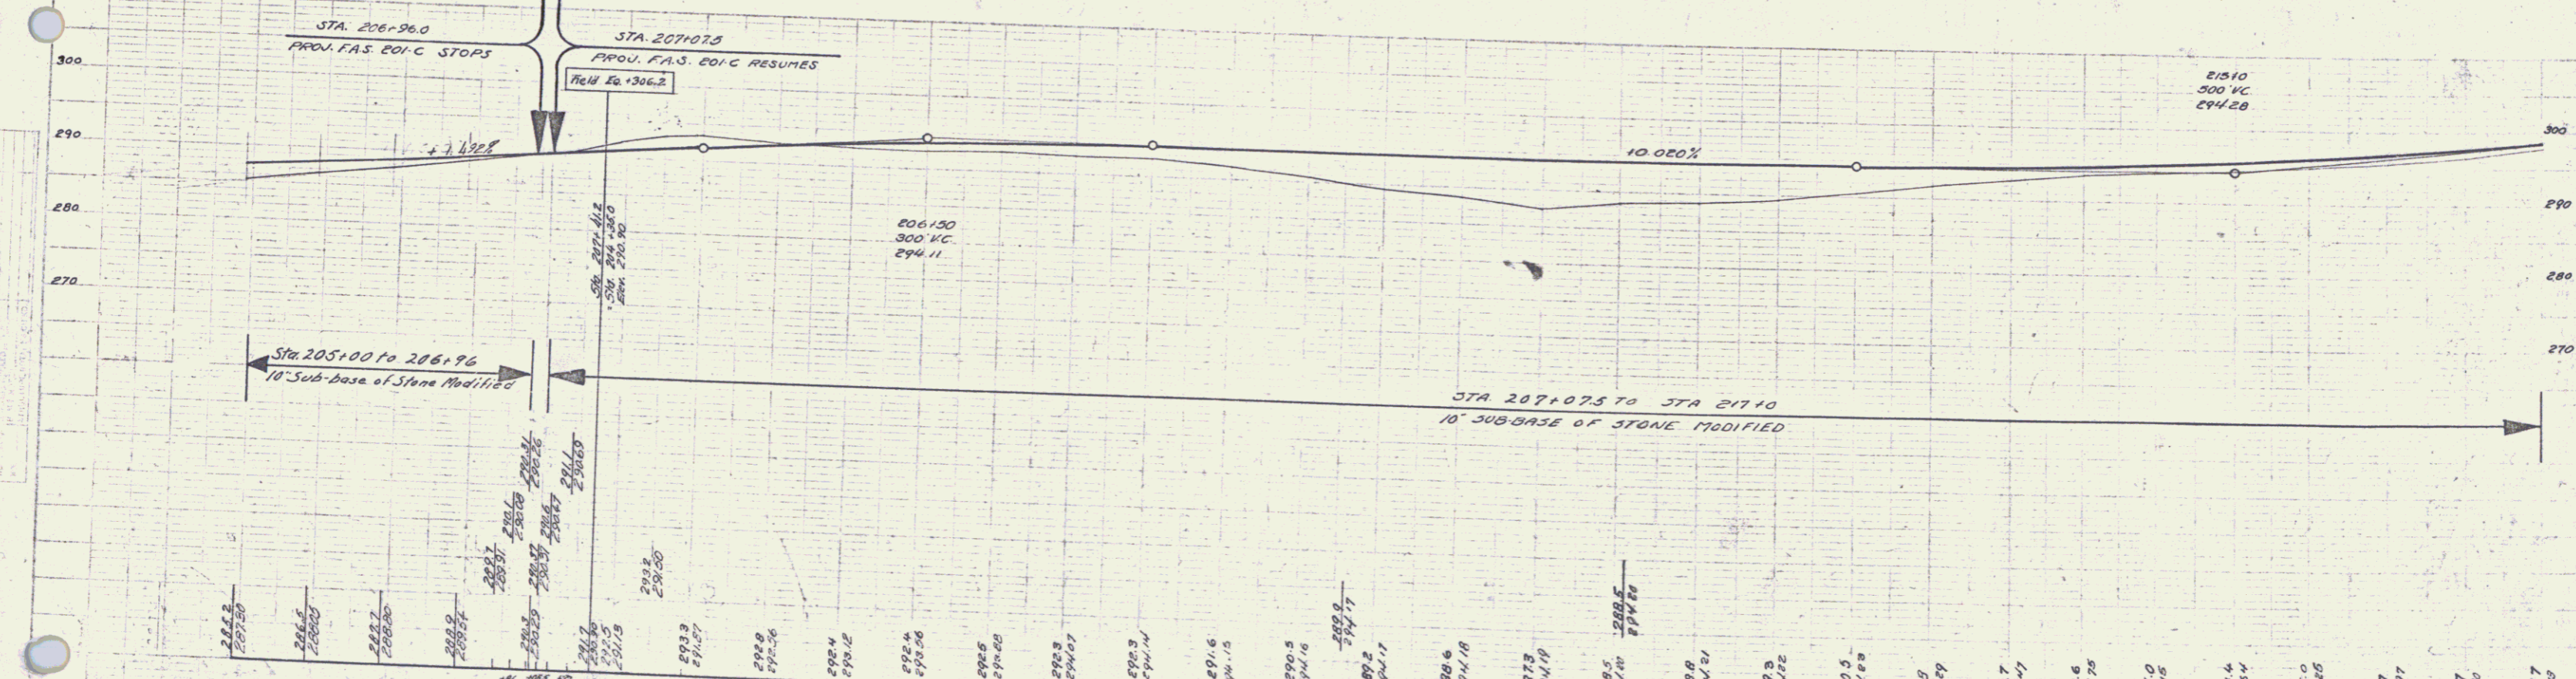


Δ 2'-21" LT.
 D 0'-30"
 T 144572
 L 235.0
 E 2.4

SERIES F.A.S. NO. 201C
 SHEET 9 OF 60

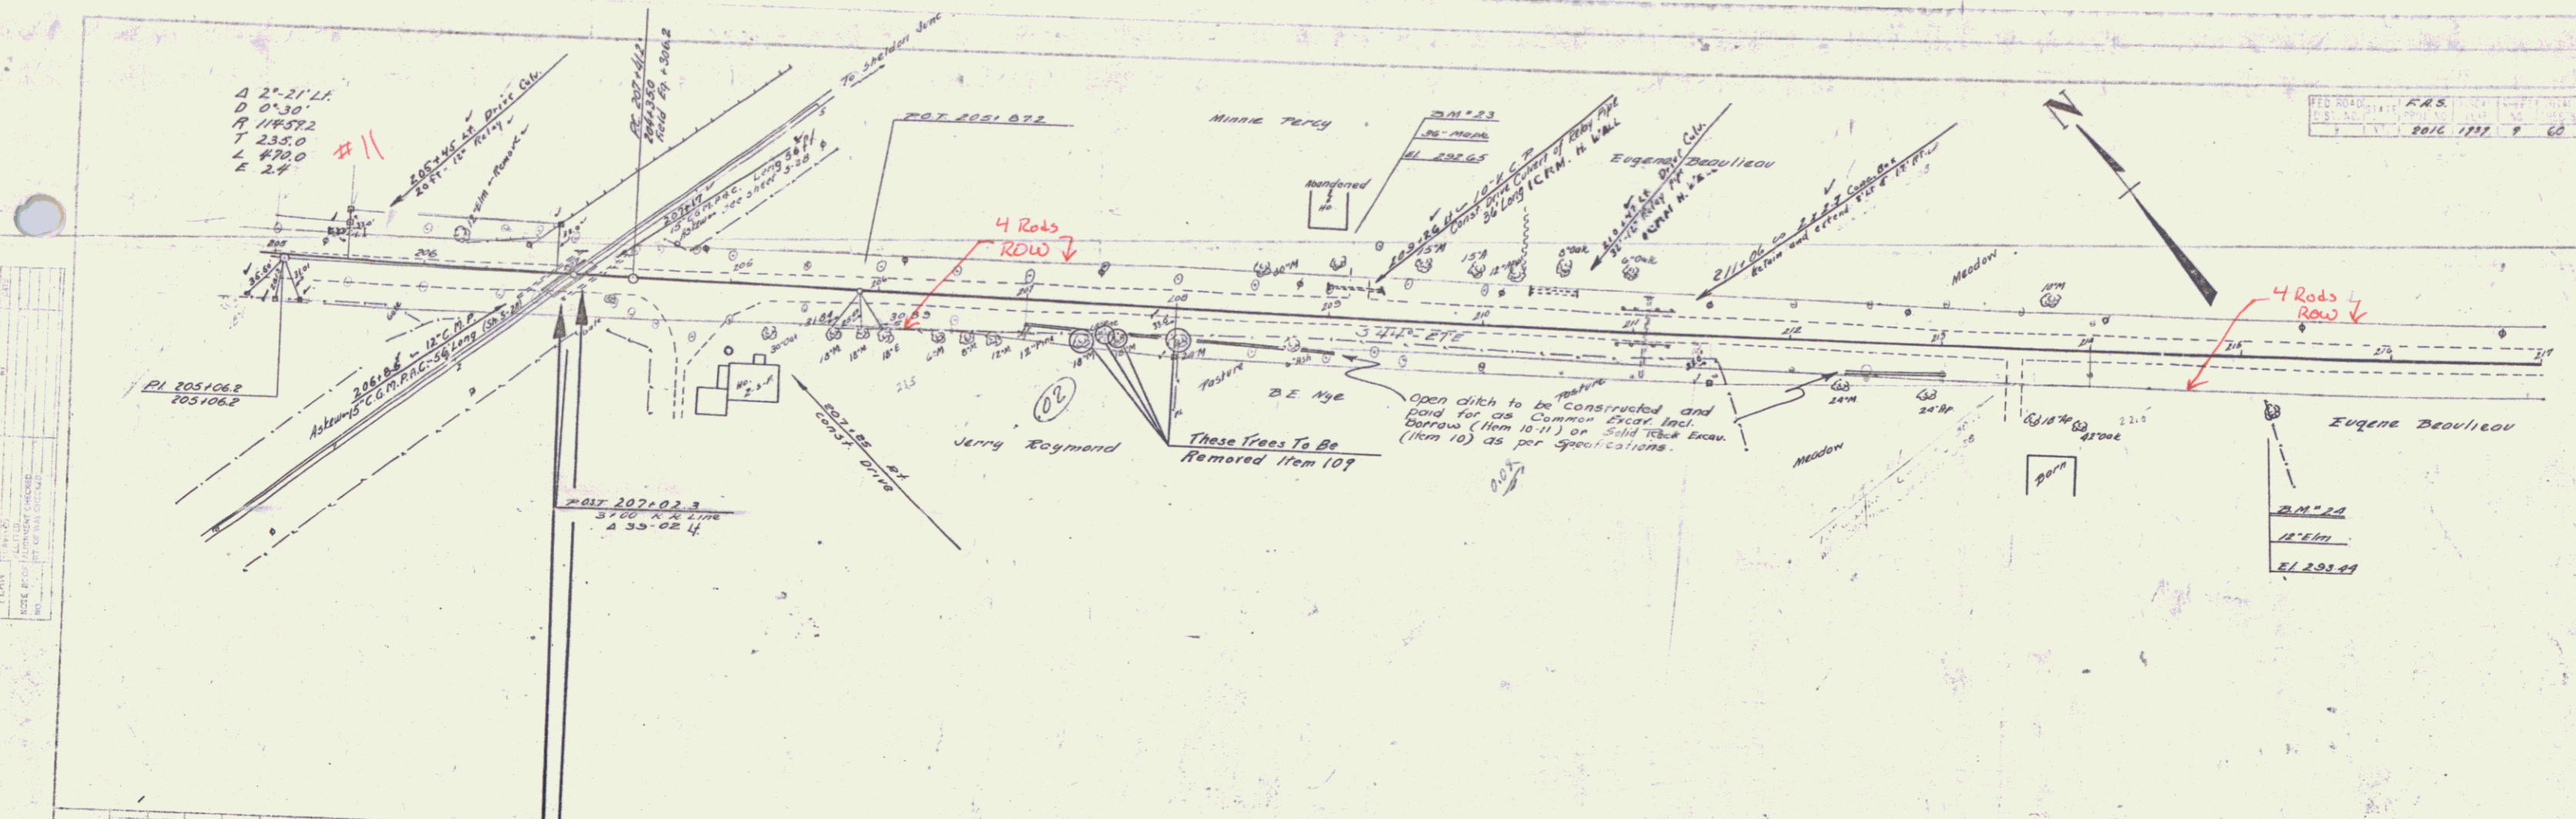

205	206	207	208	209	210	211	212	213	214	215	216	217
285.8	286.5	287.2	287.9	288.6	289.3	290.0	290.7	291.4	292.1	292.8	293.5	294.2
287.50	288.00	288.50	289.00	289.50	290.00	290.50	291.00	291.50	292.00	292.50	293.00	293.50

SERIES F.A.S. NO. 201C
 SHEET 9 OF 60