



POOR ORIGINAL COPY

PLAN	DATE
REVISED	
NOTED	
NO.	

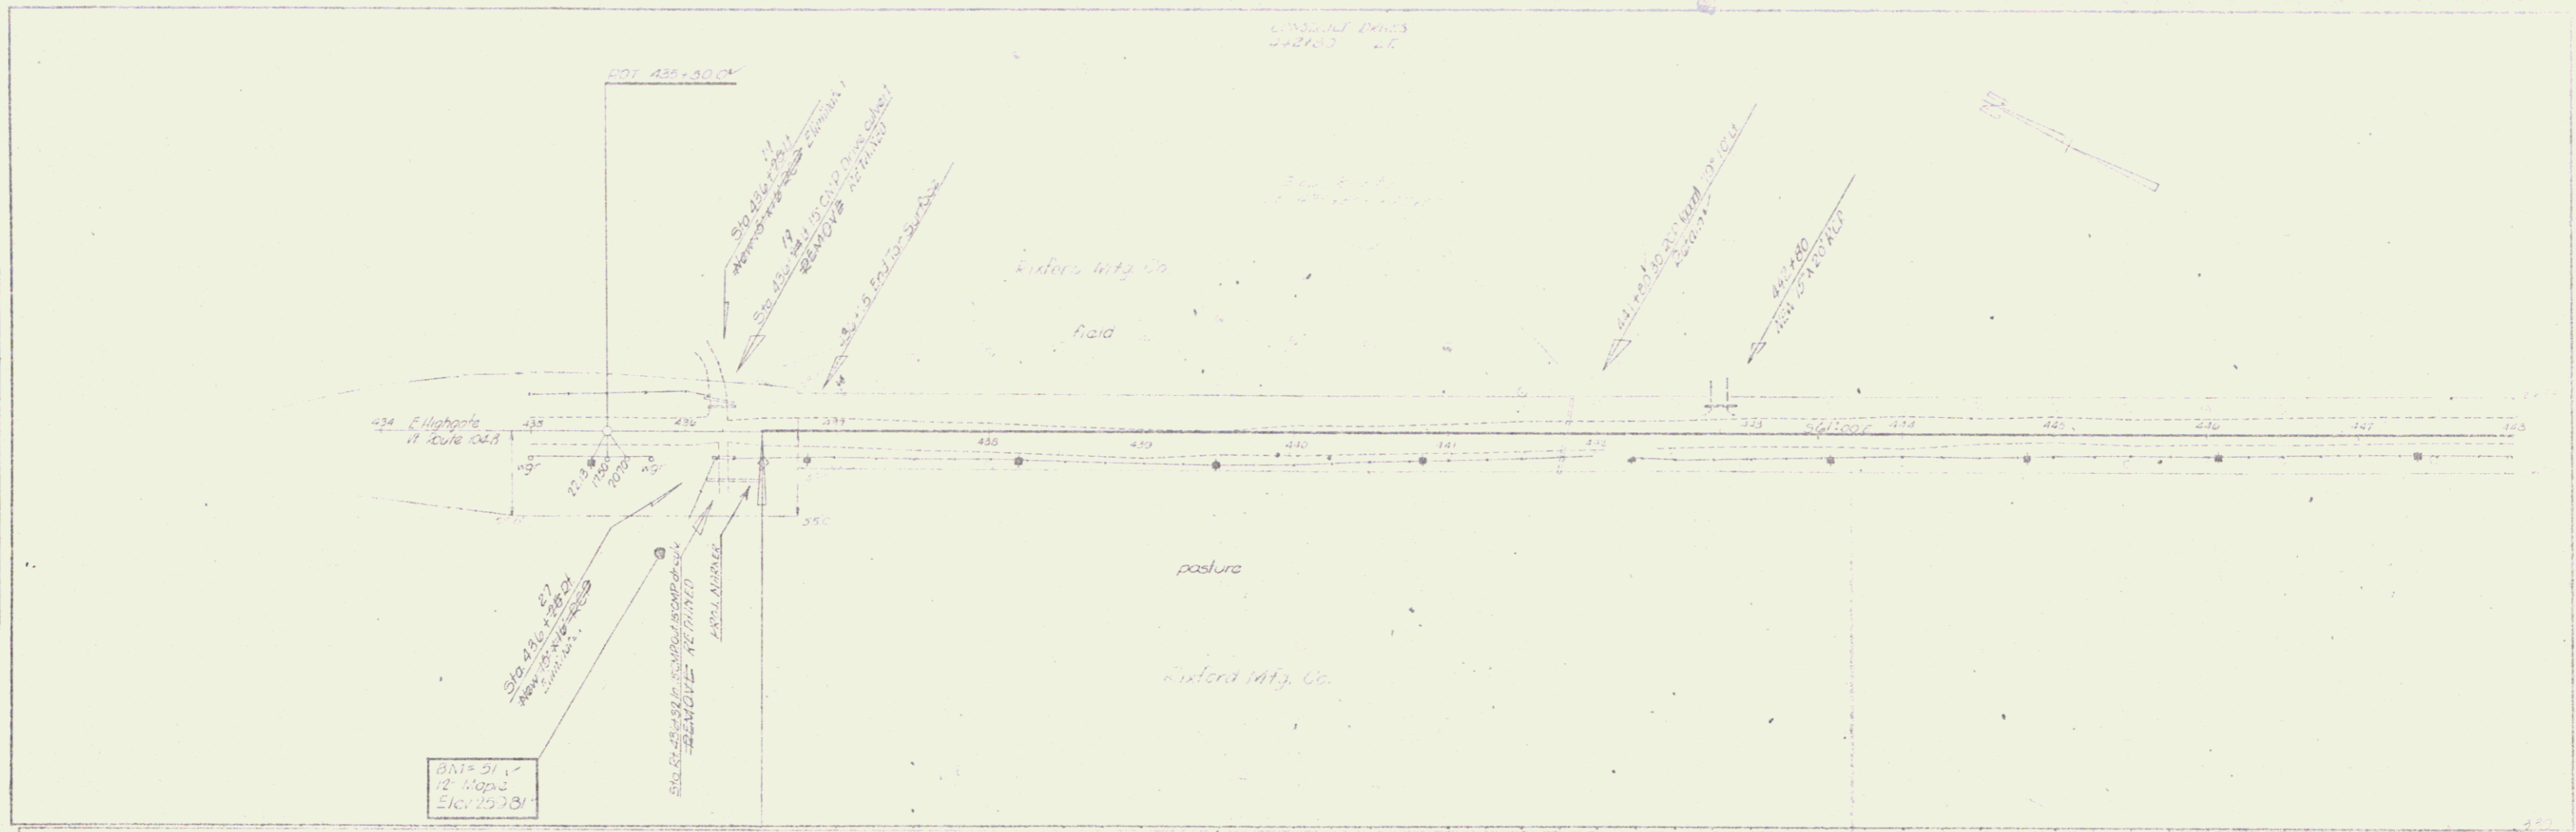

PLAN	DATE
REVISED	
NOTED	
NO.	

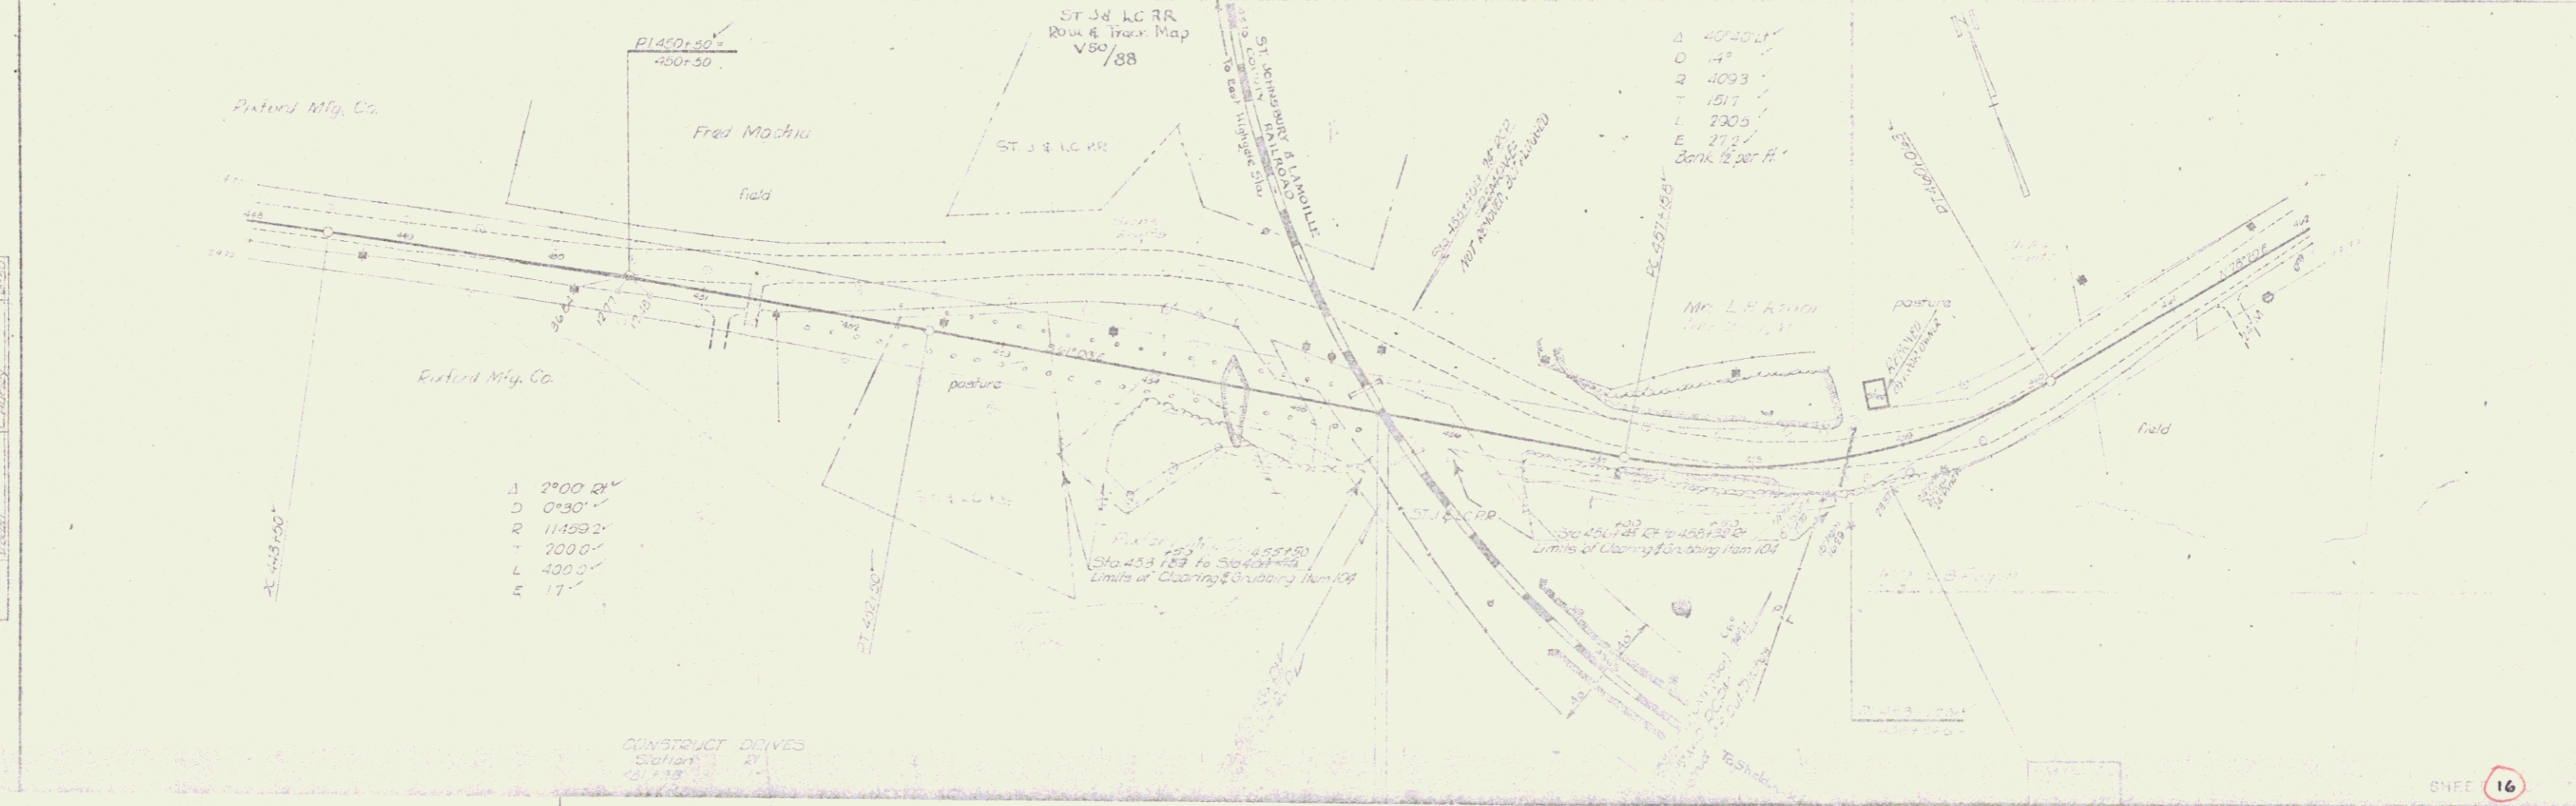

- 1 2°00' 2"
- 2 0°30'
- 3 11°59' 2"
- 4 200.0'
- 5 17'

- Δ 40°30'
- 14'
- 4093'
- ▽ 1517'
- ◇ 7900'
- ∇ 27.1'
- Bank 12 per ft

CONSTRUCT DRIVES  
Station 2  
12/13