

PLAN
 DRAWN BY: PASTERN
 CHECKED BY: [blank]
 DATE: [blank]
 PROJECT: [blank]

PROFILE
 DRAWN BY: PASTERN
 CHECKED BY: [blank]
 DATE: [blank]
 PROJECT: [blank]

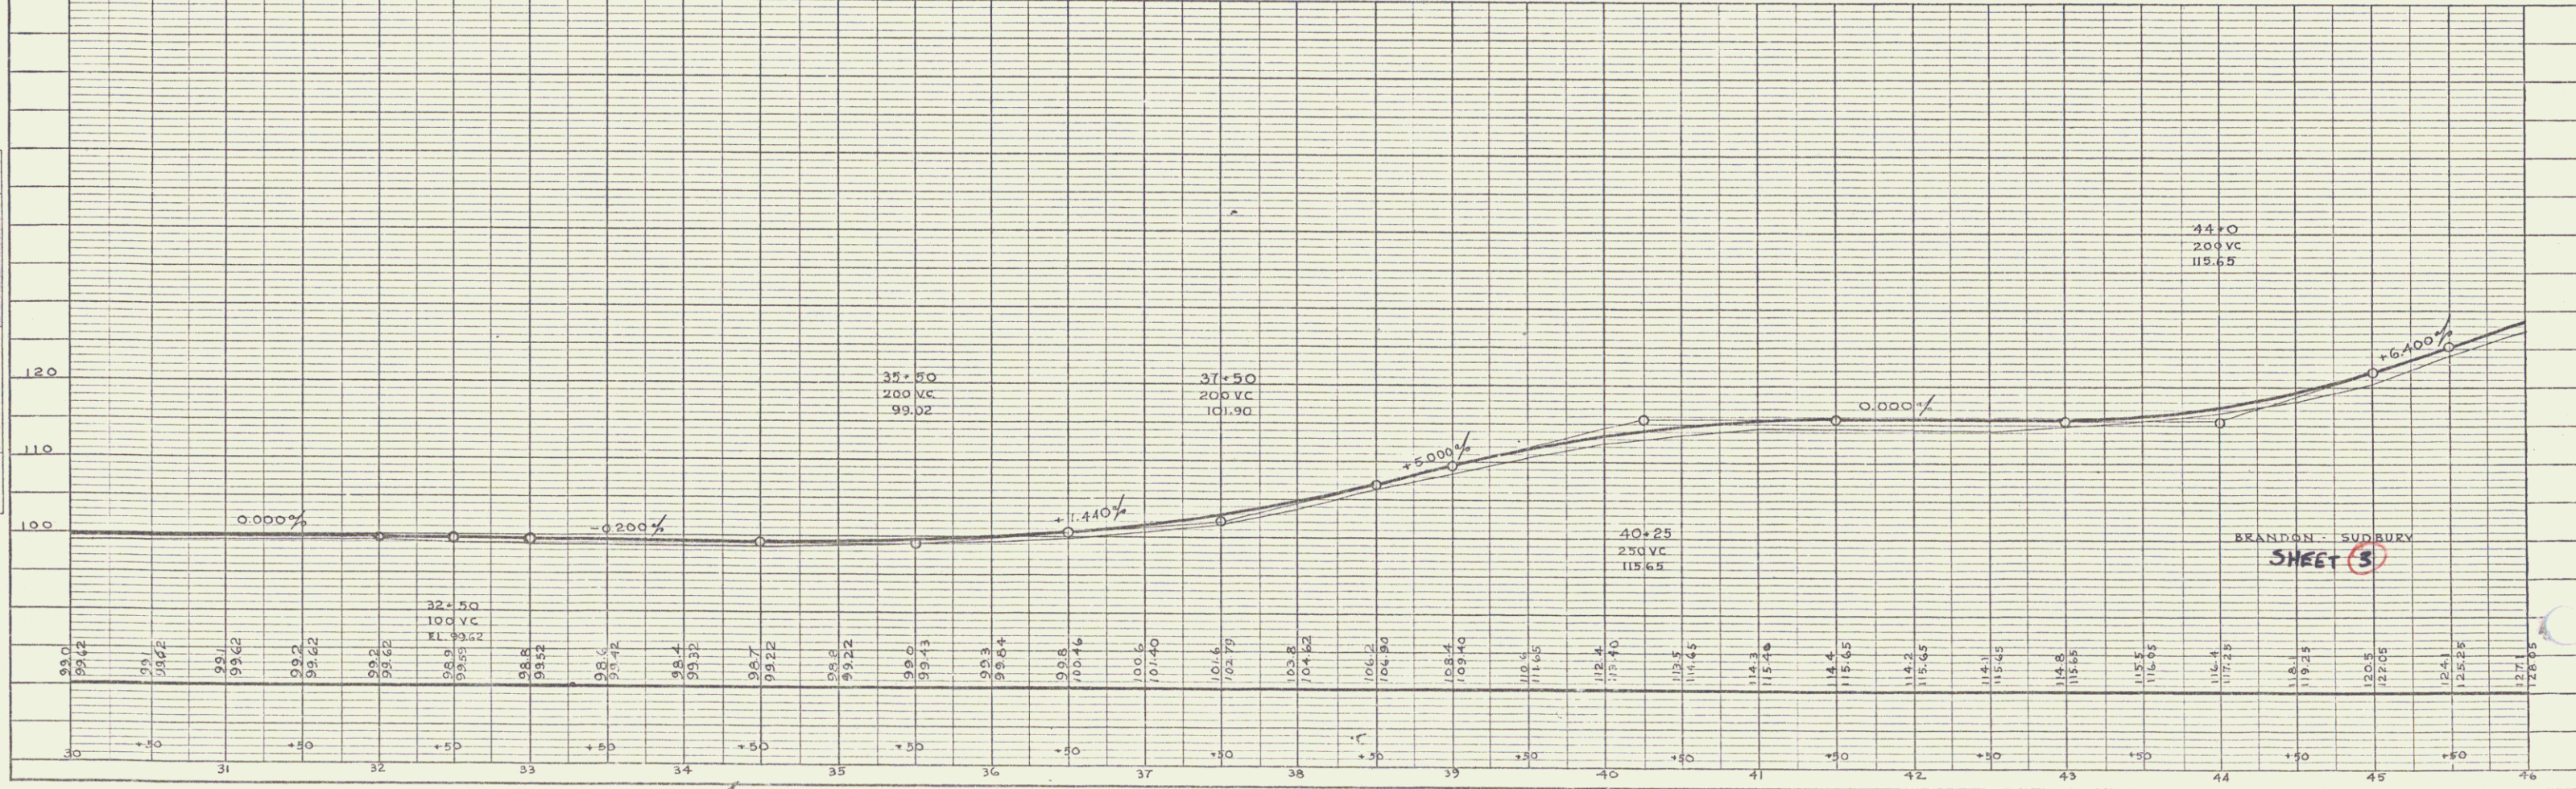
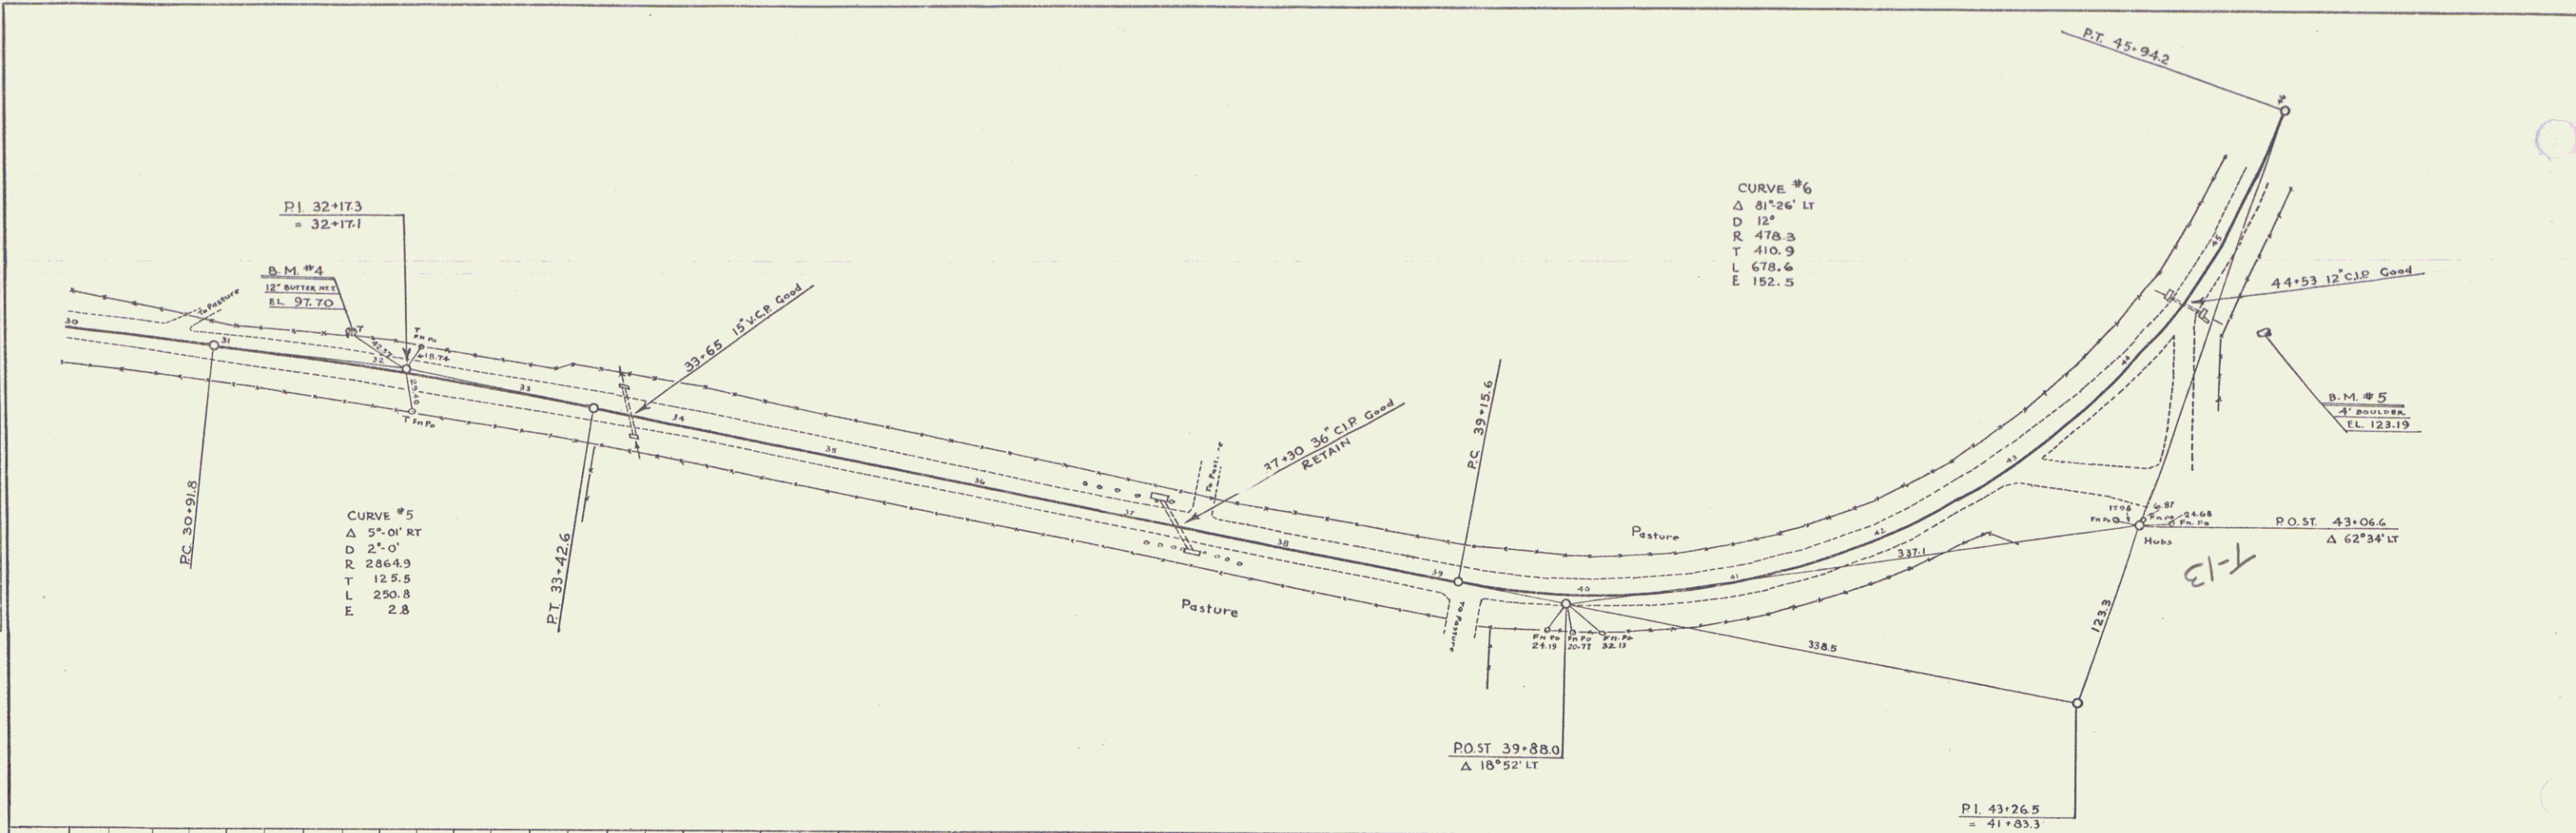


PLATE 1 - PLAN - PROFILE D. P. R. & S. STANDARD
 CAPITAL & GUYER CO. 1941-1944