
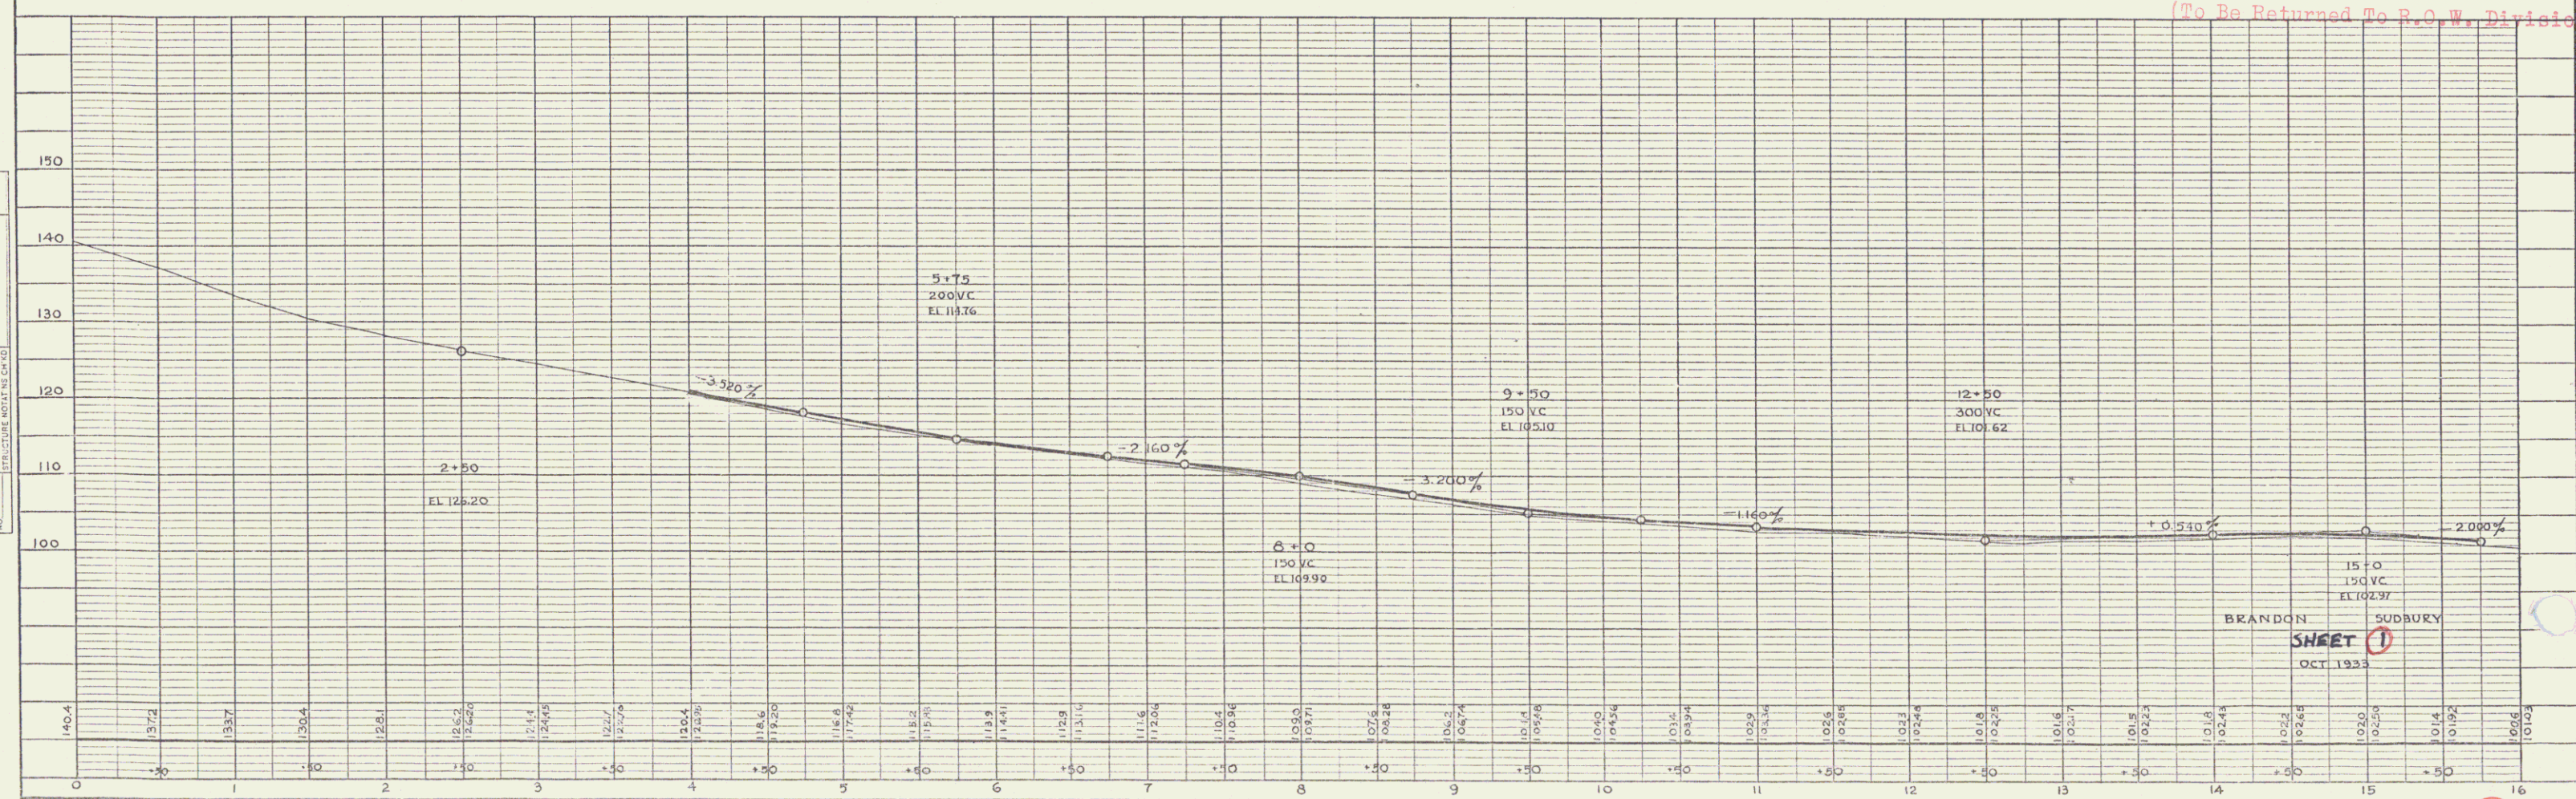


PLAN  
 DRAWN BY: PUTNAM  
 DATE: 10-23-33  
 NOTE BOOK NO. 1000  
 CHECKED BY: [Signature]  
 DATE: [Signature]

PROFILE  
 DRAWN BY: PUTNAM  
 DATE: 10-23-33  
 NOTE BOOK NO. 1000  
 CHECKED BY: [Signature]  
 DATE: [Signature]

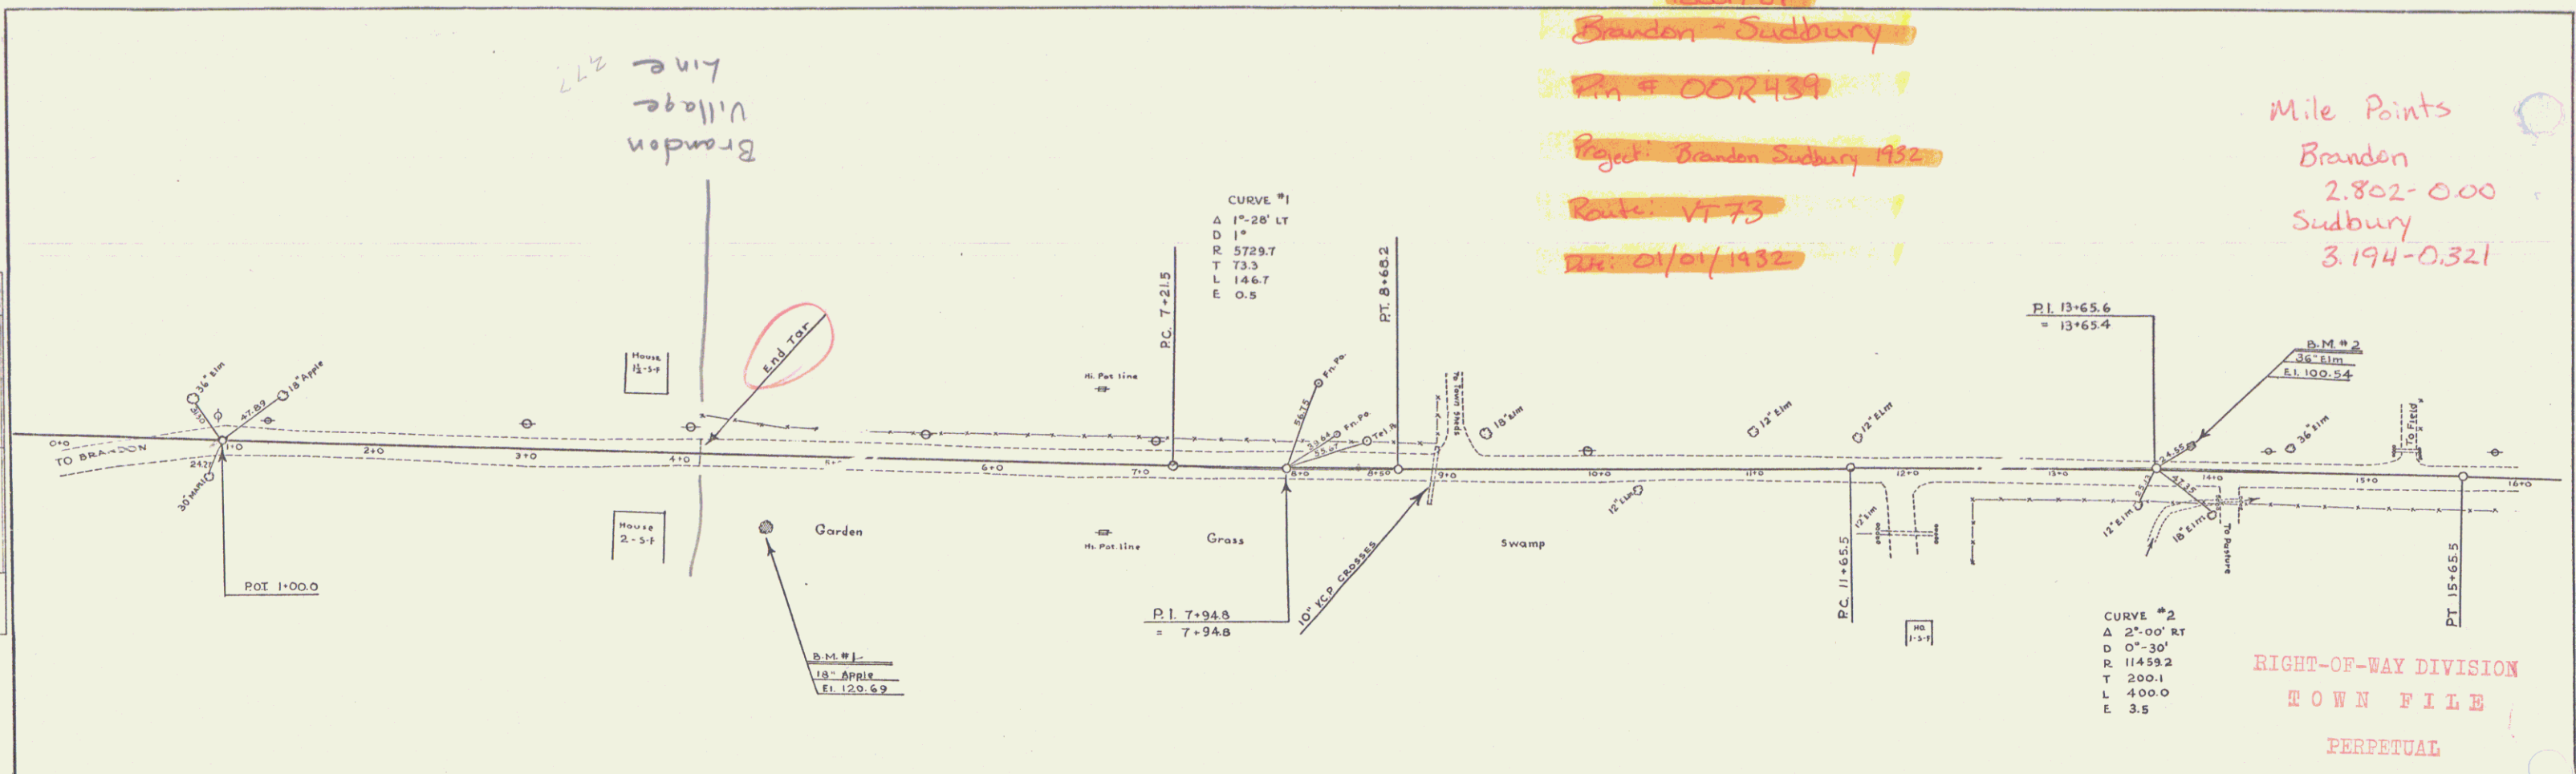

Town of  
 Brandon - Sudbury  
 P.A. # 00R434  
 Project: Brandon Sudbury 1932  
 Route: VT 73  
 Date: 01/01/1932

Mile Points  
 Brandon  
 2.802-0.00  
 Sudbury  
 3.194-0.321



RIGHT-OF-WAY DIVISION  
 TOWN FILE  
 PERPETUAL

Town of \_\_\_\_\_  
 (To Be Returned To R.O.W. Division)

BRANDON SUDBURY  
 SHEET 1  
 OCT 1933

PLAN  
 DATE: 12/15/11  
 DRAWN BY: BUTTANZI  
 CHECKED BY: [blank]  
 NO. OF ANY CHECKS: [blank]



PROFILE  
 DATE: 12/15/11  
 DRAWN BY: BUTTANZI  
 CHECKED BY: [blank]  
 NO. OF ANY CHECKS: [blank]

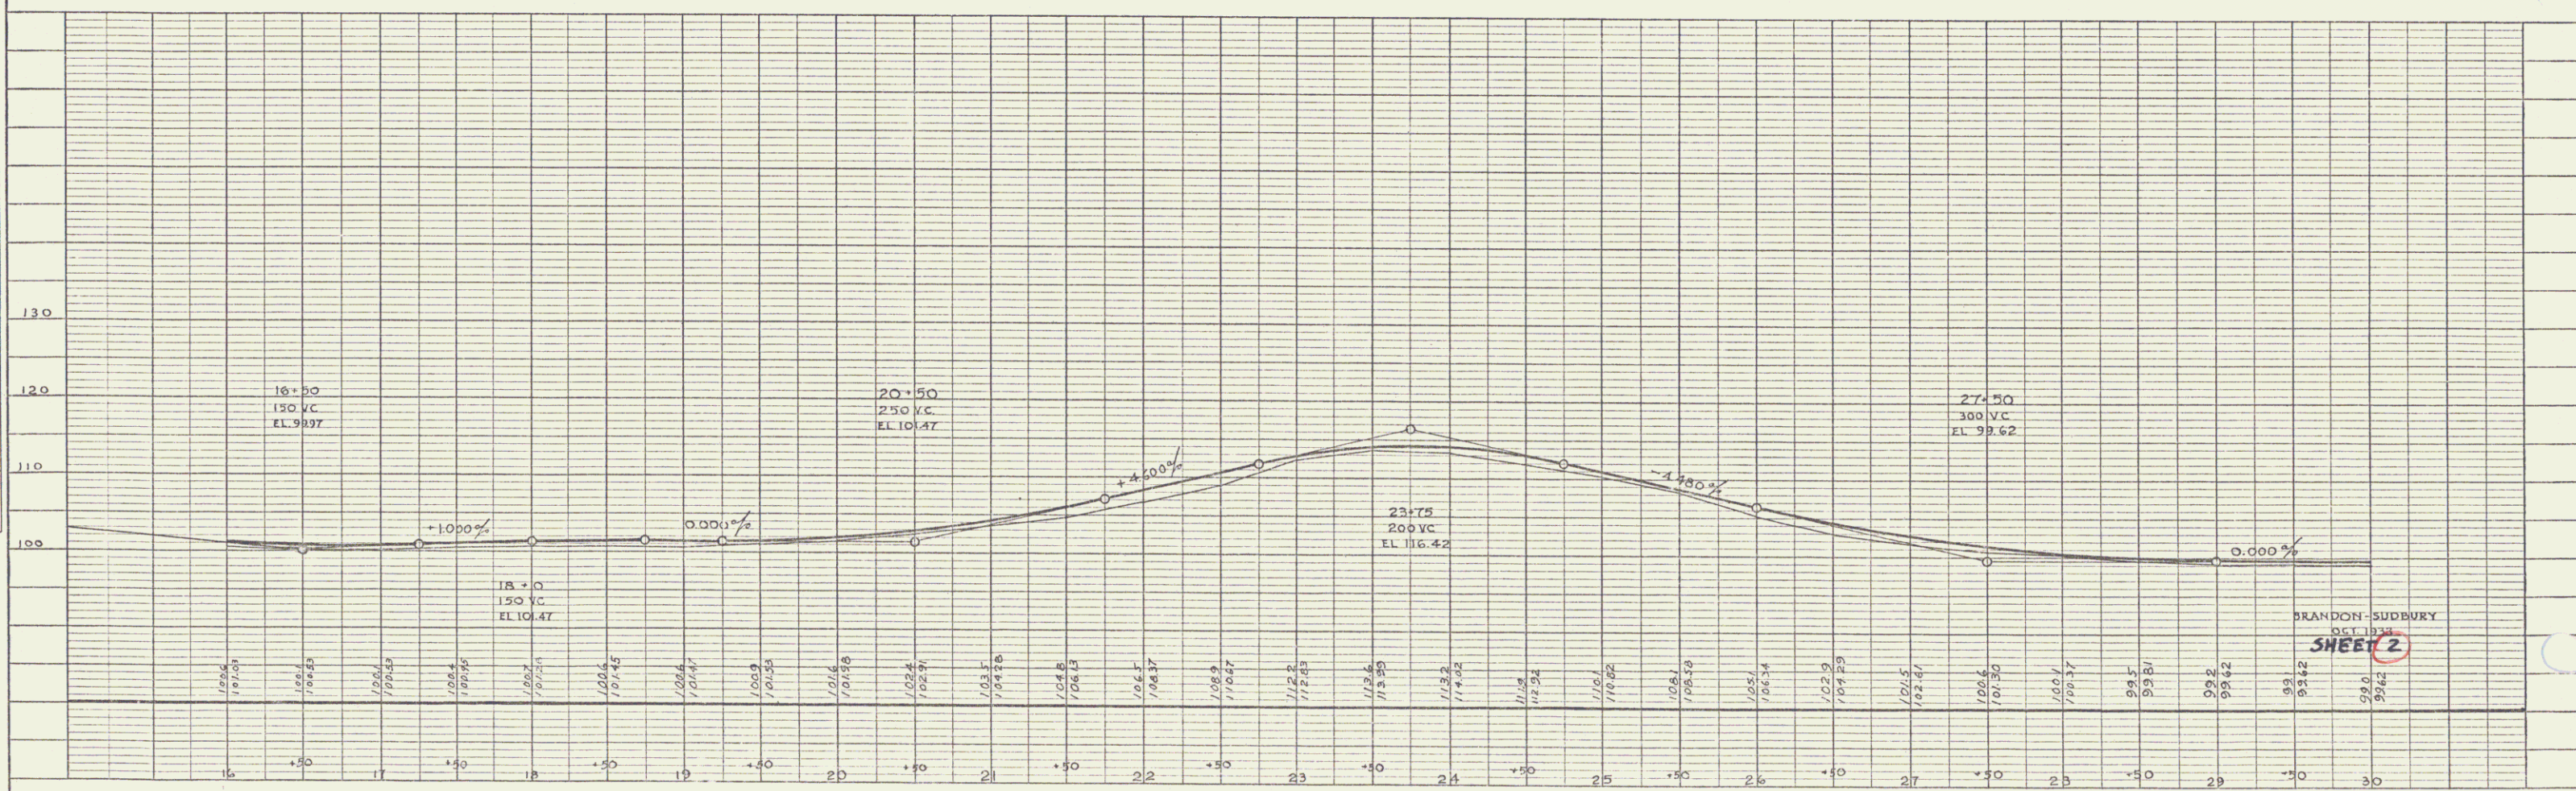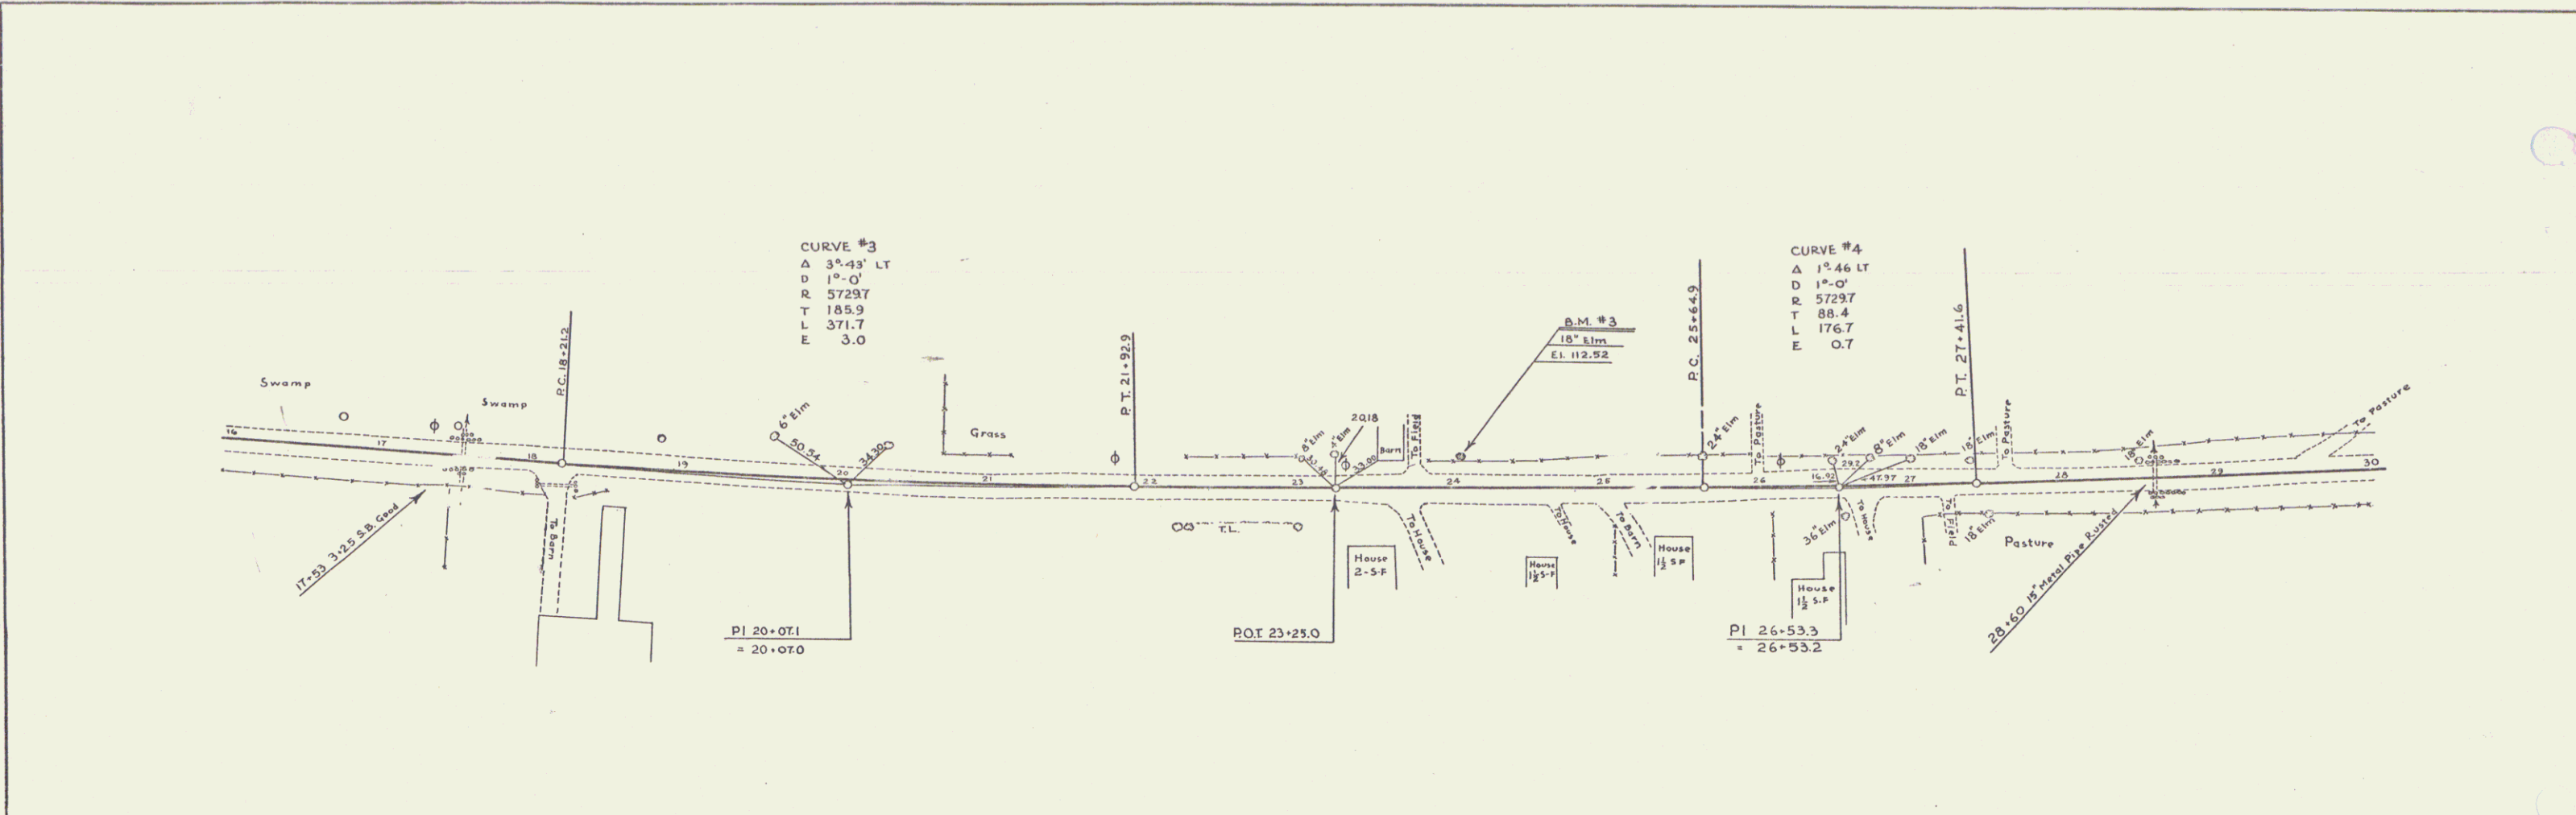



PLAN  
 PARTIAL  
 NOTE BOOK  
 REVISIONS CHECKED  
 BY: M.A. VOTTO  
 DATE: 11/11/03  
 NO. 1

PROFILE  
 PARTIAL  
 NOTE BOOK  
 REVISIONS CHECKED  
 BY: M.A. VOTTO  
 DATE: 11/11/03  
 NO. 1

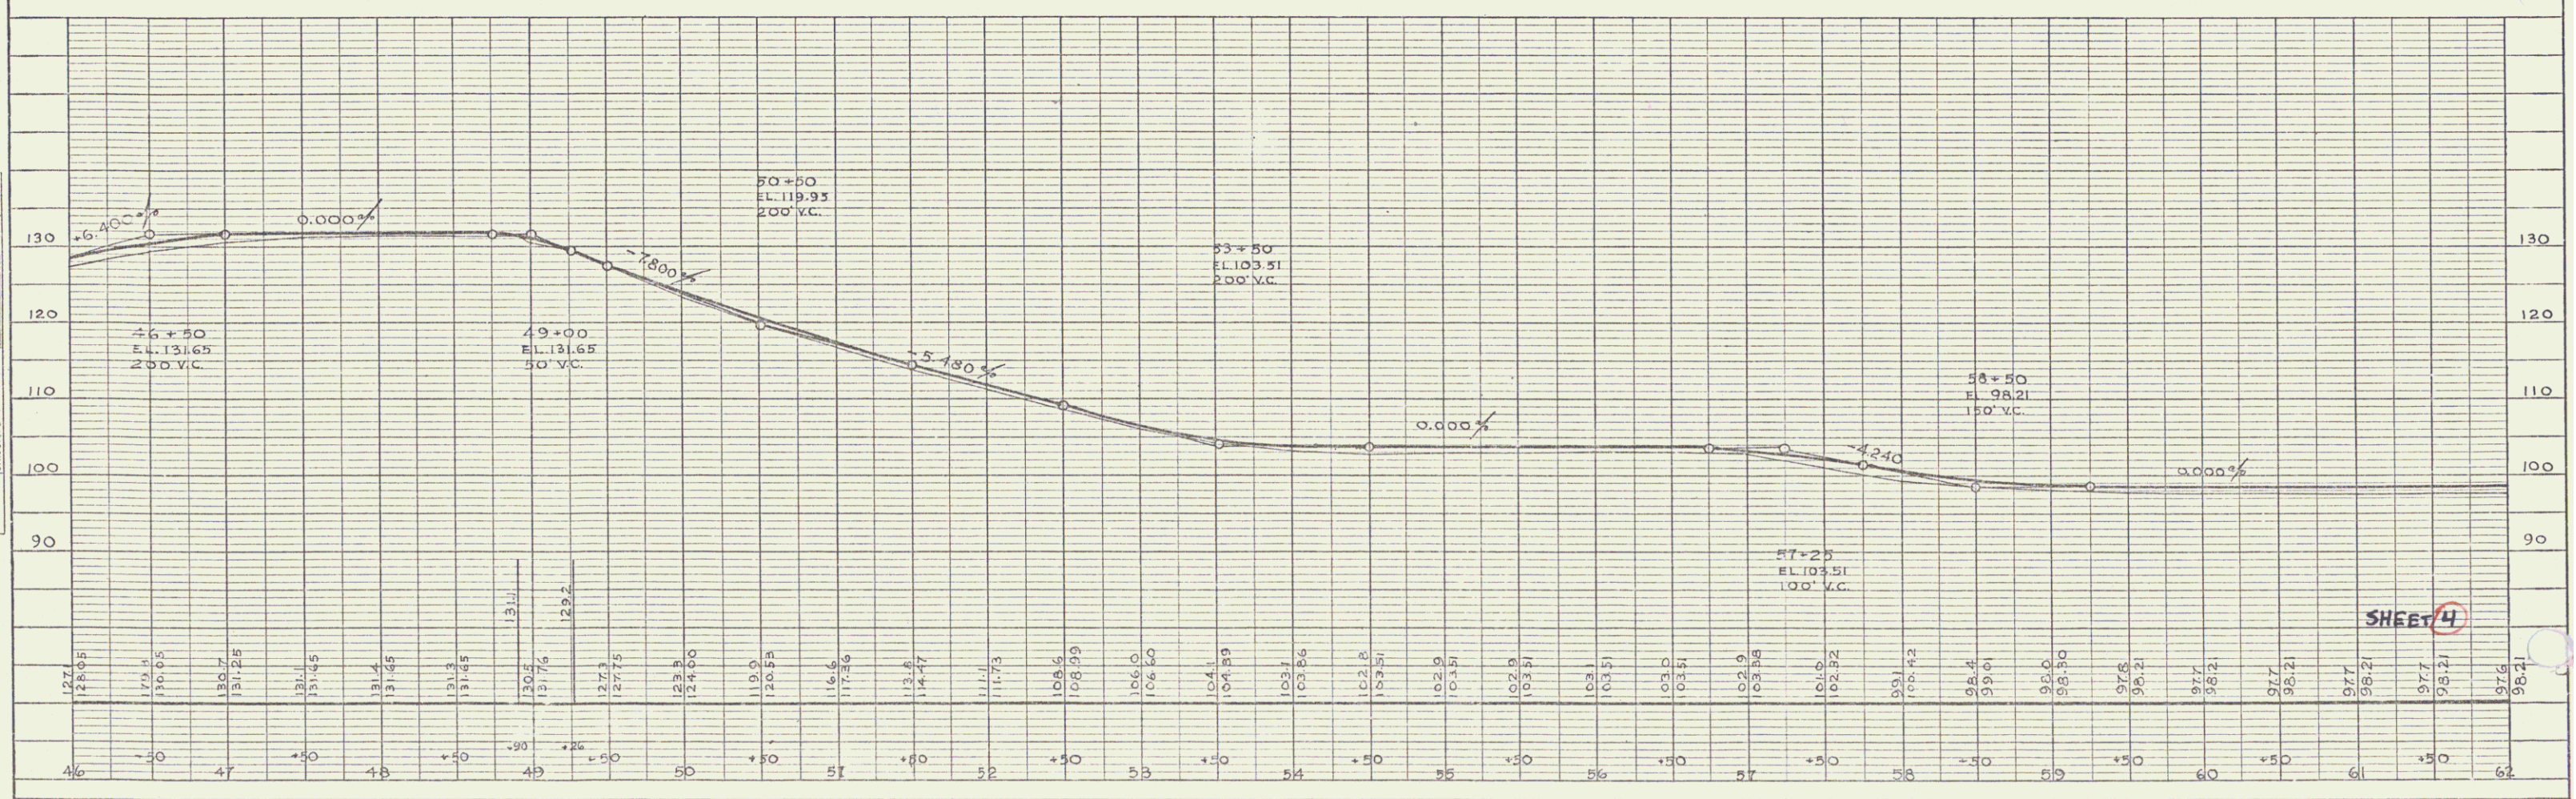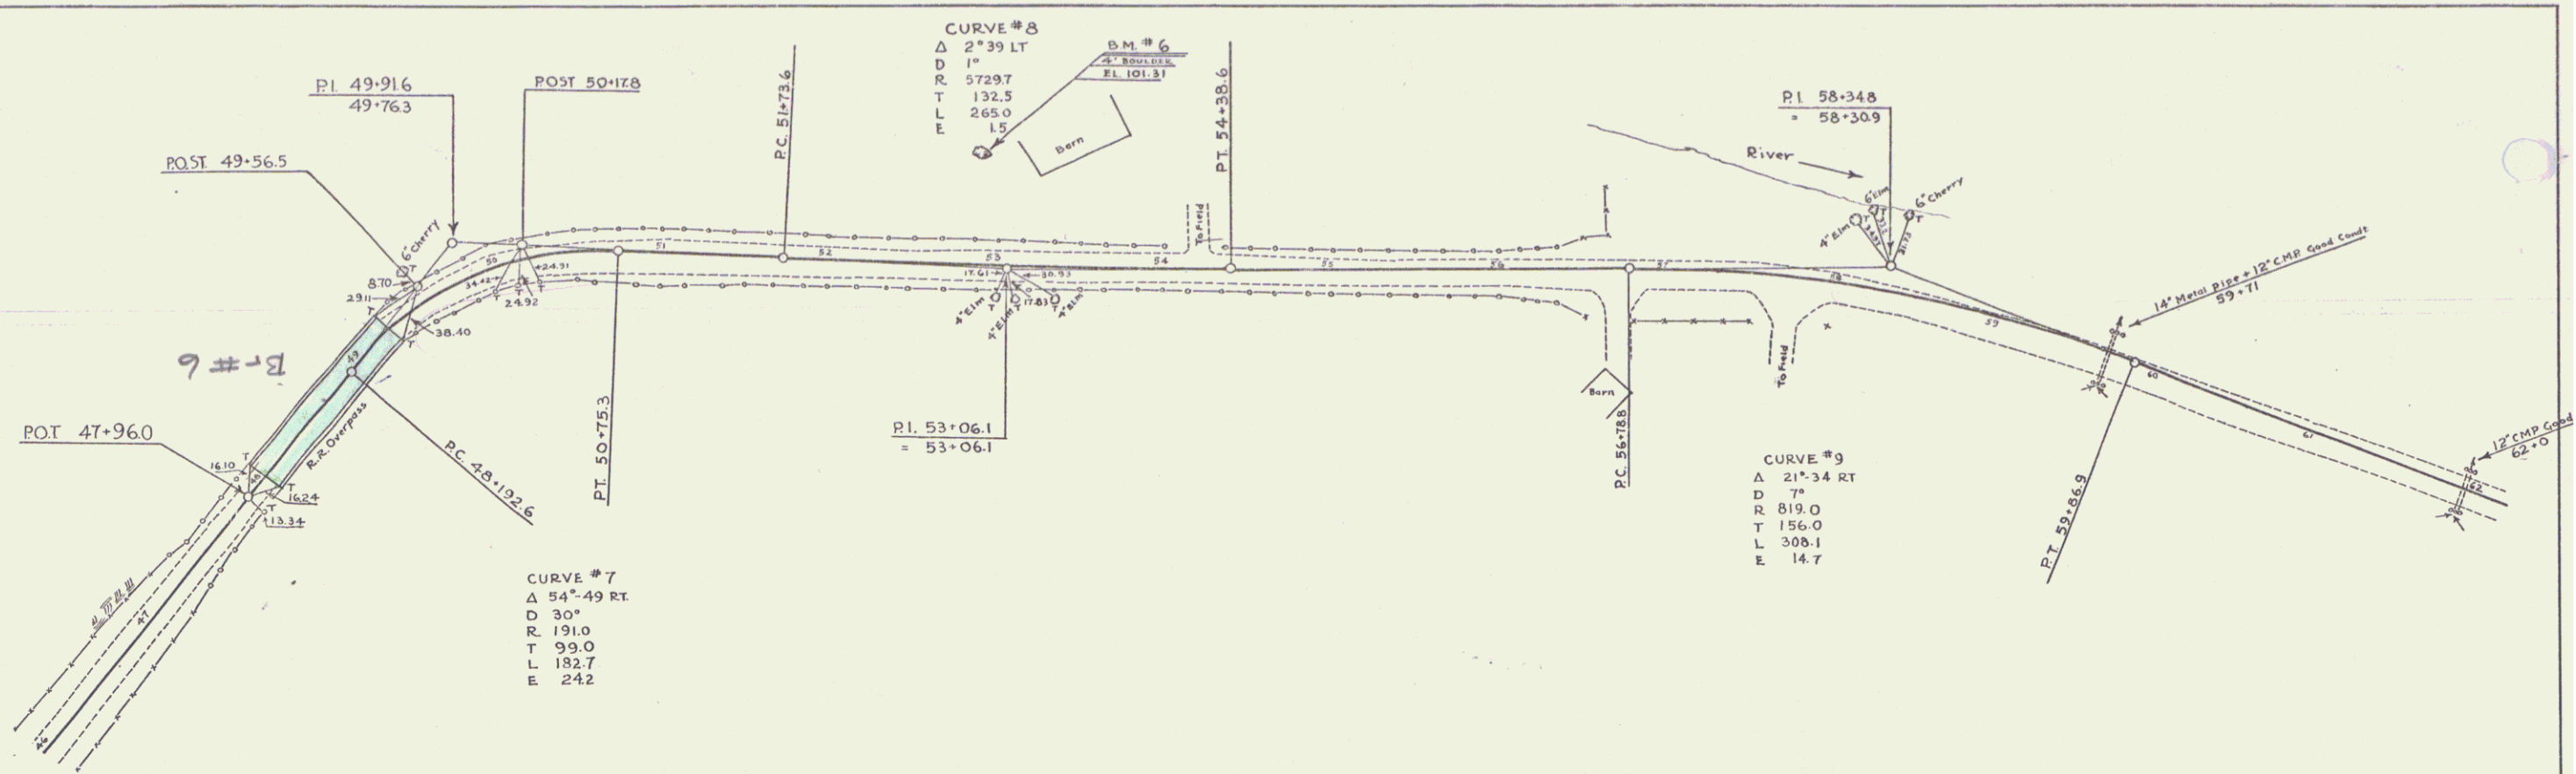



SHEET 4

Br. 3.11 3+36

4

PLAN  
 DRAWN BY: \_\_\_\_\_  
 CHECKED BY: \_\_\_\_\_  
 DATE: \_\_\_\_\_

PROFILE  
 DRAWN BY: \_\_\_\_\_  
 CHECKED BY: \_\_\_\_\_  
 DATE: \_\_\_\_\_

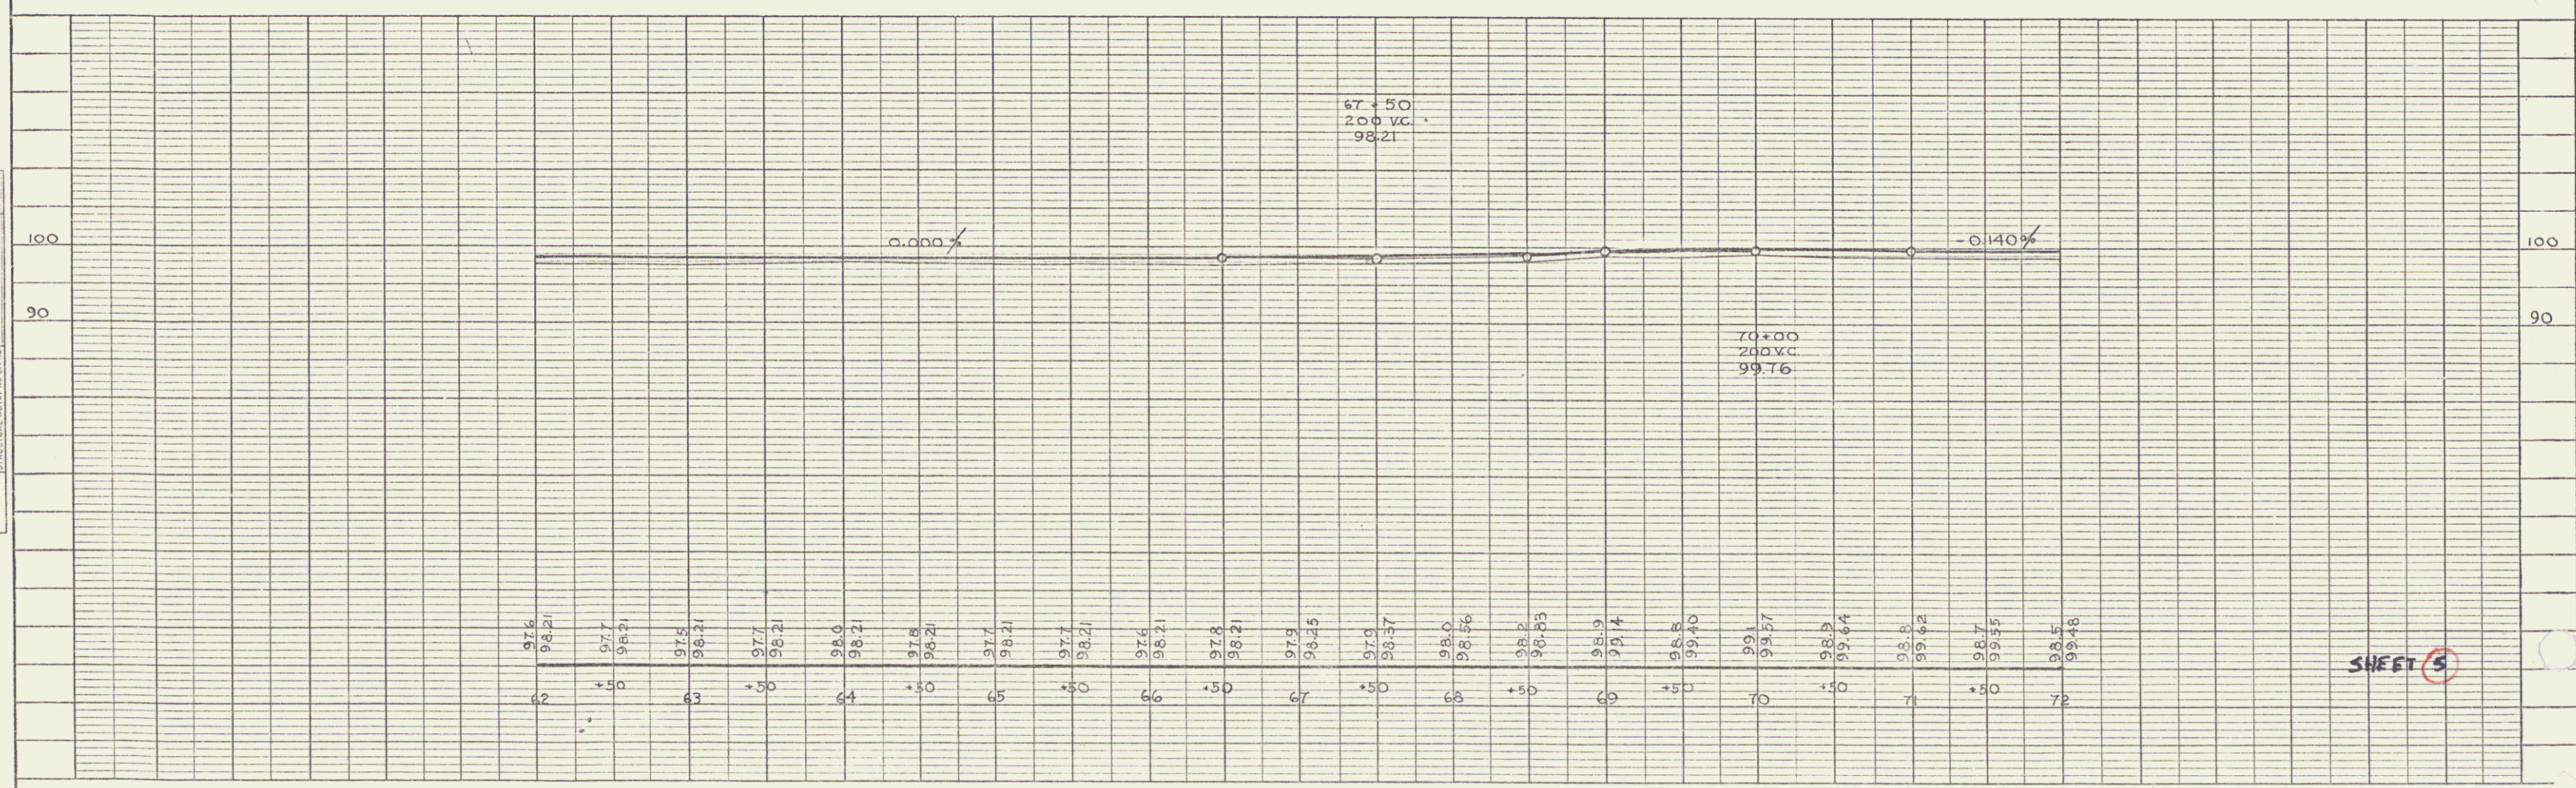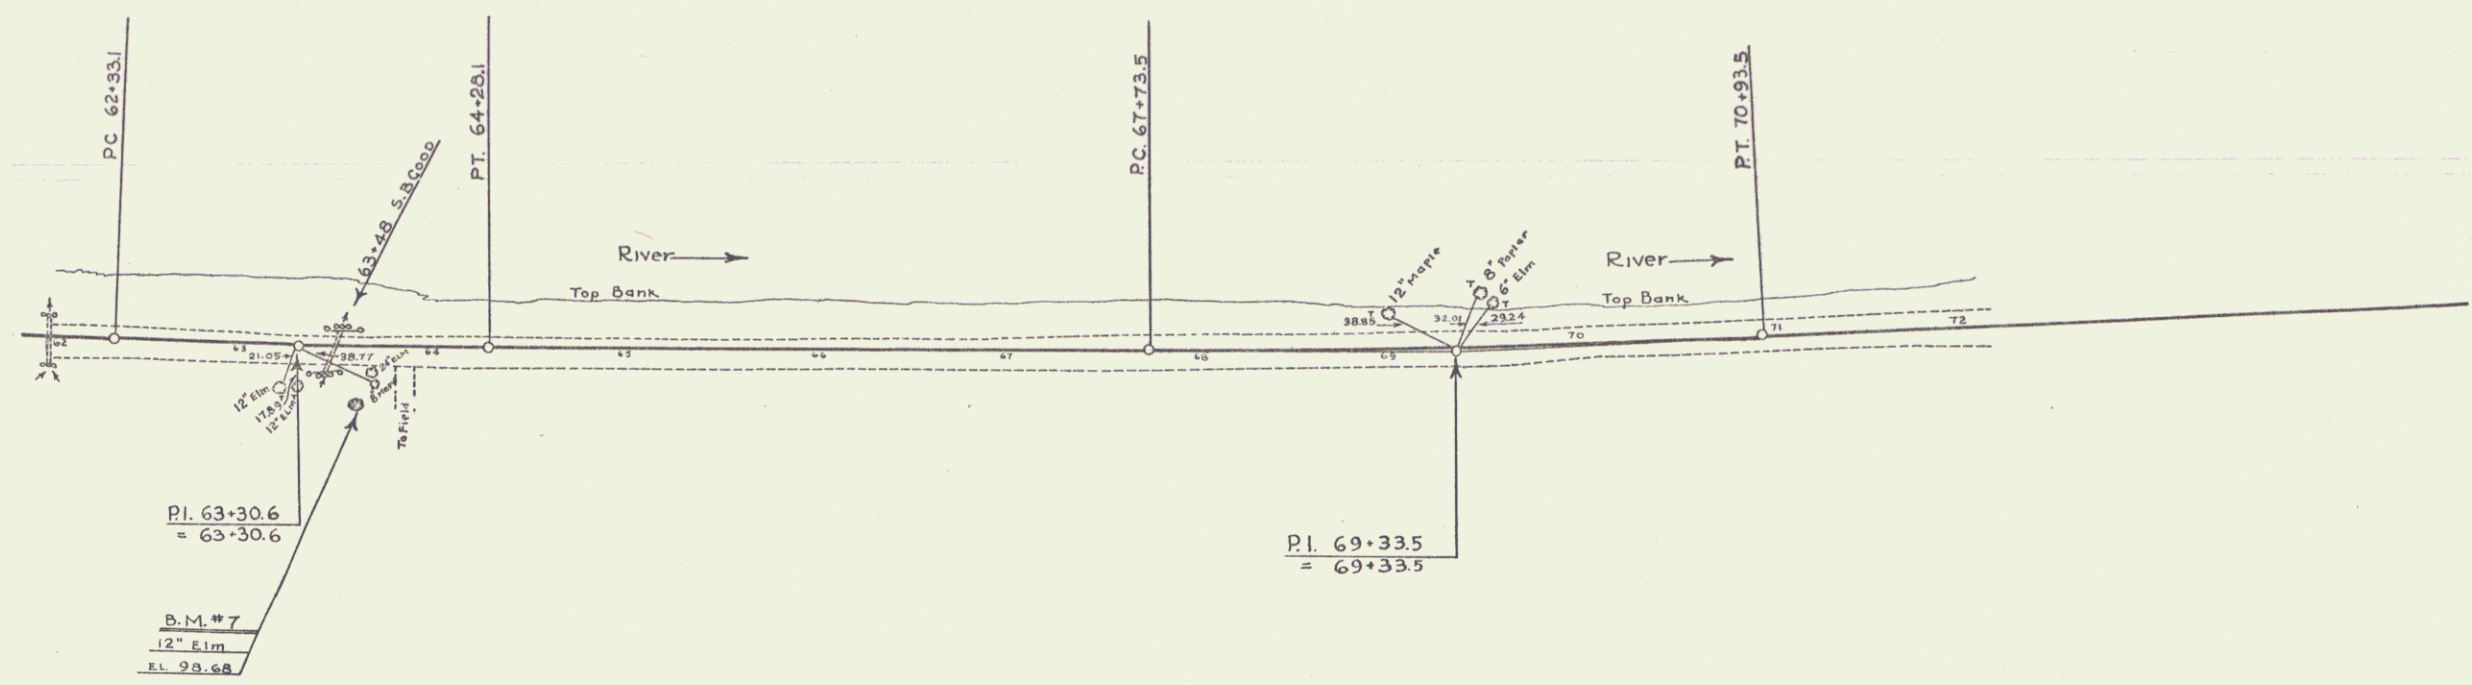


SHEET 5

5

PLAN  
 QUANTITY  
 ALIGNED  
 NOTE BOOK  
 NO.

PROFILE  
 QUANTITY  
 ALIGNED  
 NOTE BOOK  
 NO.

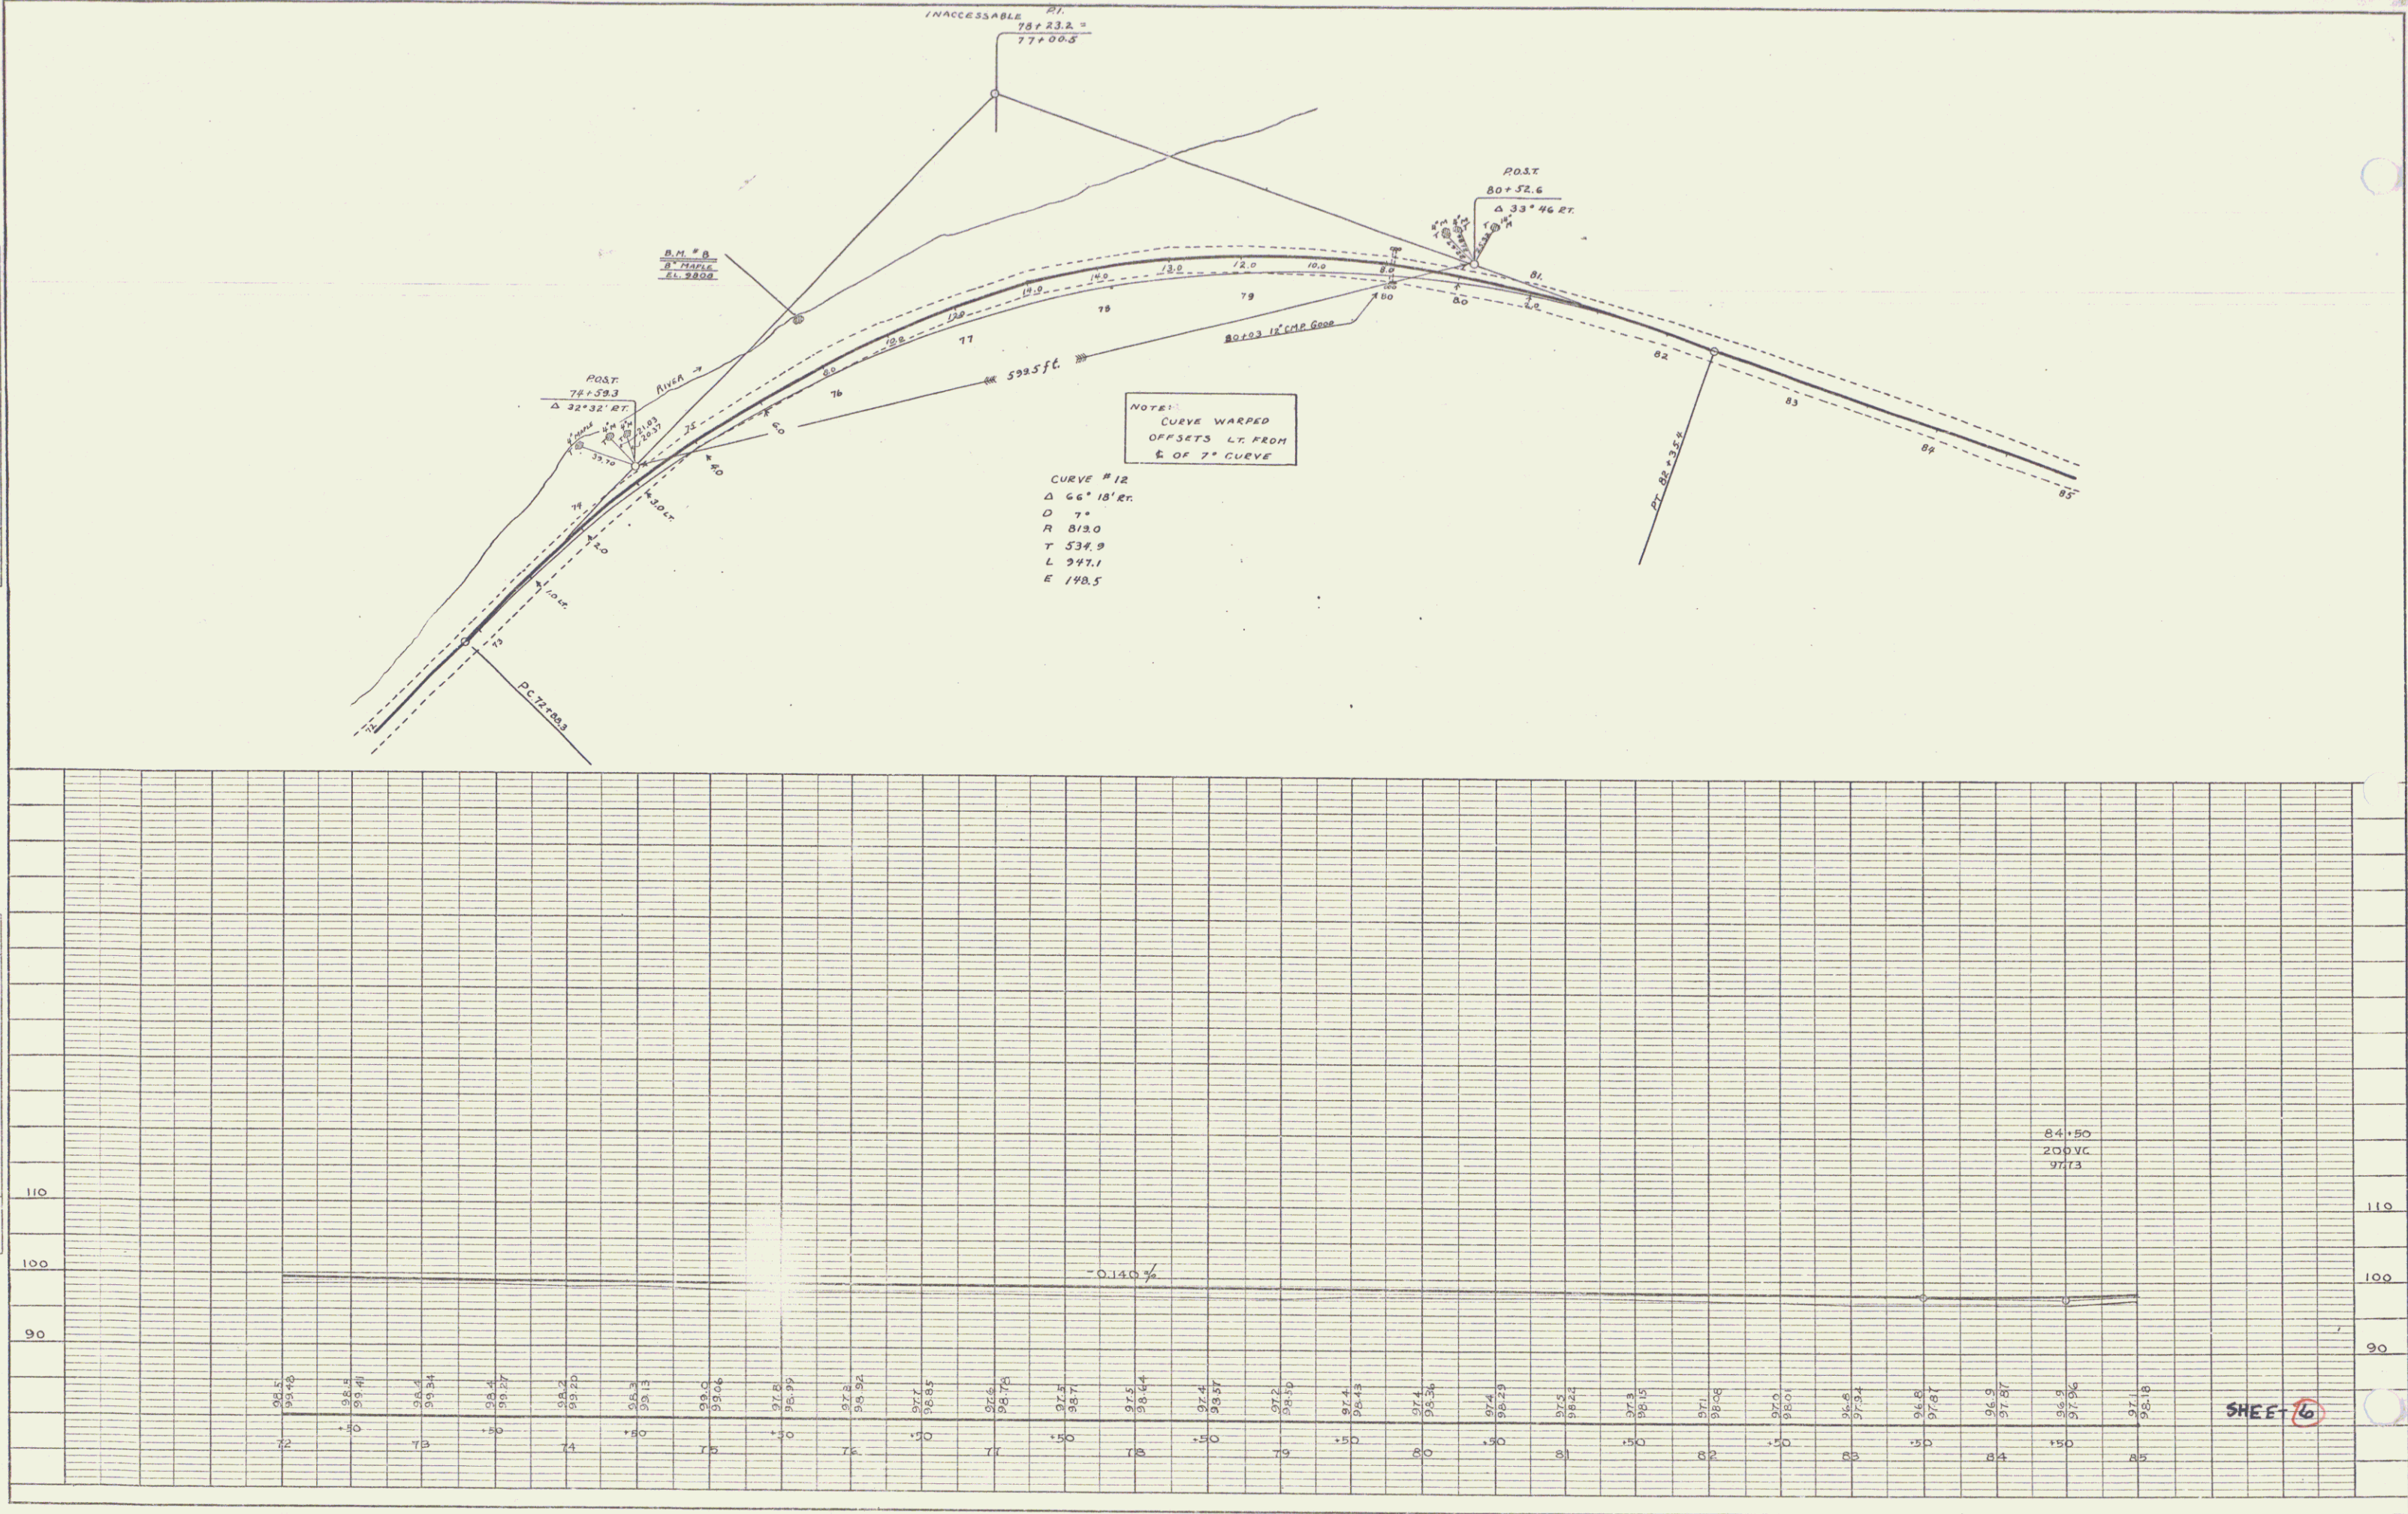



SHEET 6

6



PLAN  
 DATE: \_\_\_\_\_  
 DRAWN BY: \_\_\_\_\_  
 CHECKED BY: \_\_\_\_\_  
 NO. \_\_\_\_\_

PROFILE  
 DATE: \_\_\_\_\_  
 DRAWN BY: \_\_\_\_\_  
 CHECKED BY: \_\_\_\_\_  
 NO. \_\_\_\_\_

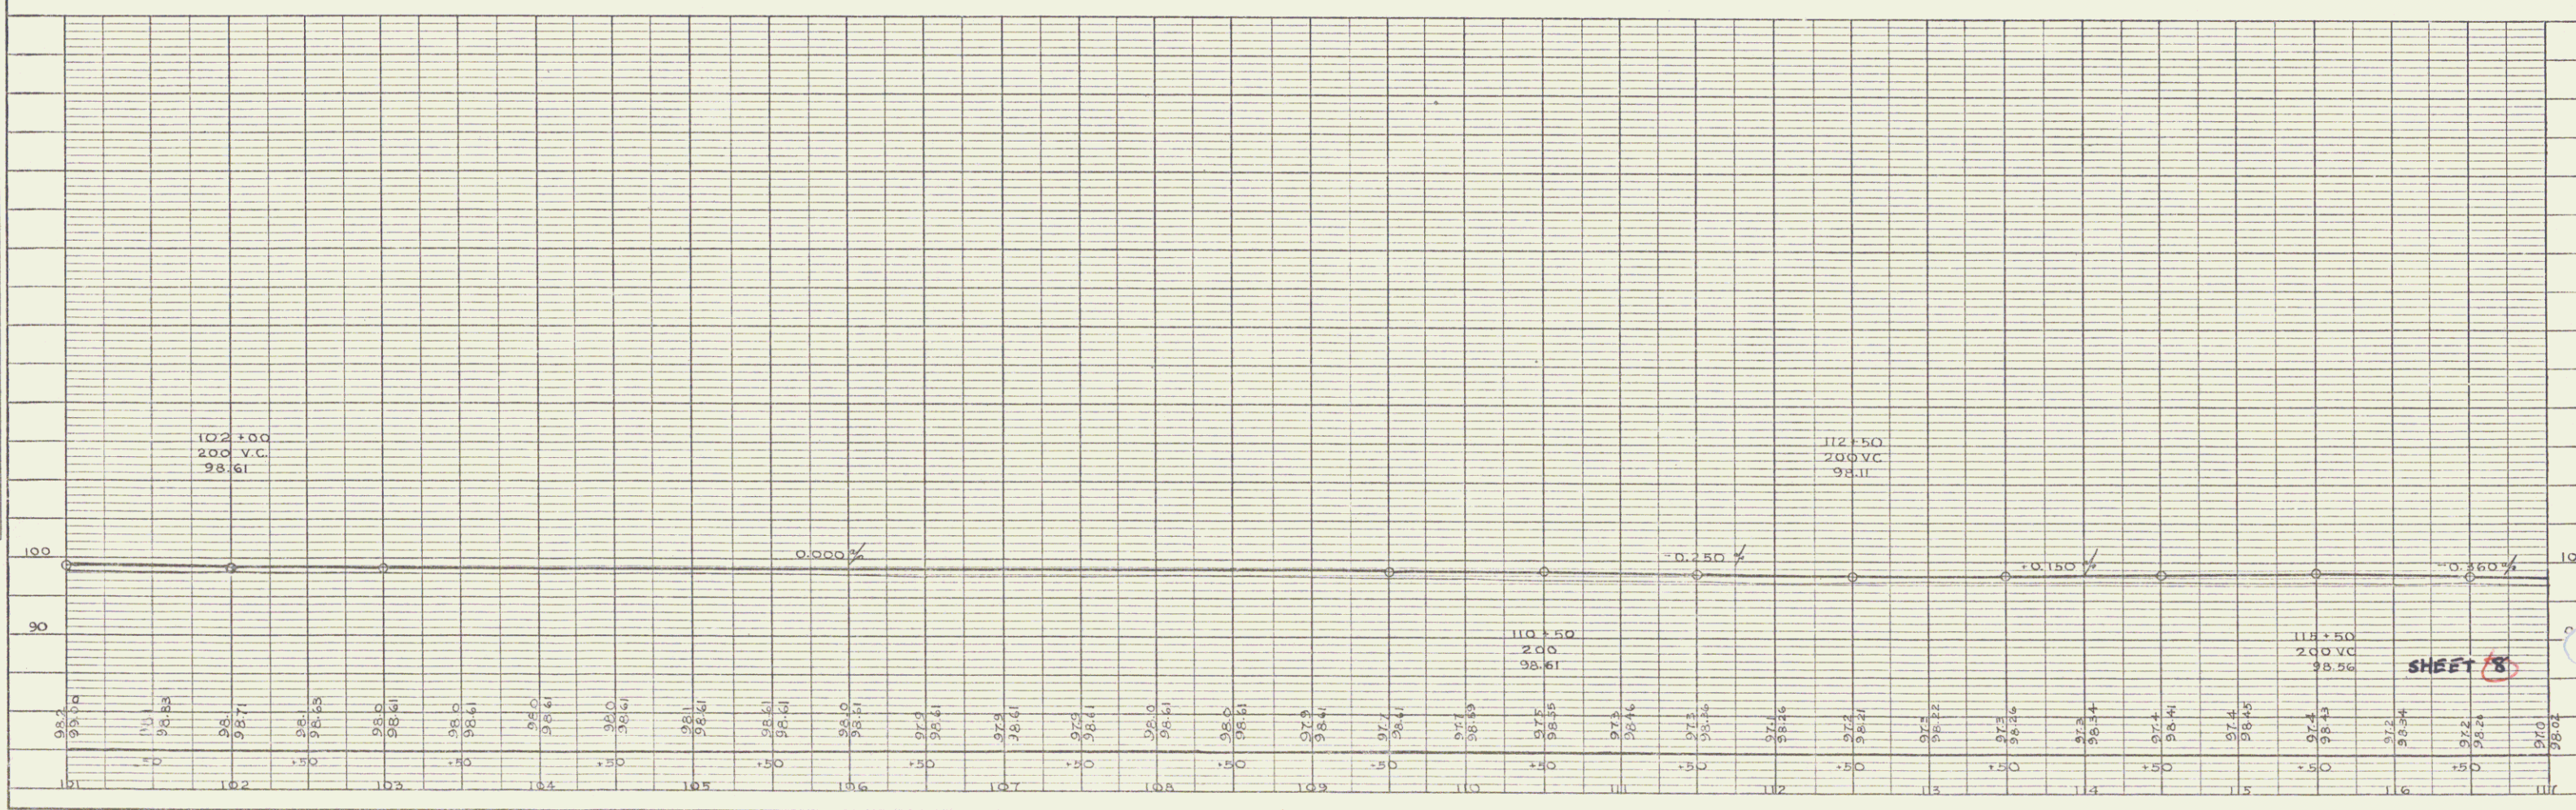
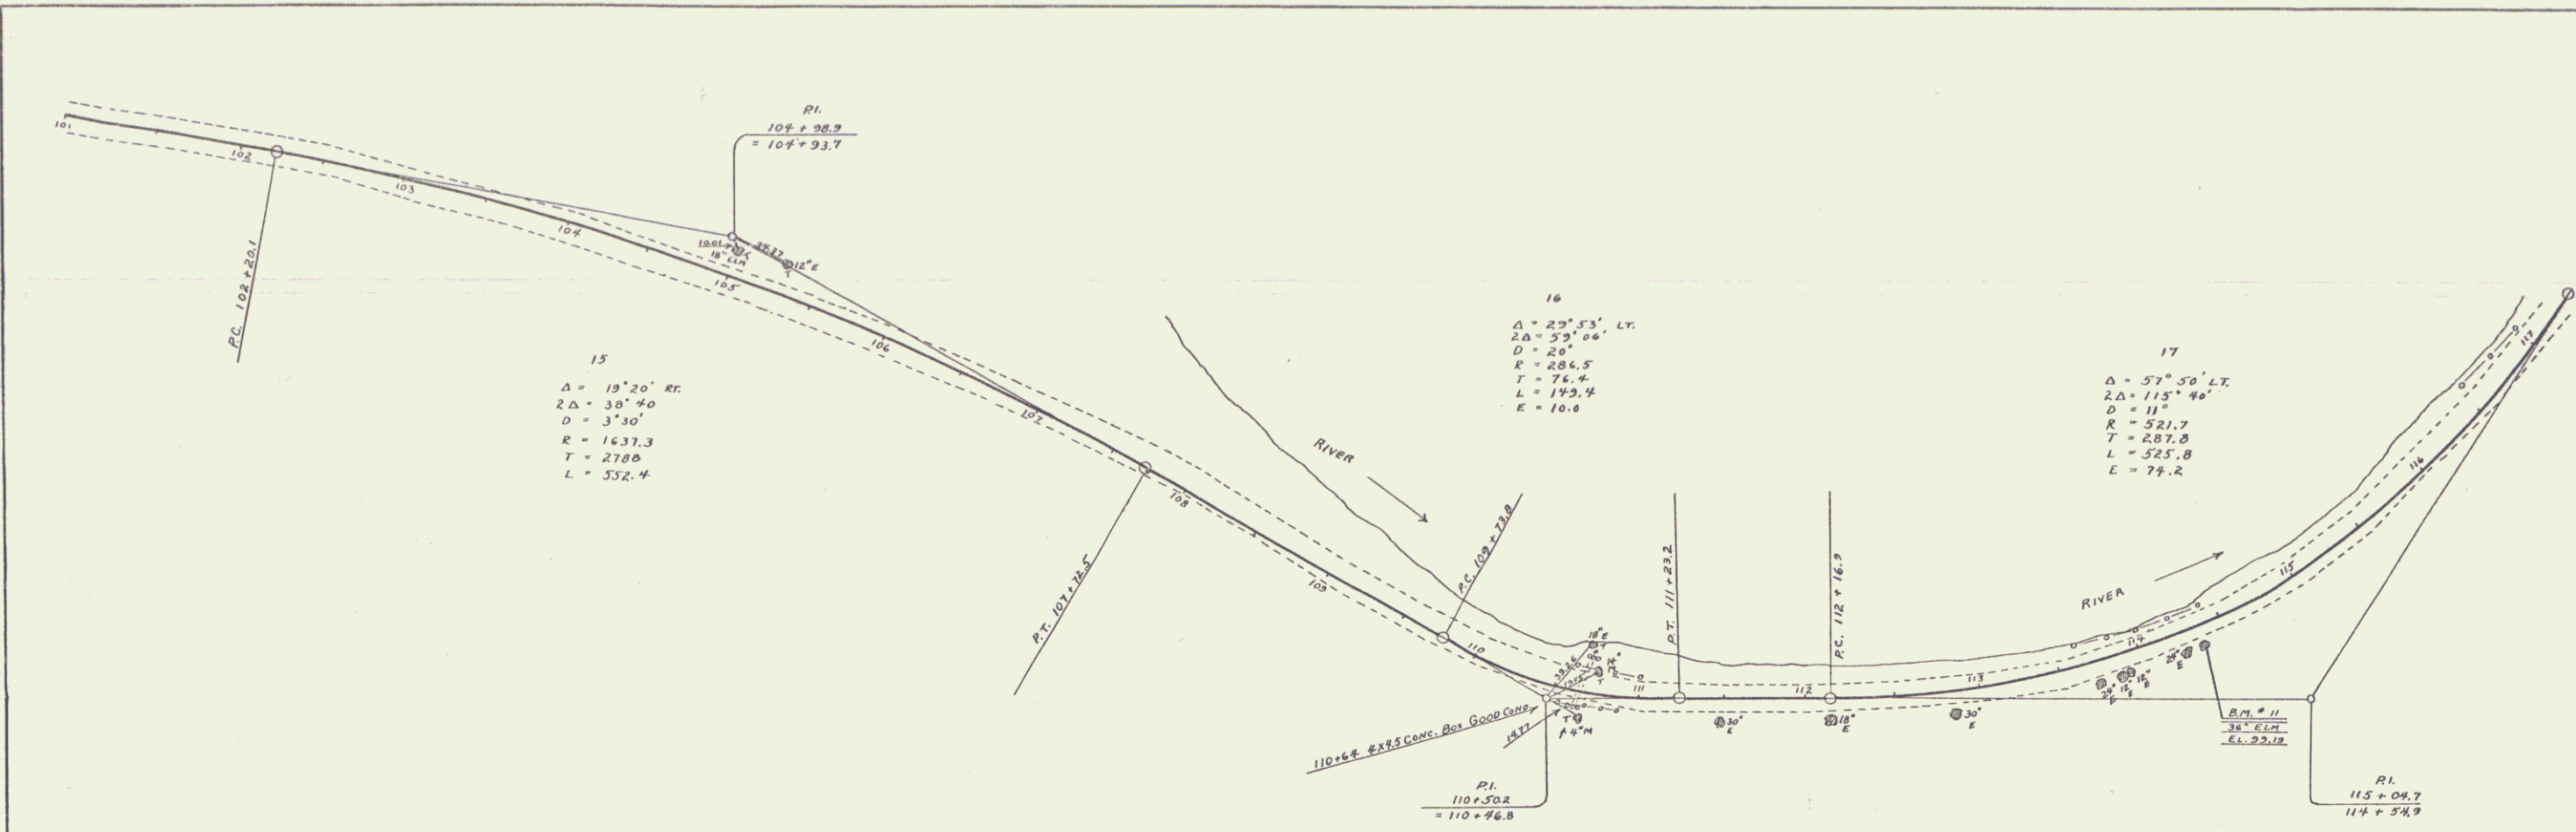


SHEET 8



PLAN  
 DRAWN BY: \_\_\_\_\_  
 CHECKED BY: \_\_\_\_\_  
 DATE: \_\_\_\_\_  
 NO. \_\_\_\_\_

PROFILE  
 DRAWN BY: \_\_\_\_\_  
 CHECKED BY: \_\_\_\_\_  
 DATE: \_\_\_\_\_  
 NO. \_\_\_\_\_

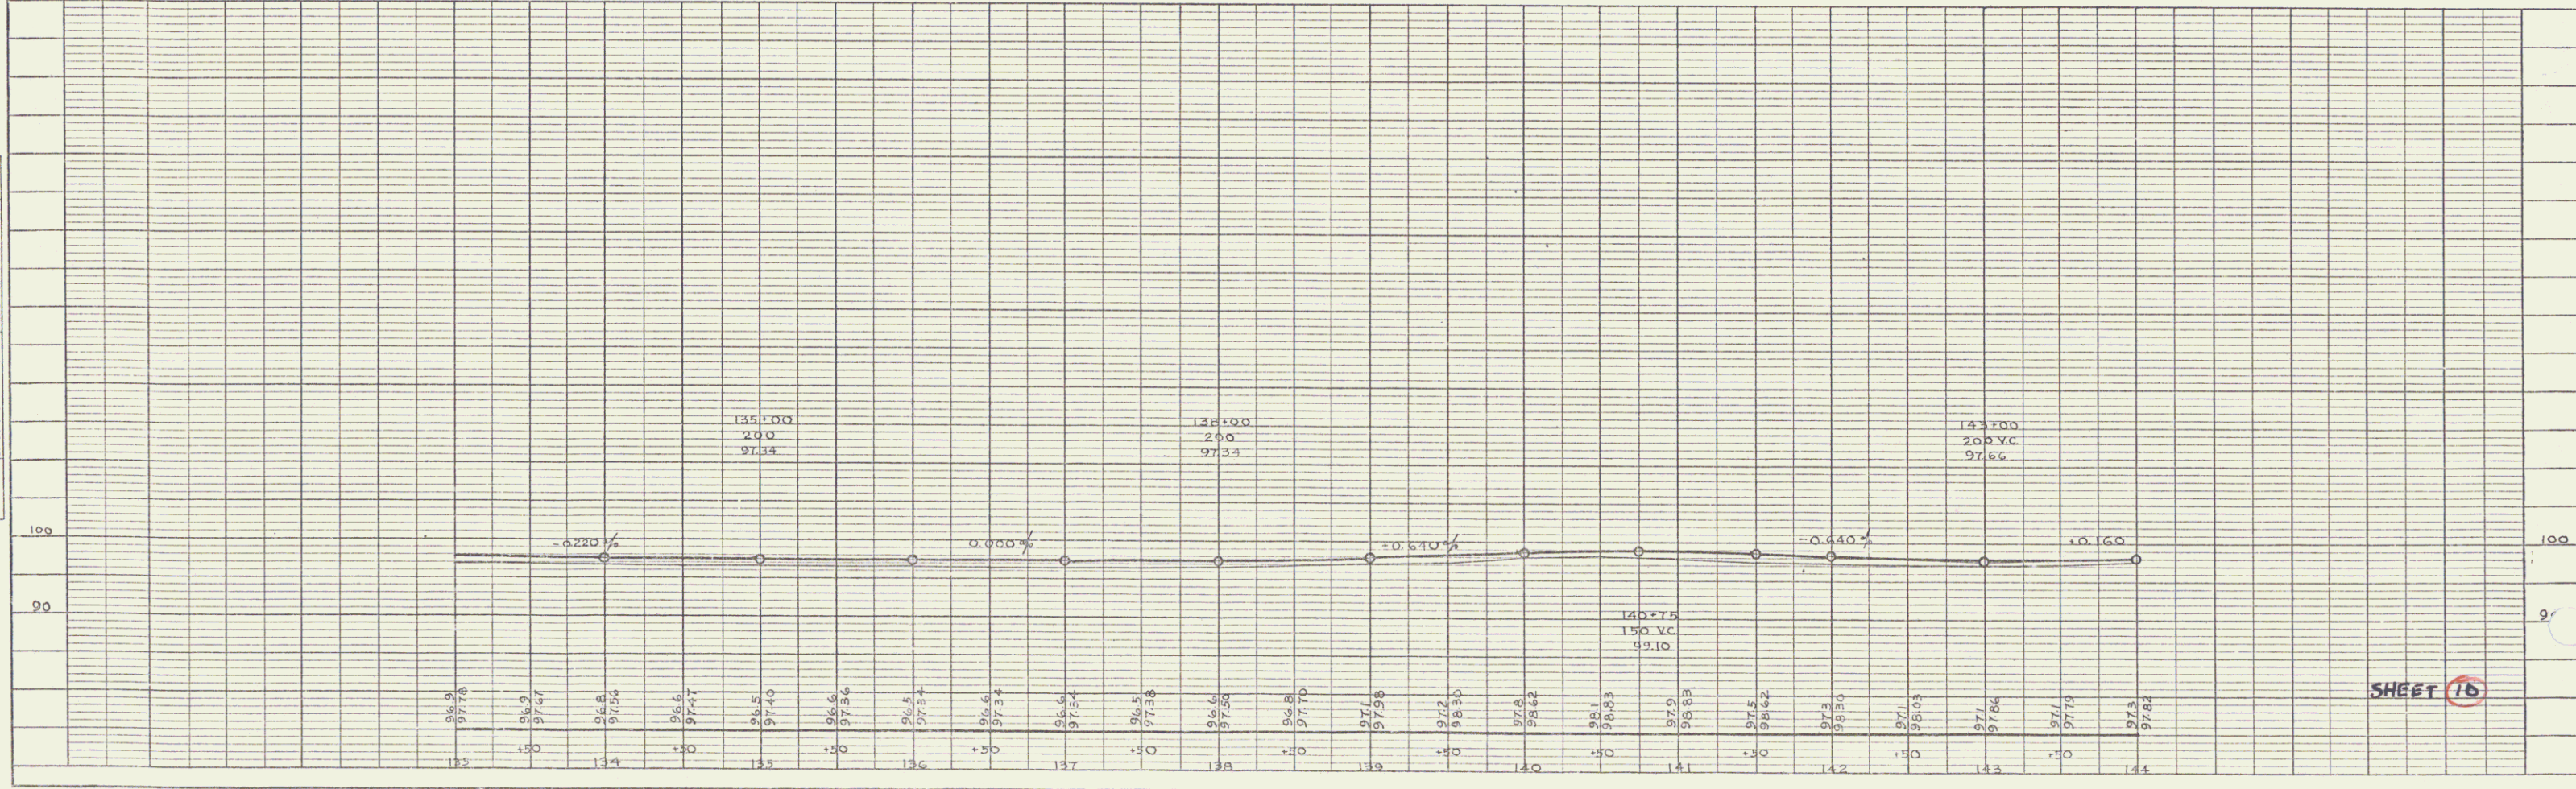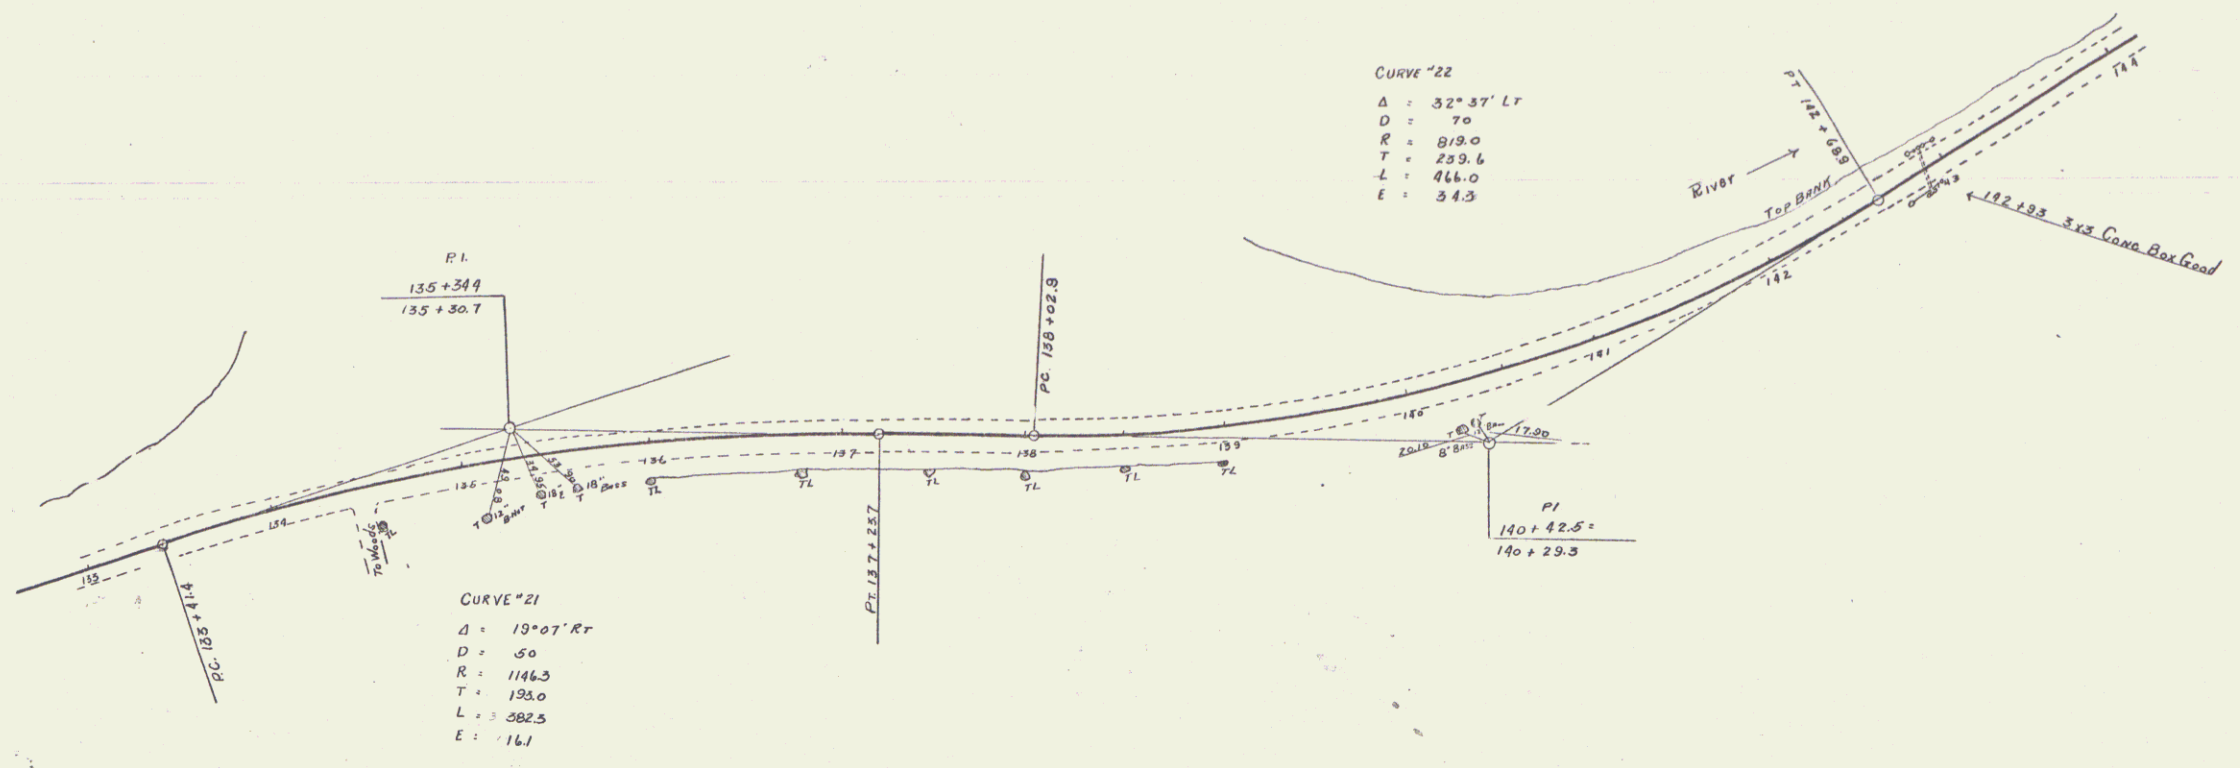

SHEET 16

Brandon S. S. S.



DATE	
BY	
PLAN	REVISIONS
	1. DATE
	2. DESCRIPTION
	3. CHECKED
	4. BY
	5. DATE
	6. BY
	7. DATE
	100. BY

DATE	
BY	
PROFILE	REVISIONS
	1. DATE
	2. DESCRIPTION
	3. CHECKED
	4. BY
	5. DATE
	6. BY
	7. DATE
	100. BY

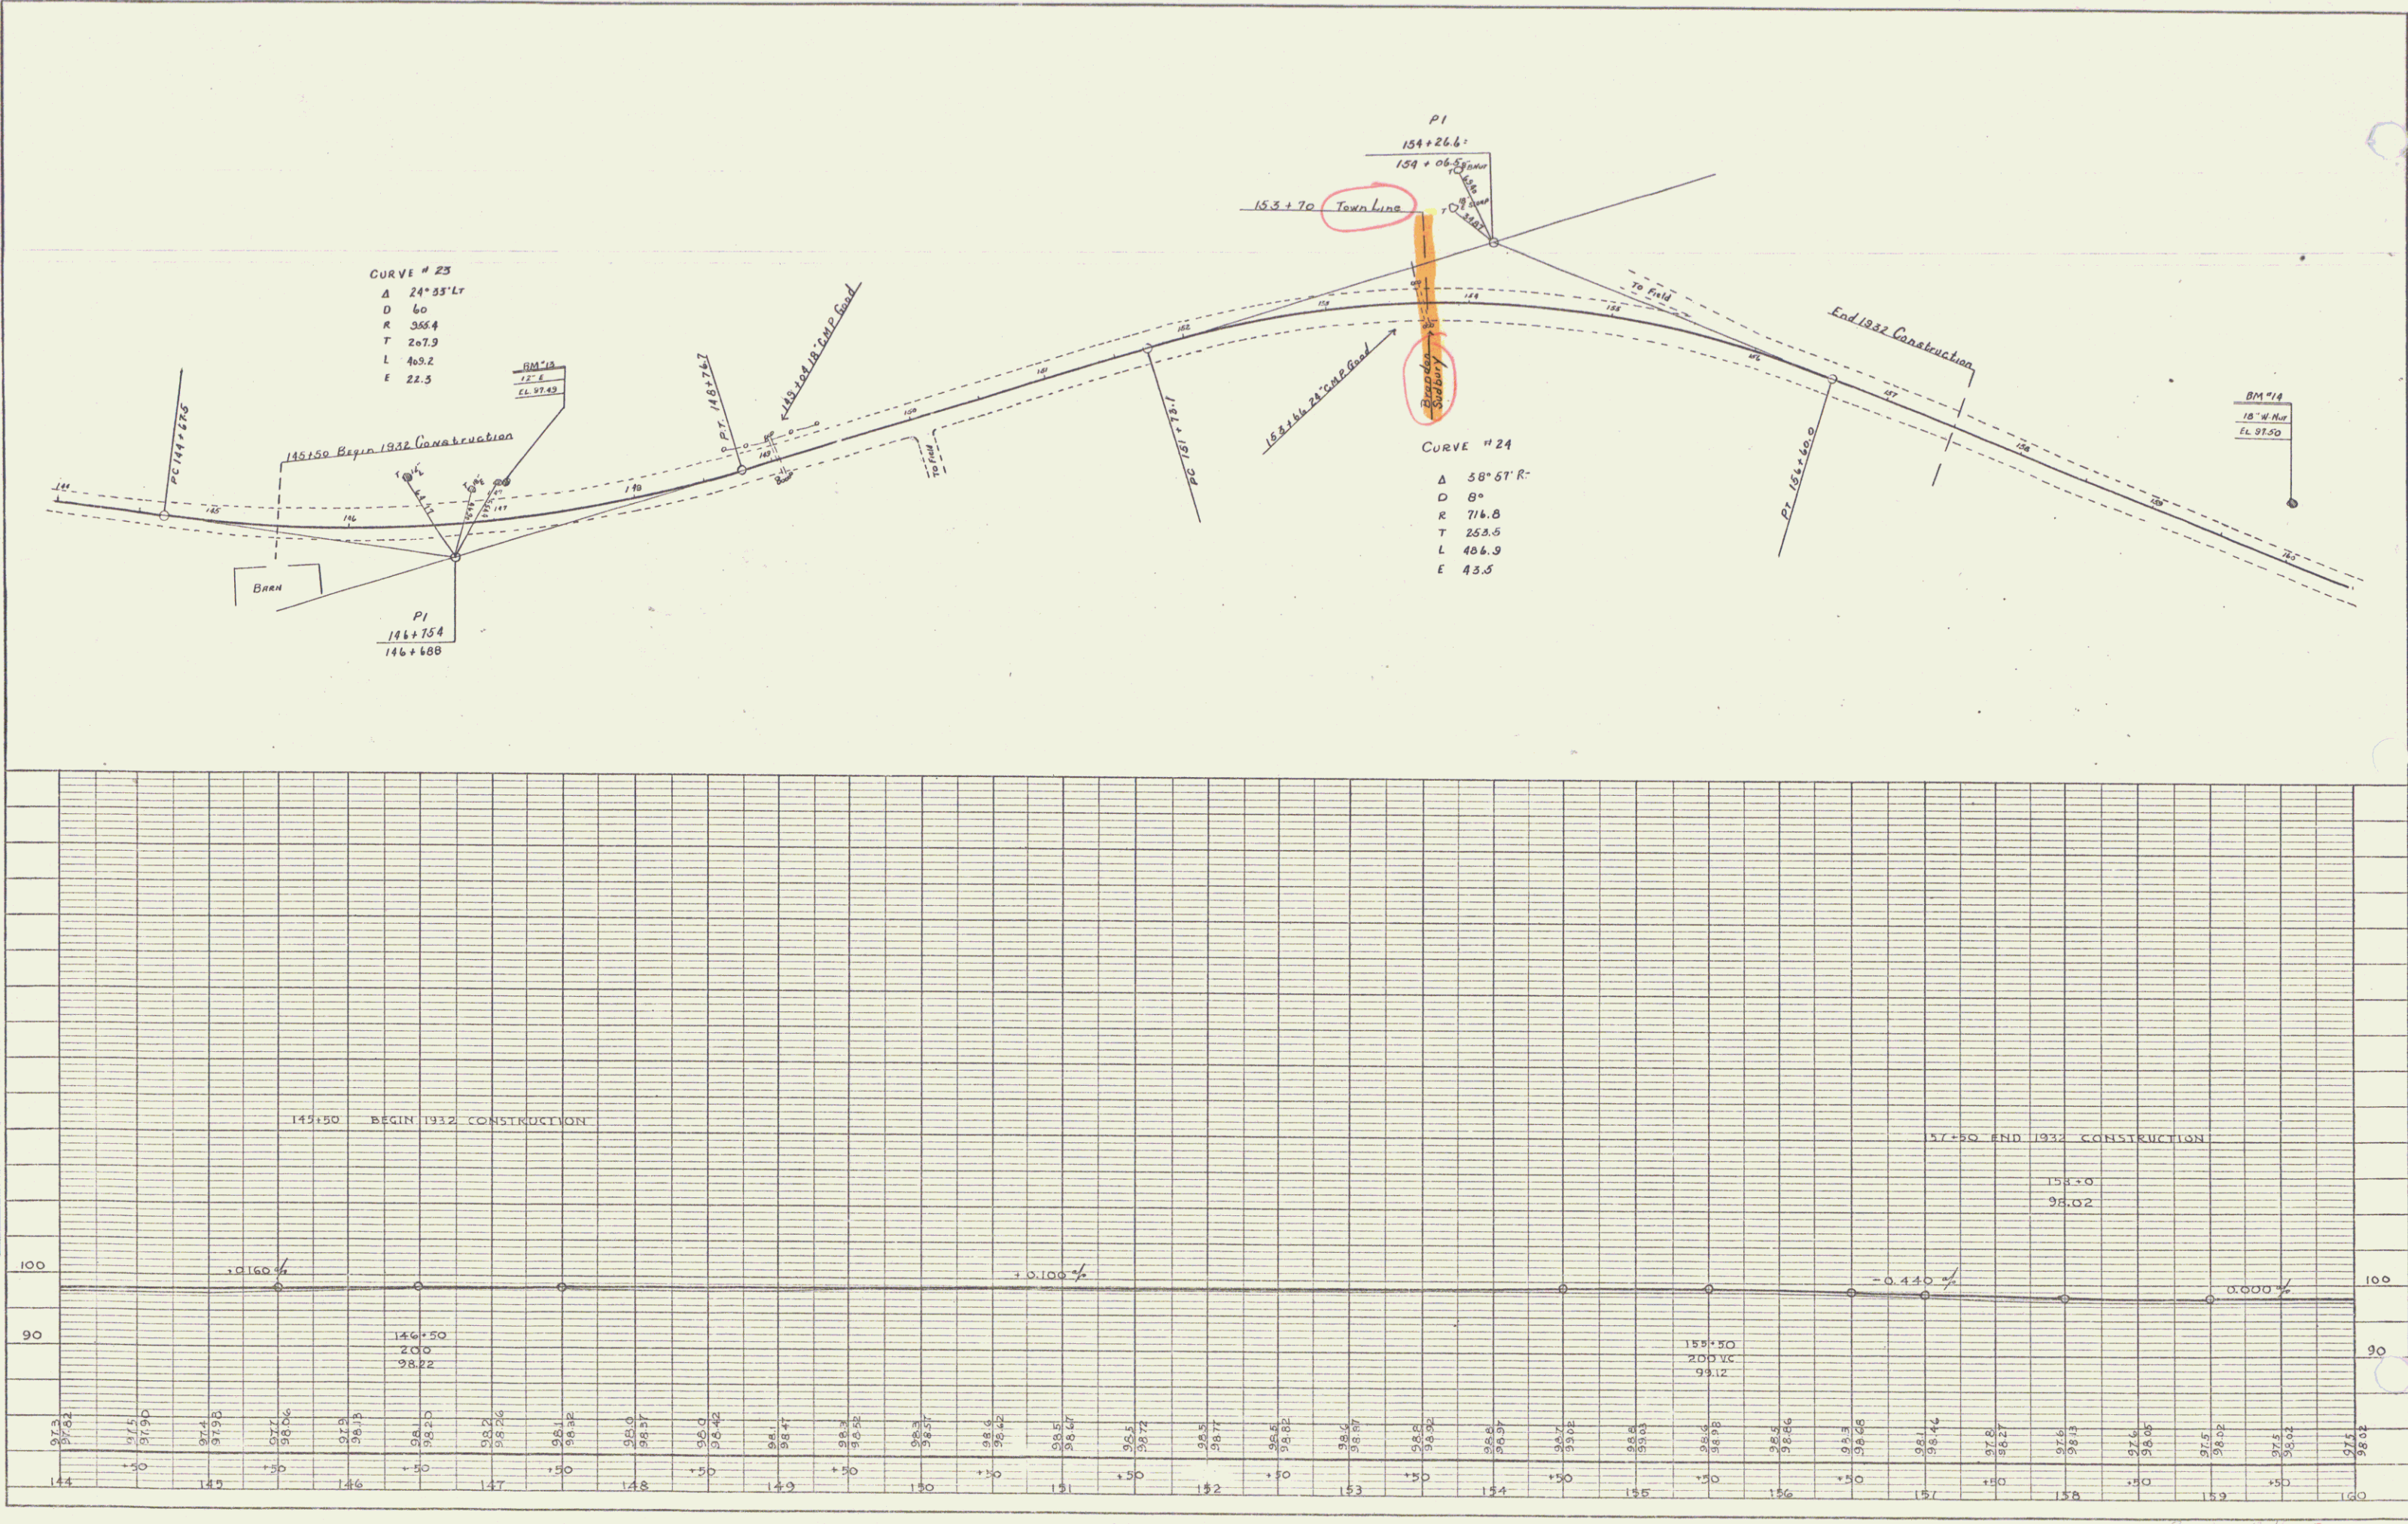


PLATE 1 - PLAN - PROFILE - P. P. & L. STATIONED  
 KUFFEL & LUDER CO. NEW YORK

PLAN  
 REVISIONS  
 NOTE BOOK  
 ALUMINUM CHECKED  
 RE. OF W.M. CHECKED  
 NO.

PROFILE  
 REVISIONS  
 NOTE BOOK  
 CHECKED  
 R. W. NOTED  
 REVISIONS  
 NO.

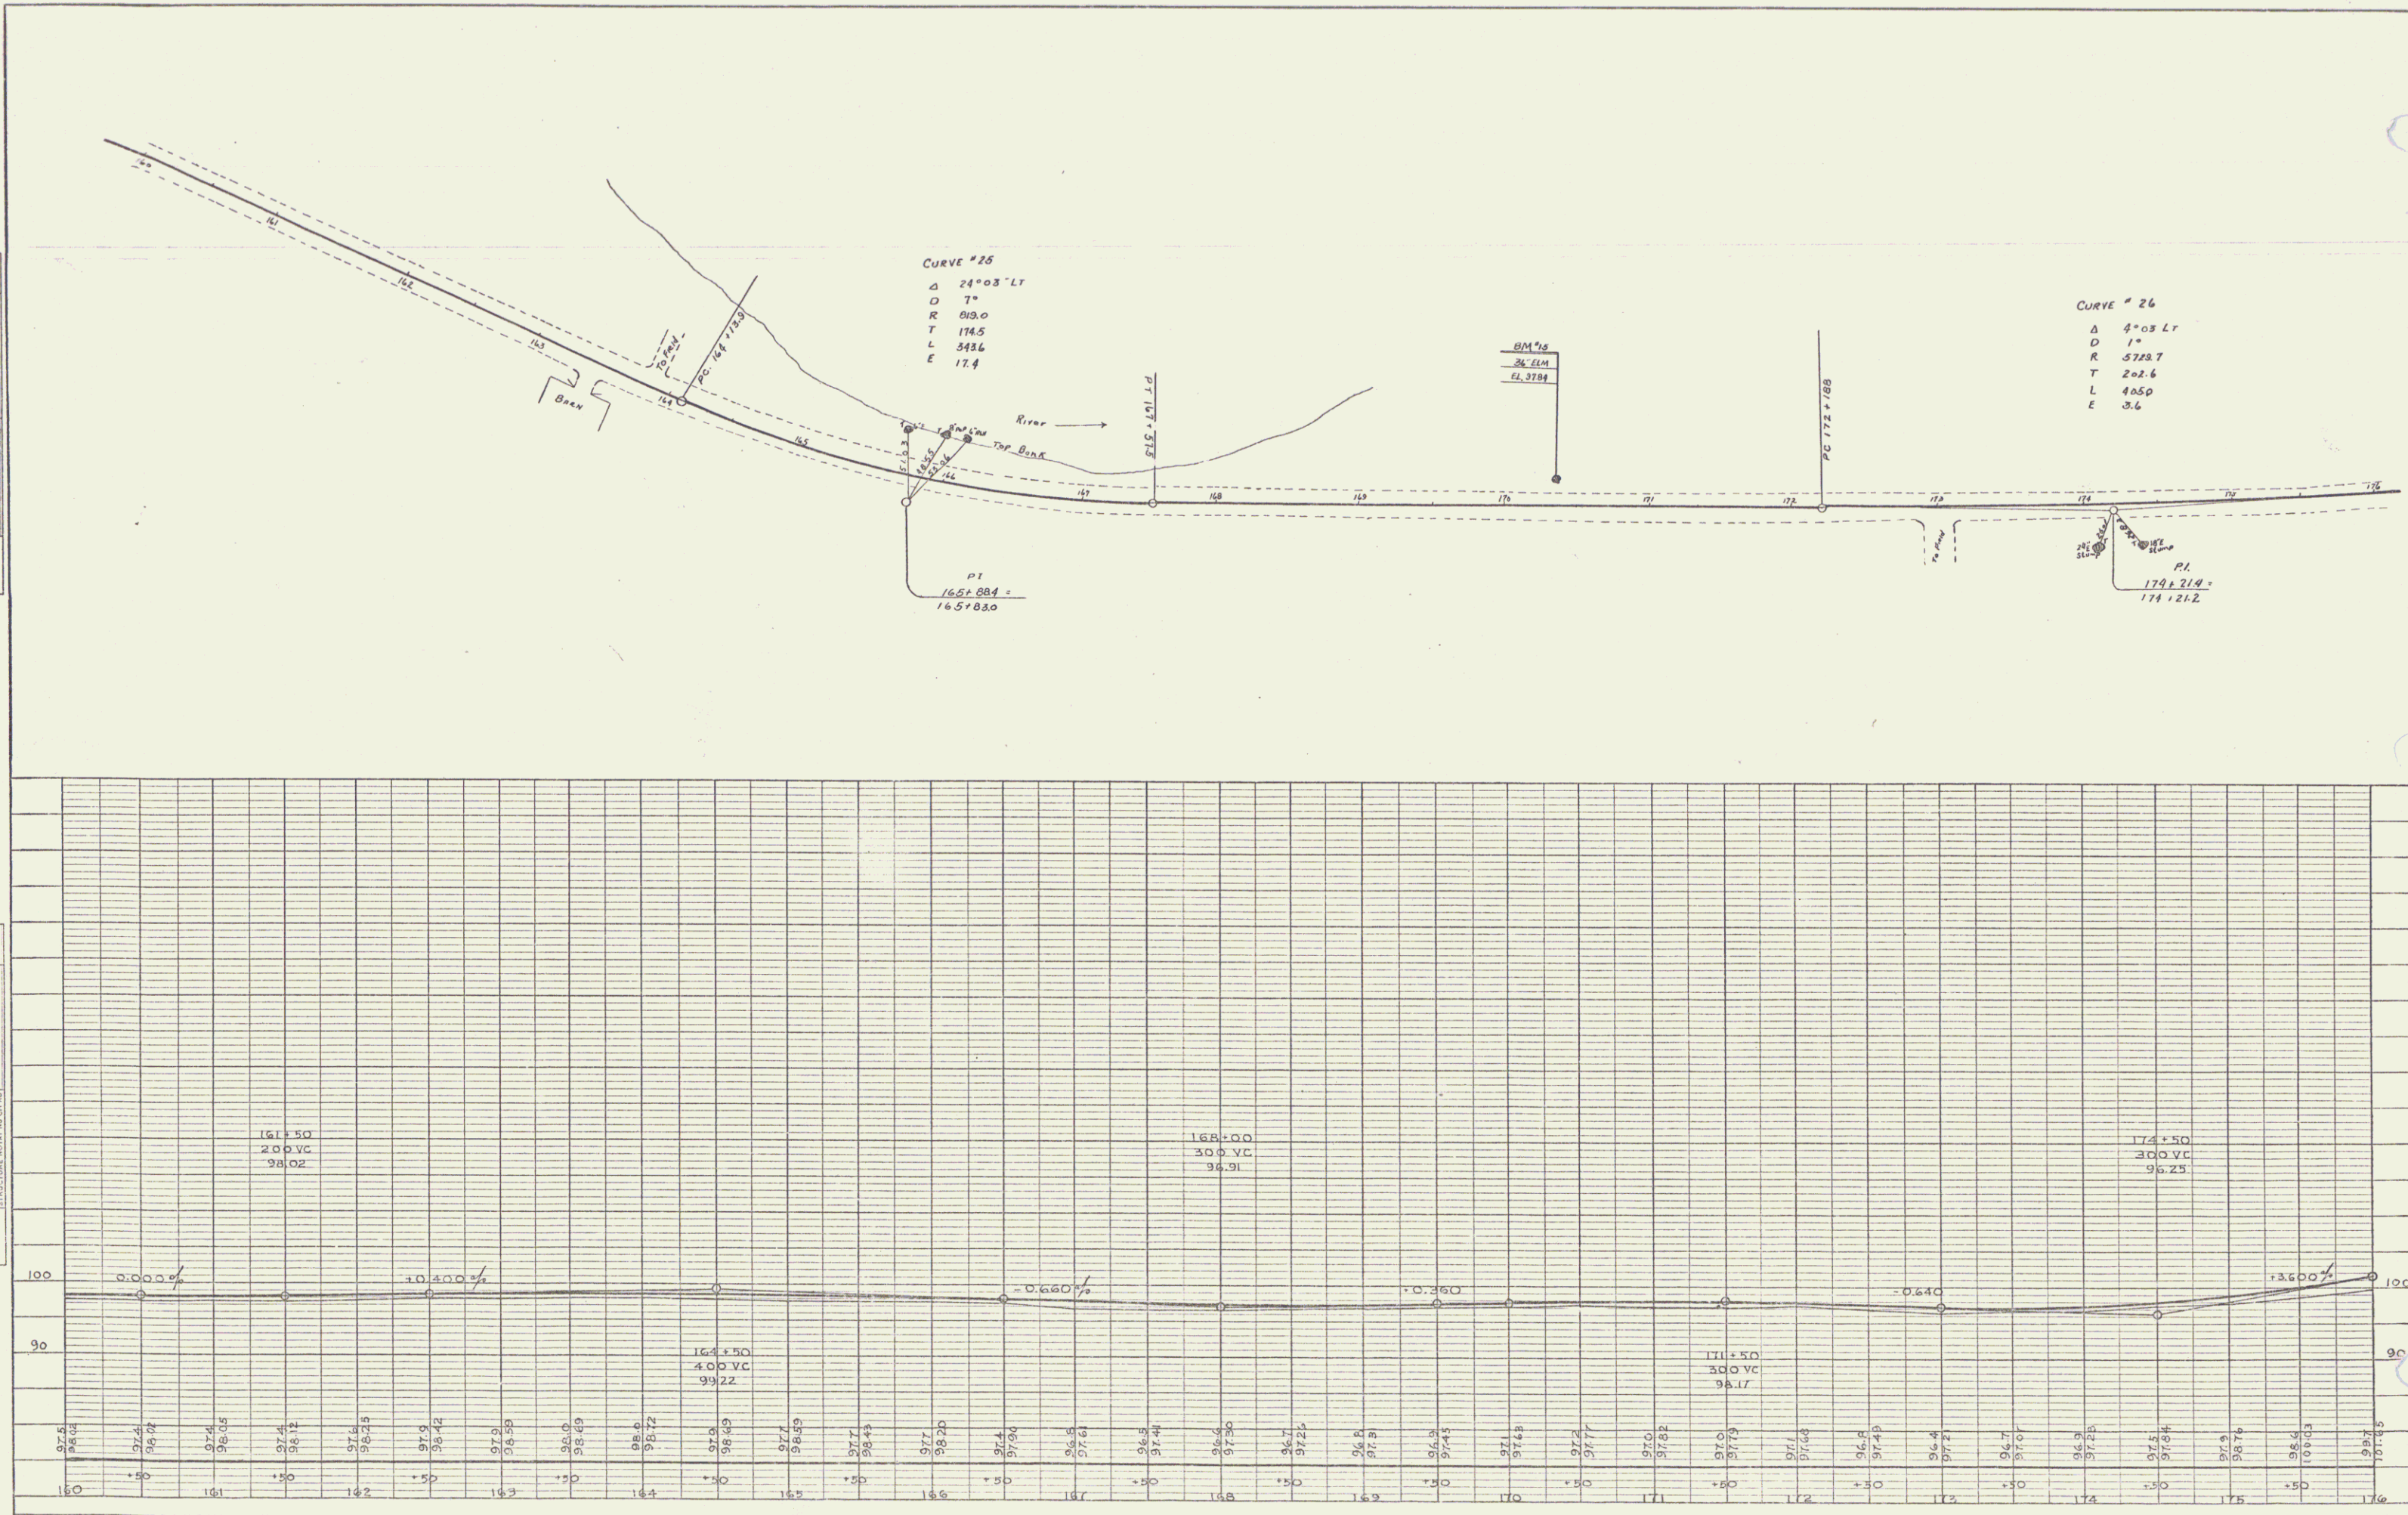


PLATE I - PLAN - PROFILE - P. & A. E. STANDARD  
 NEW YORK

SHEET 12

13

PLAN  
 DATE: \_\_\_\_\_ BY: \_\_\_\_\_  
 PROJECT: \_\_\_\_\_  
 NOTE BOOK: \_\_\_\_\_  
 HT. OF PIV. POINT: \_\_\_\_\_  
 NO. \_\_\_\_\_

PROFILE  
 DATE: \_\_\_\_\_ BY: \_\_\_\_\_  
 PROJECT: \_\_\_\_\_  
 NOTE BOOK: \_\_\_\_\_  
 HT. OF PIV. POINT: \_\_\_\_\_  
 NO. \_\_\_\_\_


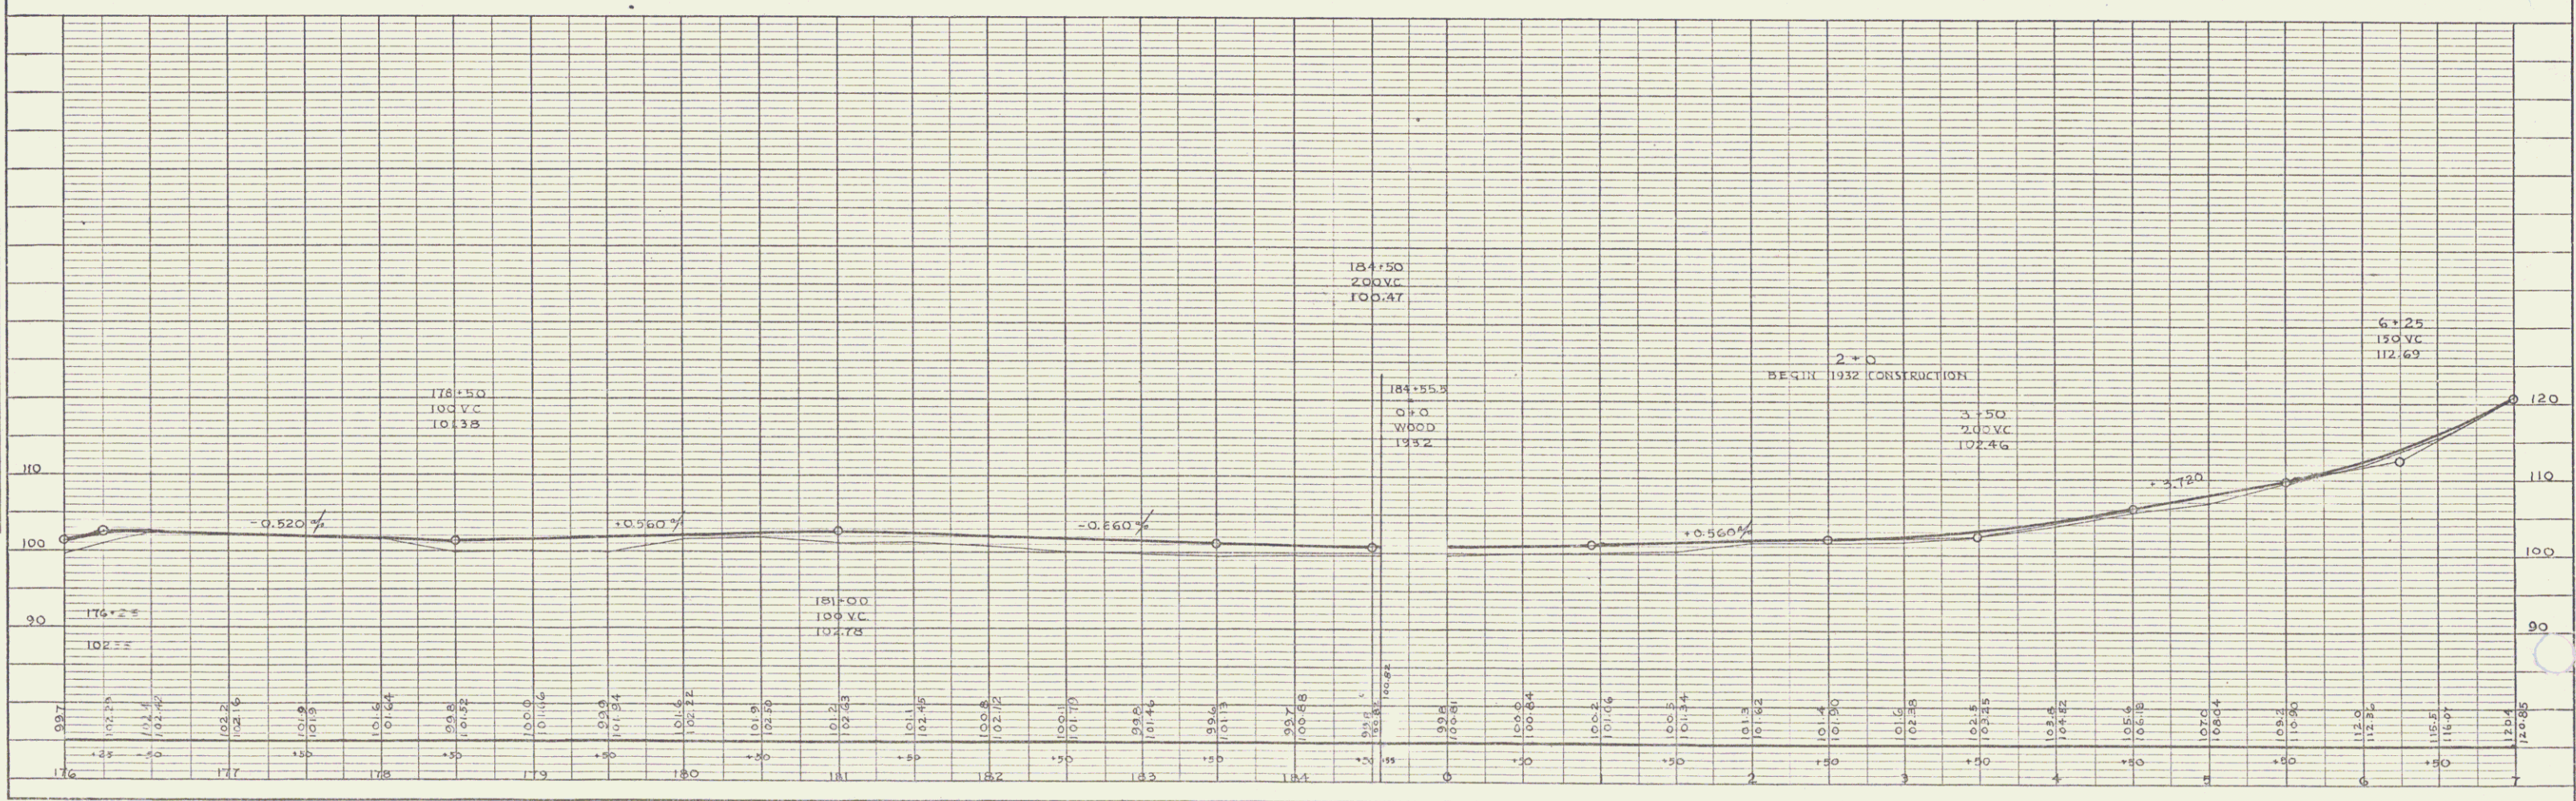



PLATE 1-PLAN-PROFILE © P. A. & L. STUBBS  
 KEUFFEL & ESSER CO. NEW YORK

SHEET 13  
 H

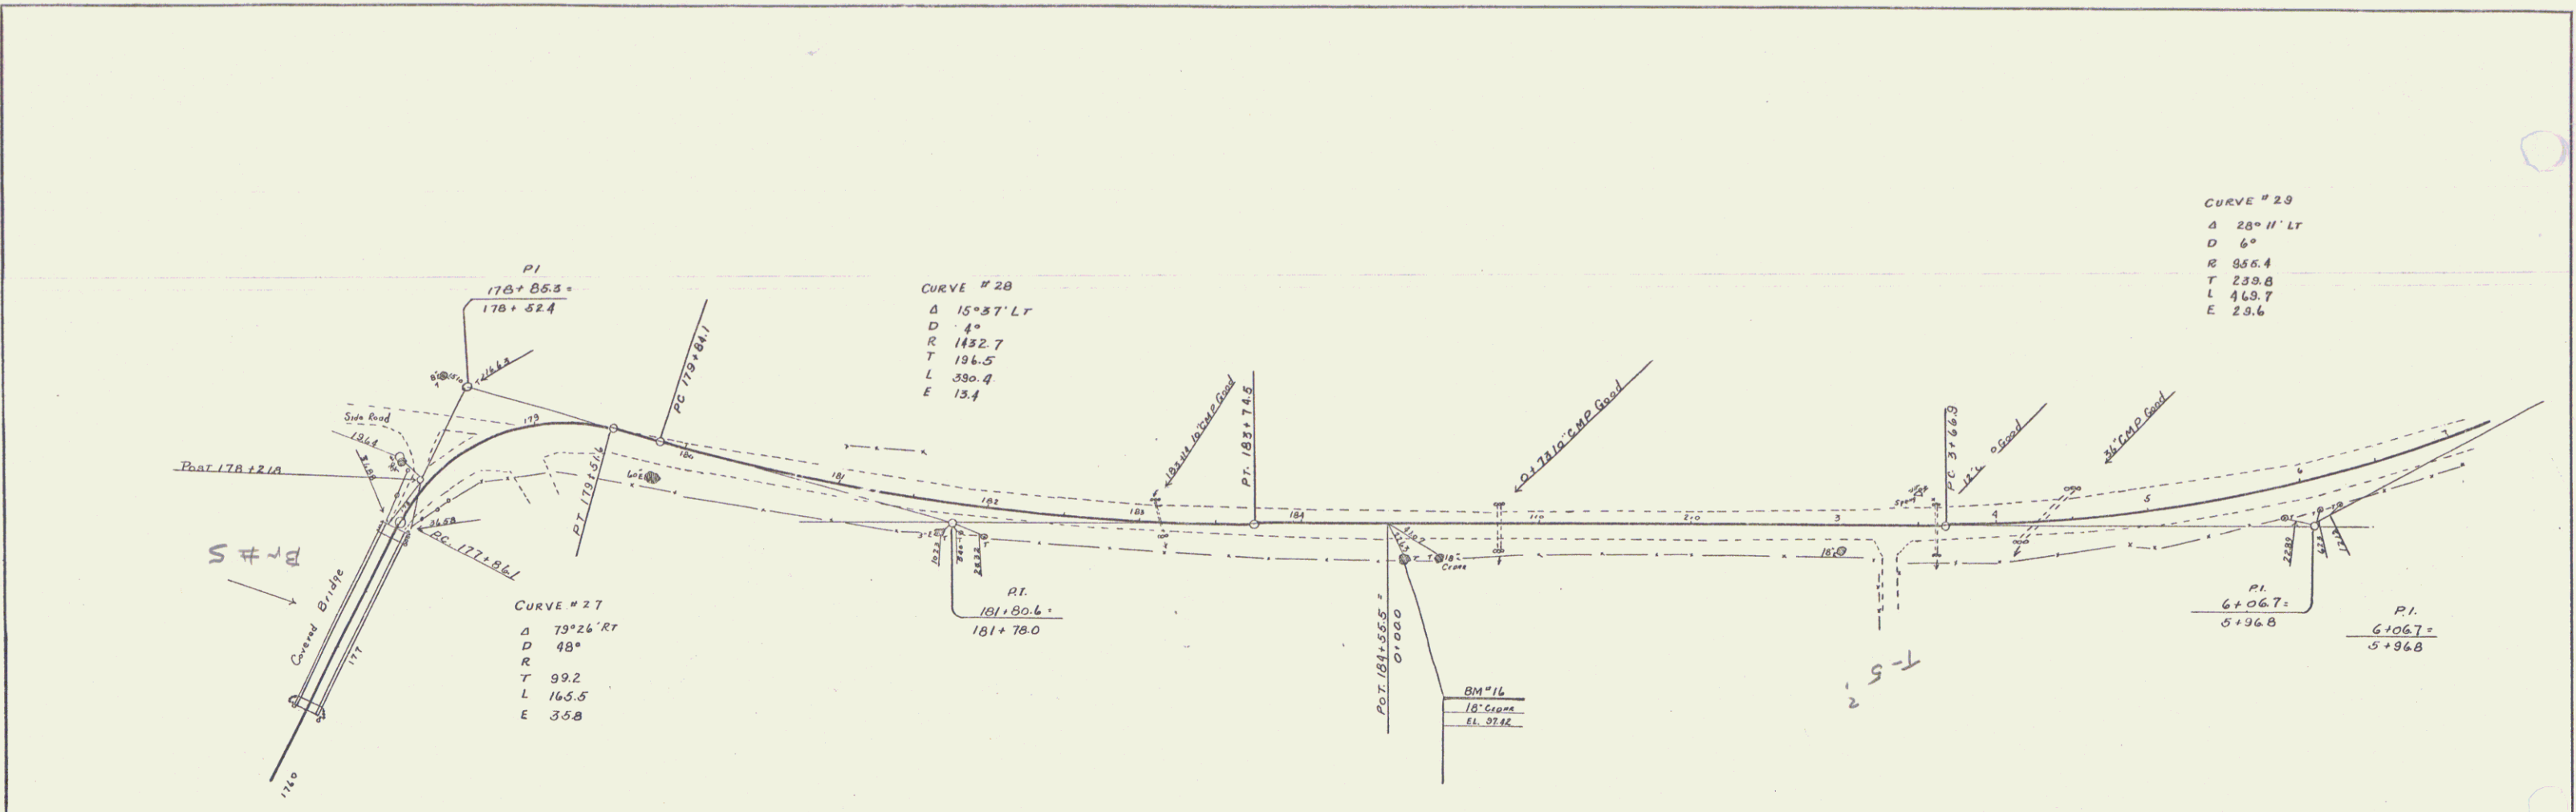

PLAN  
 DATE: \_\_\_\_\_  
 BY: \_\_\_\_\_  
 PROJECT: \_\_\_\_\_  
 SHEET NO.: \_\_\_\_\_  
 OF \_\_\_\_\_

PROFILE  
 DATE: \_\_\_\_\_  
 BY: \_\_\_\_\_  
 PROJECT: \_\_\_\_\_  
 SHEET NO.: \_\_\_\_\_  
 OF \_\_\_\_\_

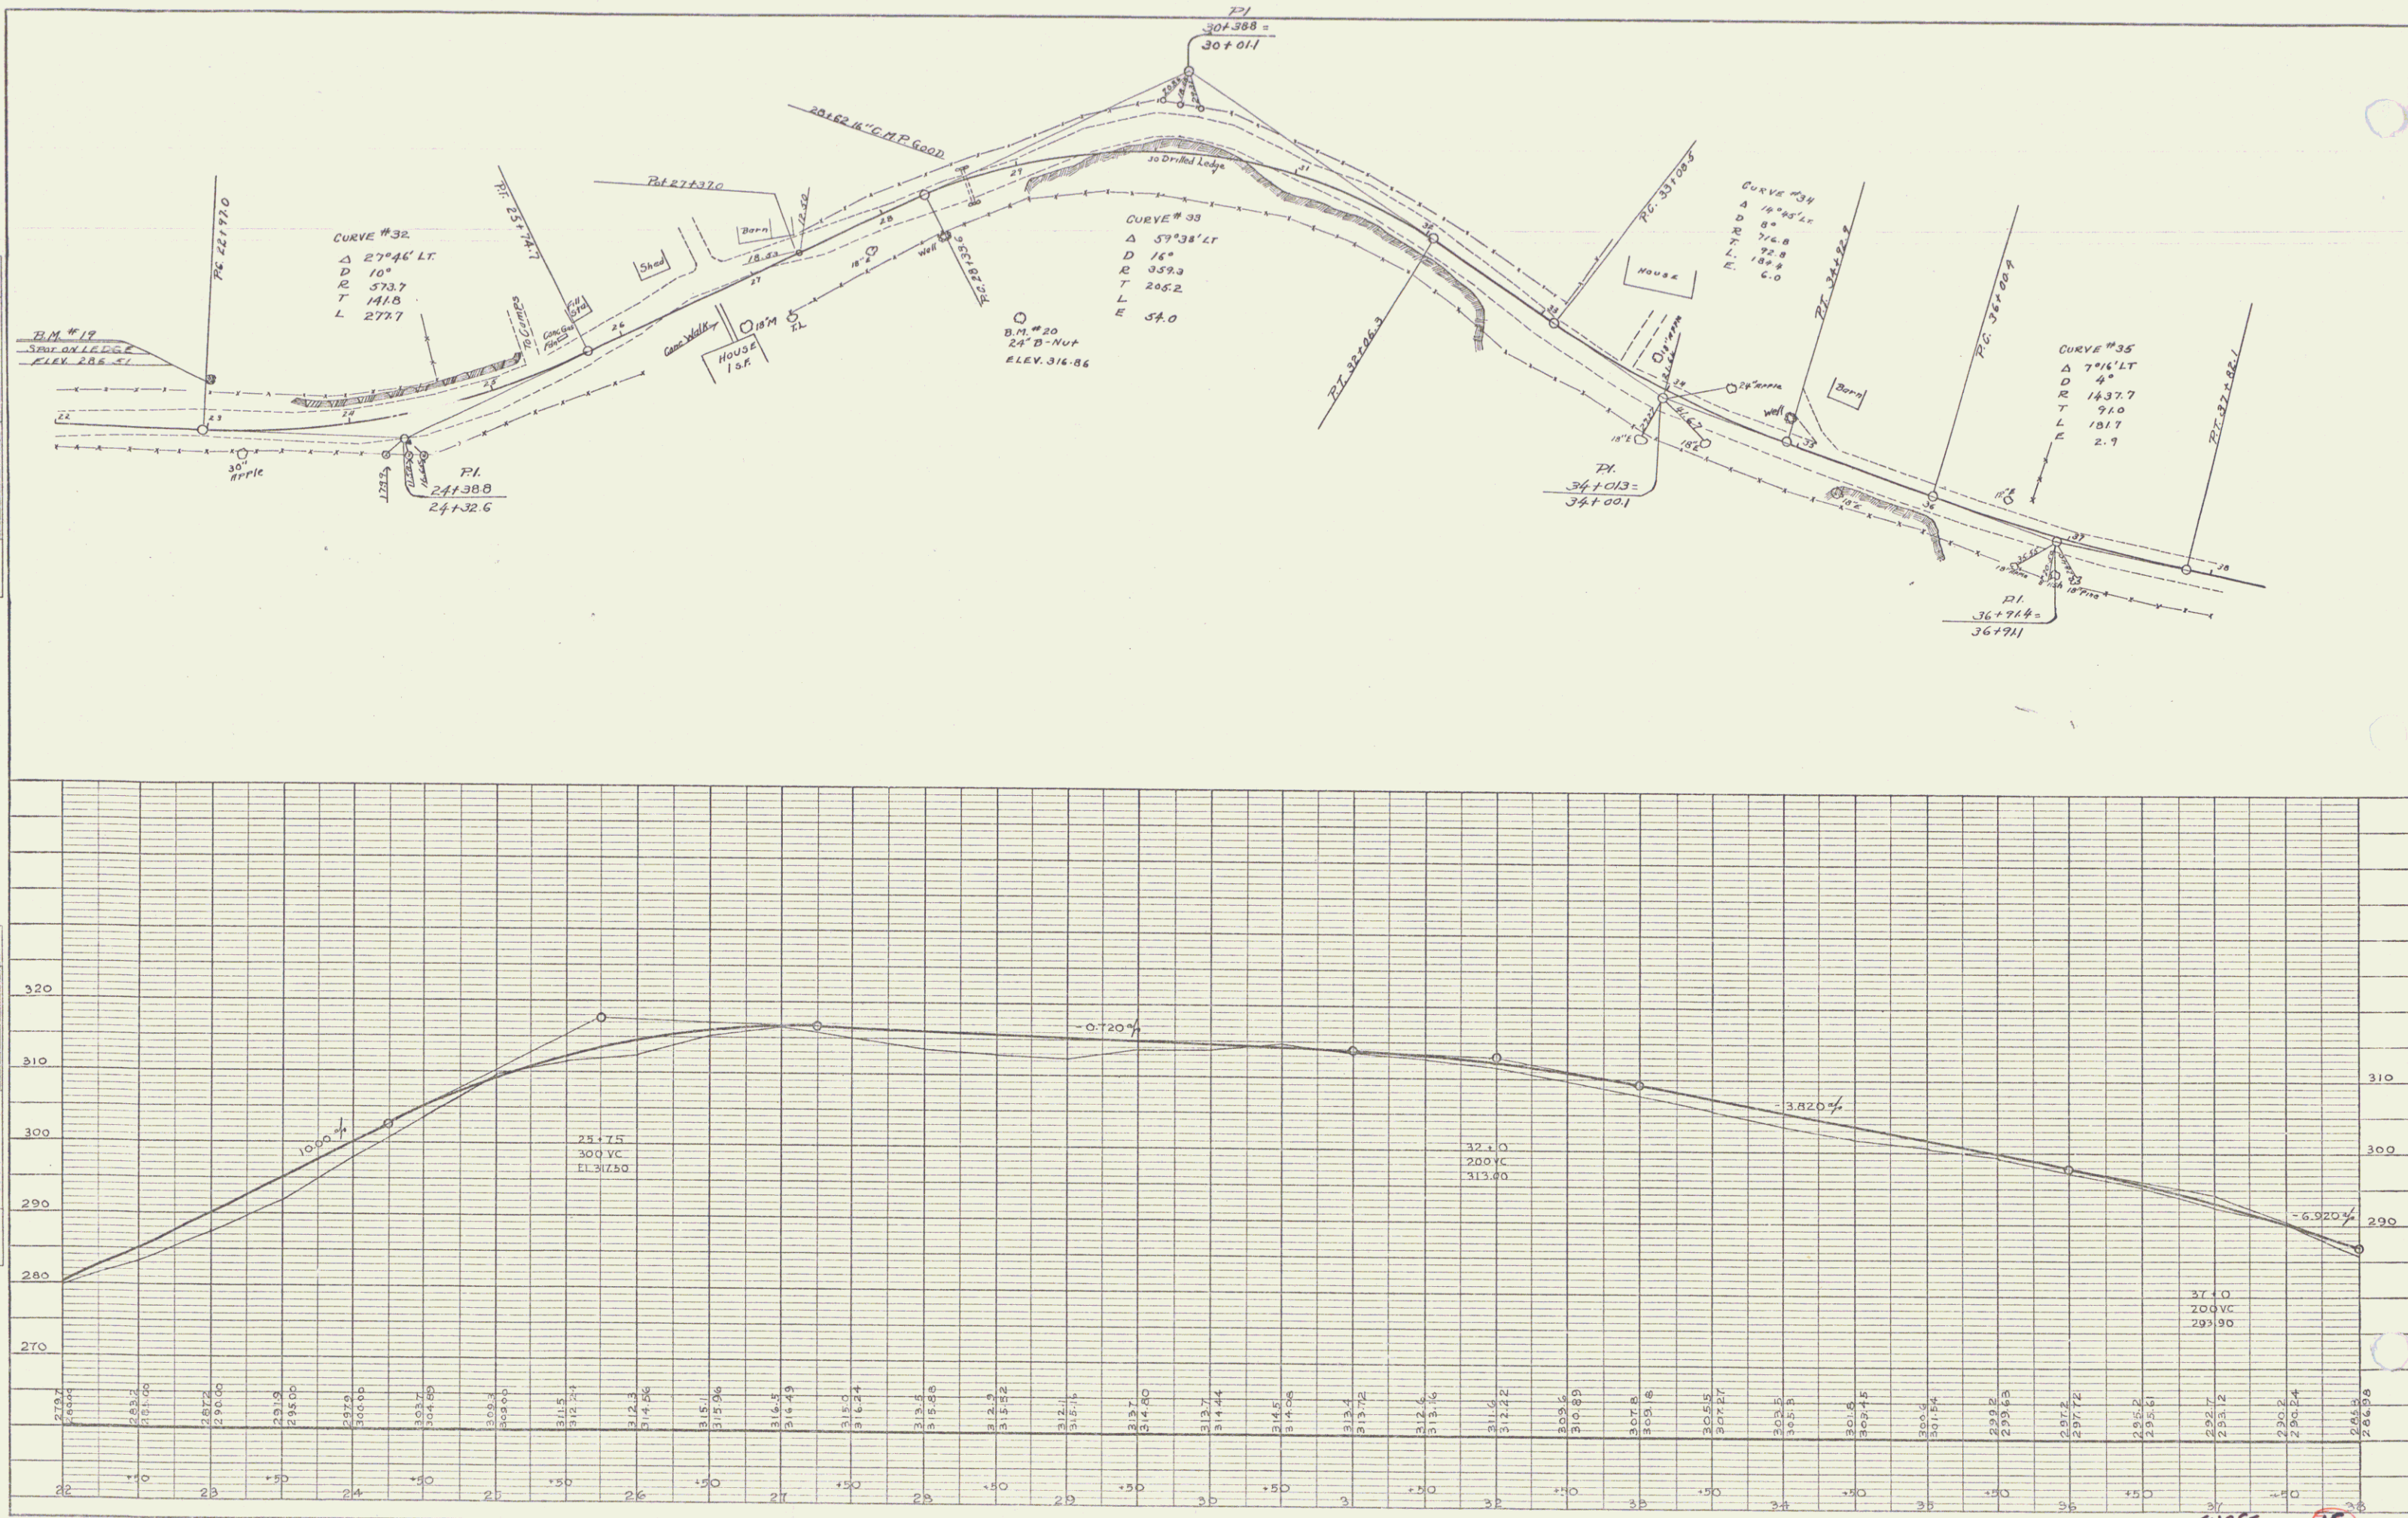



DATE	
BY	
PLAN	AS SHOWN
NOTE BOOK	AS SHOWN
NO.	

DATE	
BY	
PROFILE	AS SHOWN
NOTE BOOK	AS SHOWN
NO.	


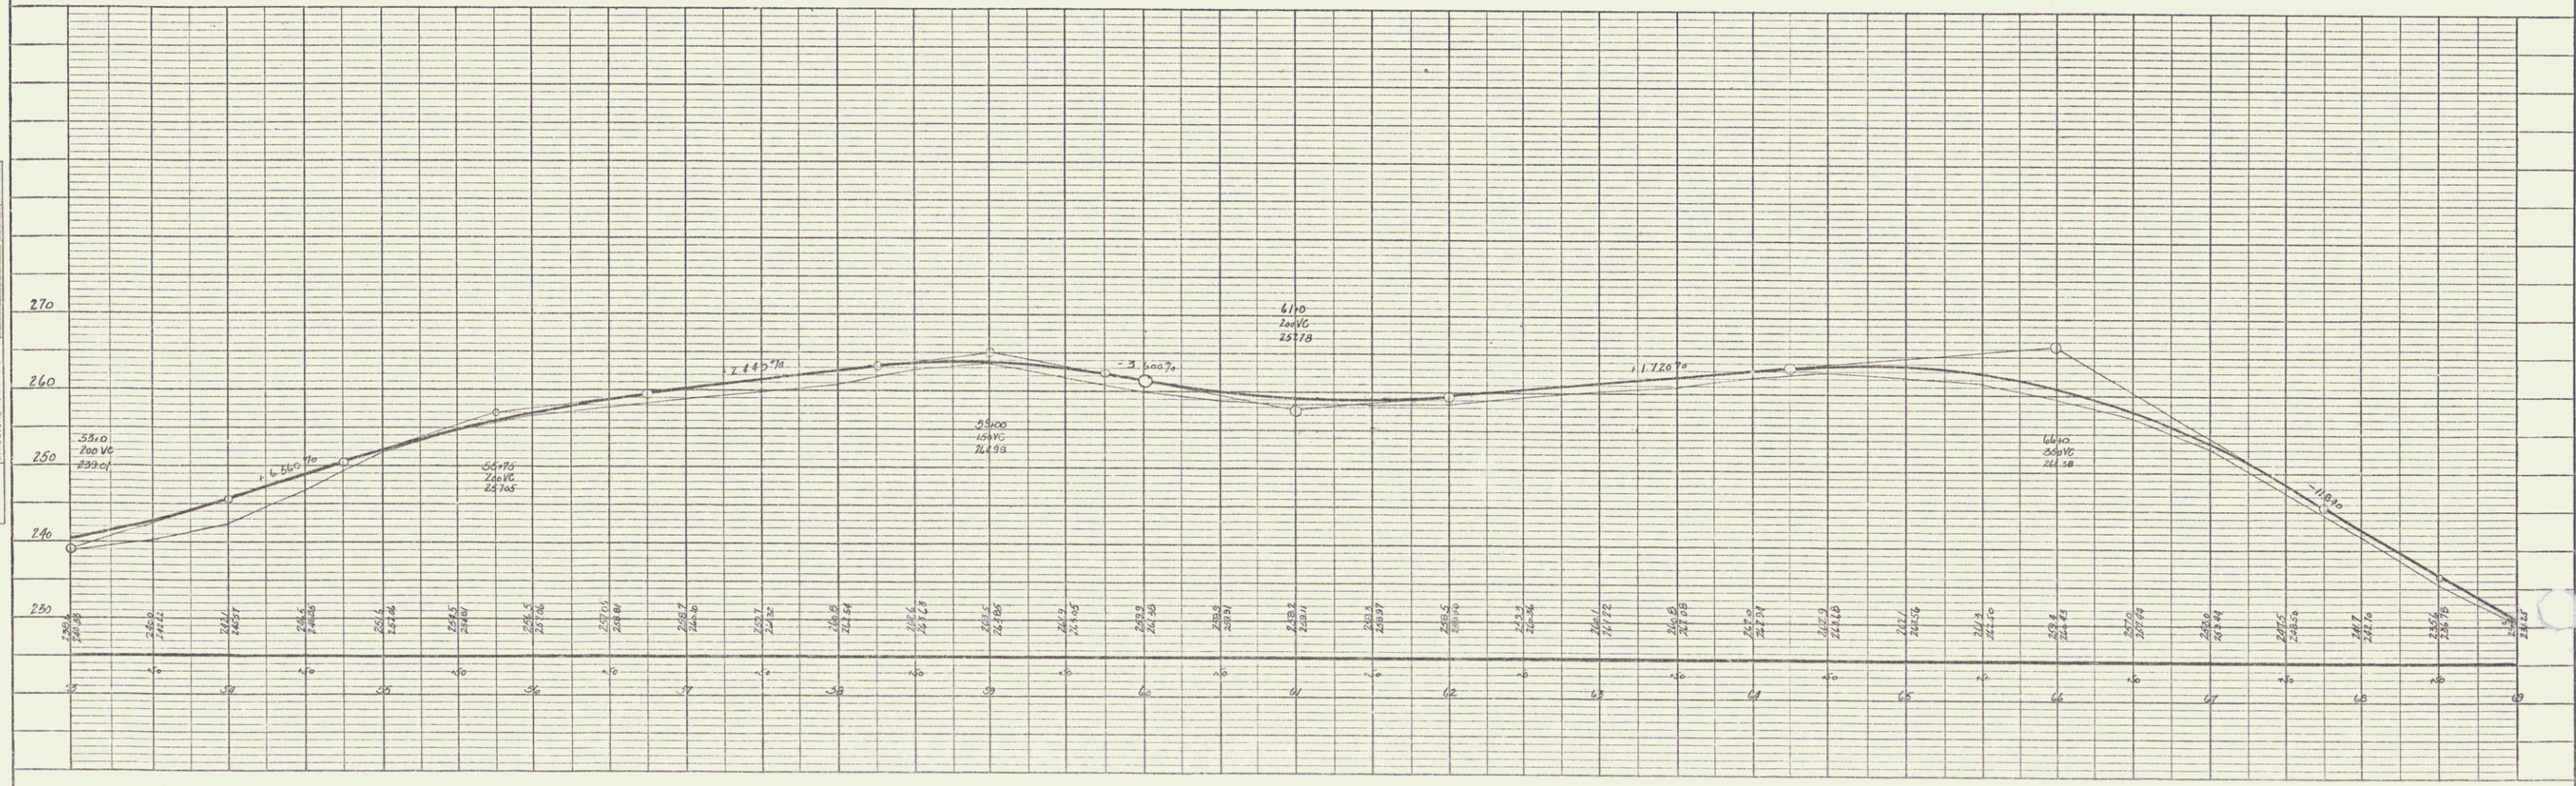


PLATE 1—PLAN—PROFILE © P. A. & S. STANDARD  
KUPFFER & EIDER CO. NEW YORK



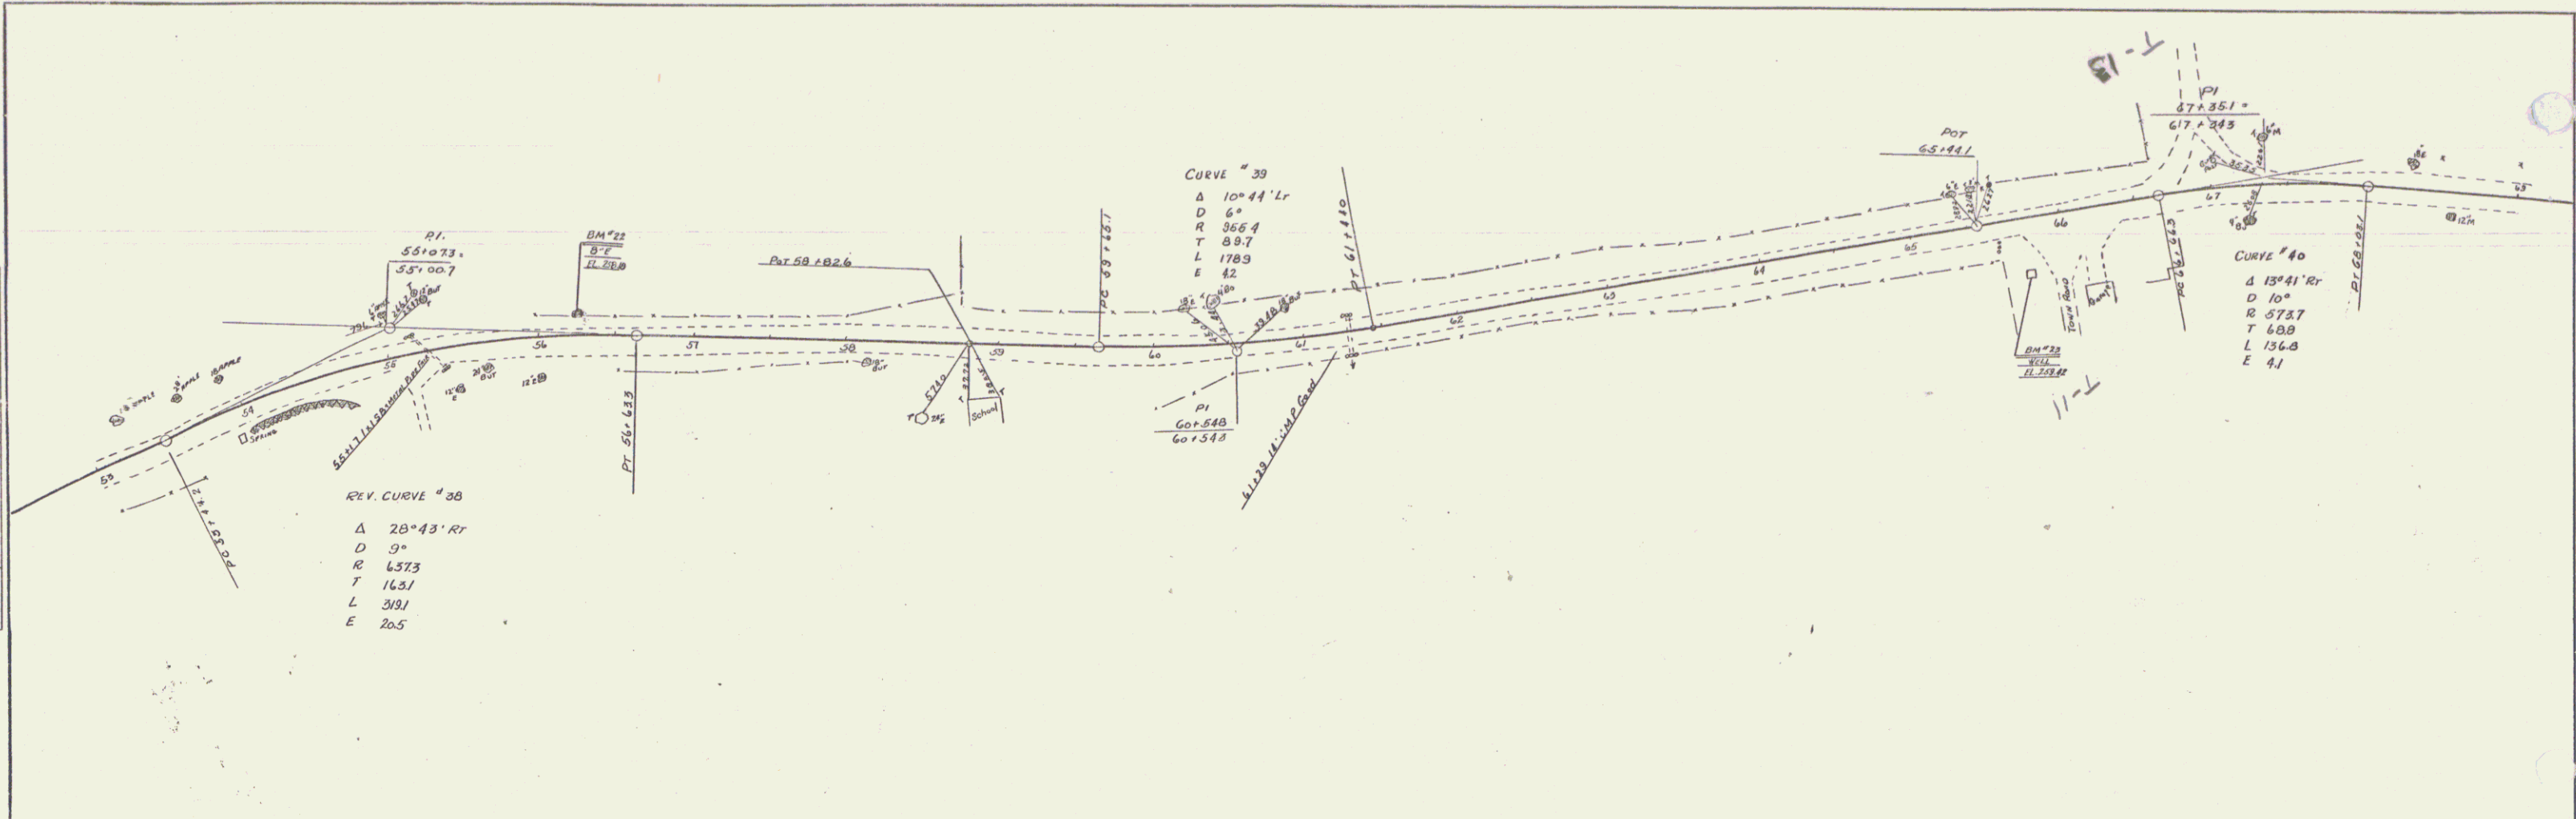

DATE: \_\_\_\_\_  
 BY: \_\_\_\_\_  
 PLAN: REVISIONS: \_\_\_\_\_  
 NOTE BOOK: \_\_\_\_\_  
 GRADE CHECKED: \_\_\_\_\_  
 BY: \_\_\_\_\_  
 DATE: \_\_\_\_\_  
 REVISIONS: \_\_\_\_\_

DATE: \_\_\_\_\_  
 BY: \_\_\_\_\_  
 PROFILE: REVISIONS: \_\_\_\_\_  
 NOTE BOOK: \_\_\_\_\_  
 GRADE CHECKED: \_\_\_\_\_  
 BY: \_\_\_\_\_  
 DATE: \_\_\_\_\_  
 REVISIONS: \_\_\_\_\_


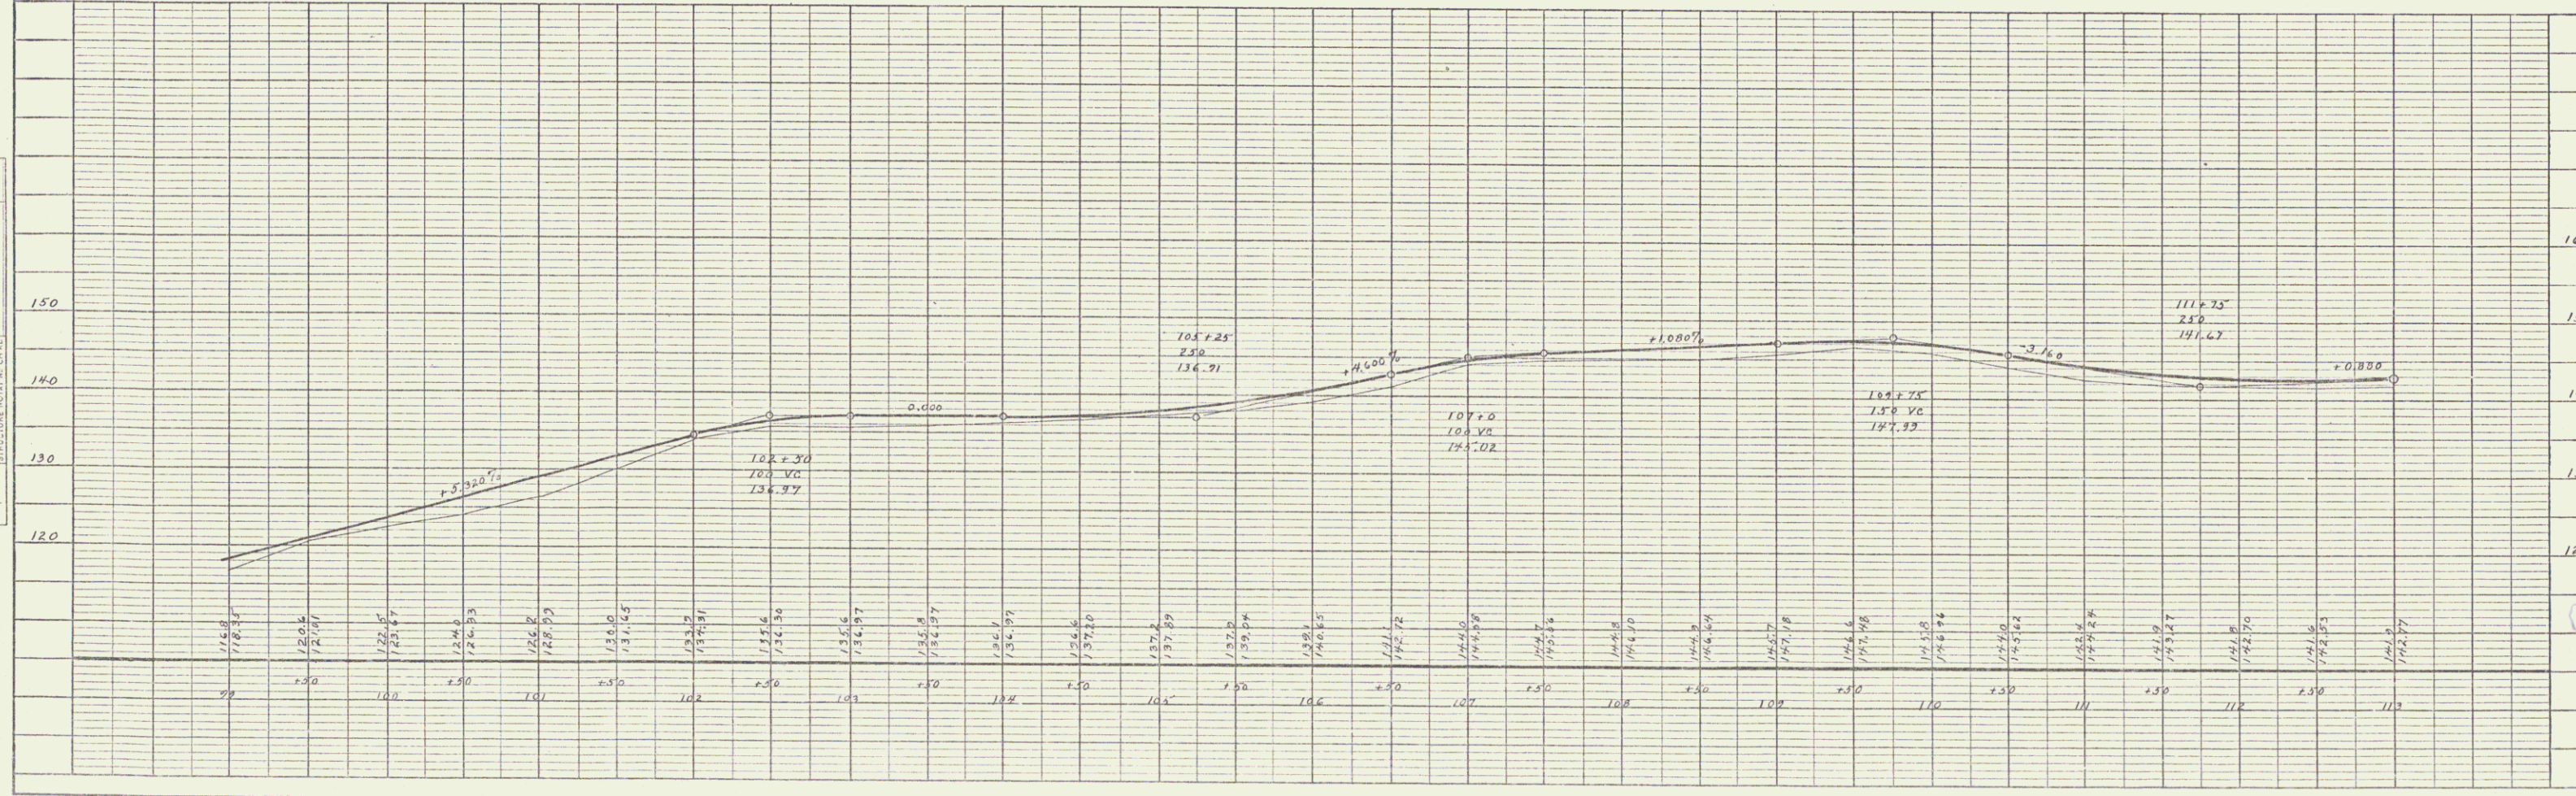


PLATE 1-PLAN-PROFILE C. P. & L. STANDARD  
 REEFER & SUGER CO. NEW YORK

PLAN  
 DATE: \_\_\_\_\_  
 BY: \_\_\_\_\_  
 CHECKED: \_\_\_\_\_  
 APPROVED: \_\_\_\_\_  
 TITLE: \_\_\_\_\_  
 PROJECT: \_\_\_\_\_  
 SHEET NO.: \_\_\_\_\_

PROFILE  
 DATE: \_\_\_\_\_  
 BY: \_\_\_\_\_  
 CHECKED: \_\_\_\_\_  
 APPROVED: \_\_\_\_\_  
 TITLE: \_\_\_\_\_  
 PROJECT: \_\_\_\_\_  
 SHEET NO.: \_\_\_\_\_

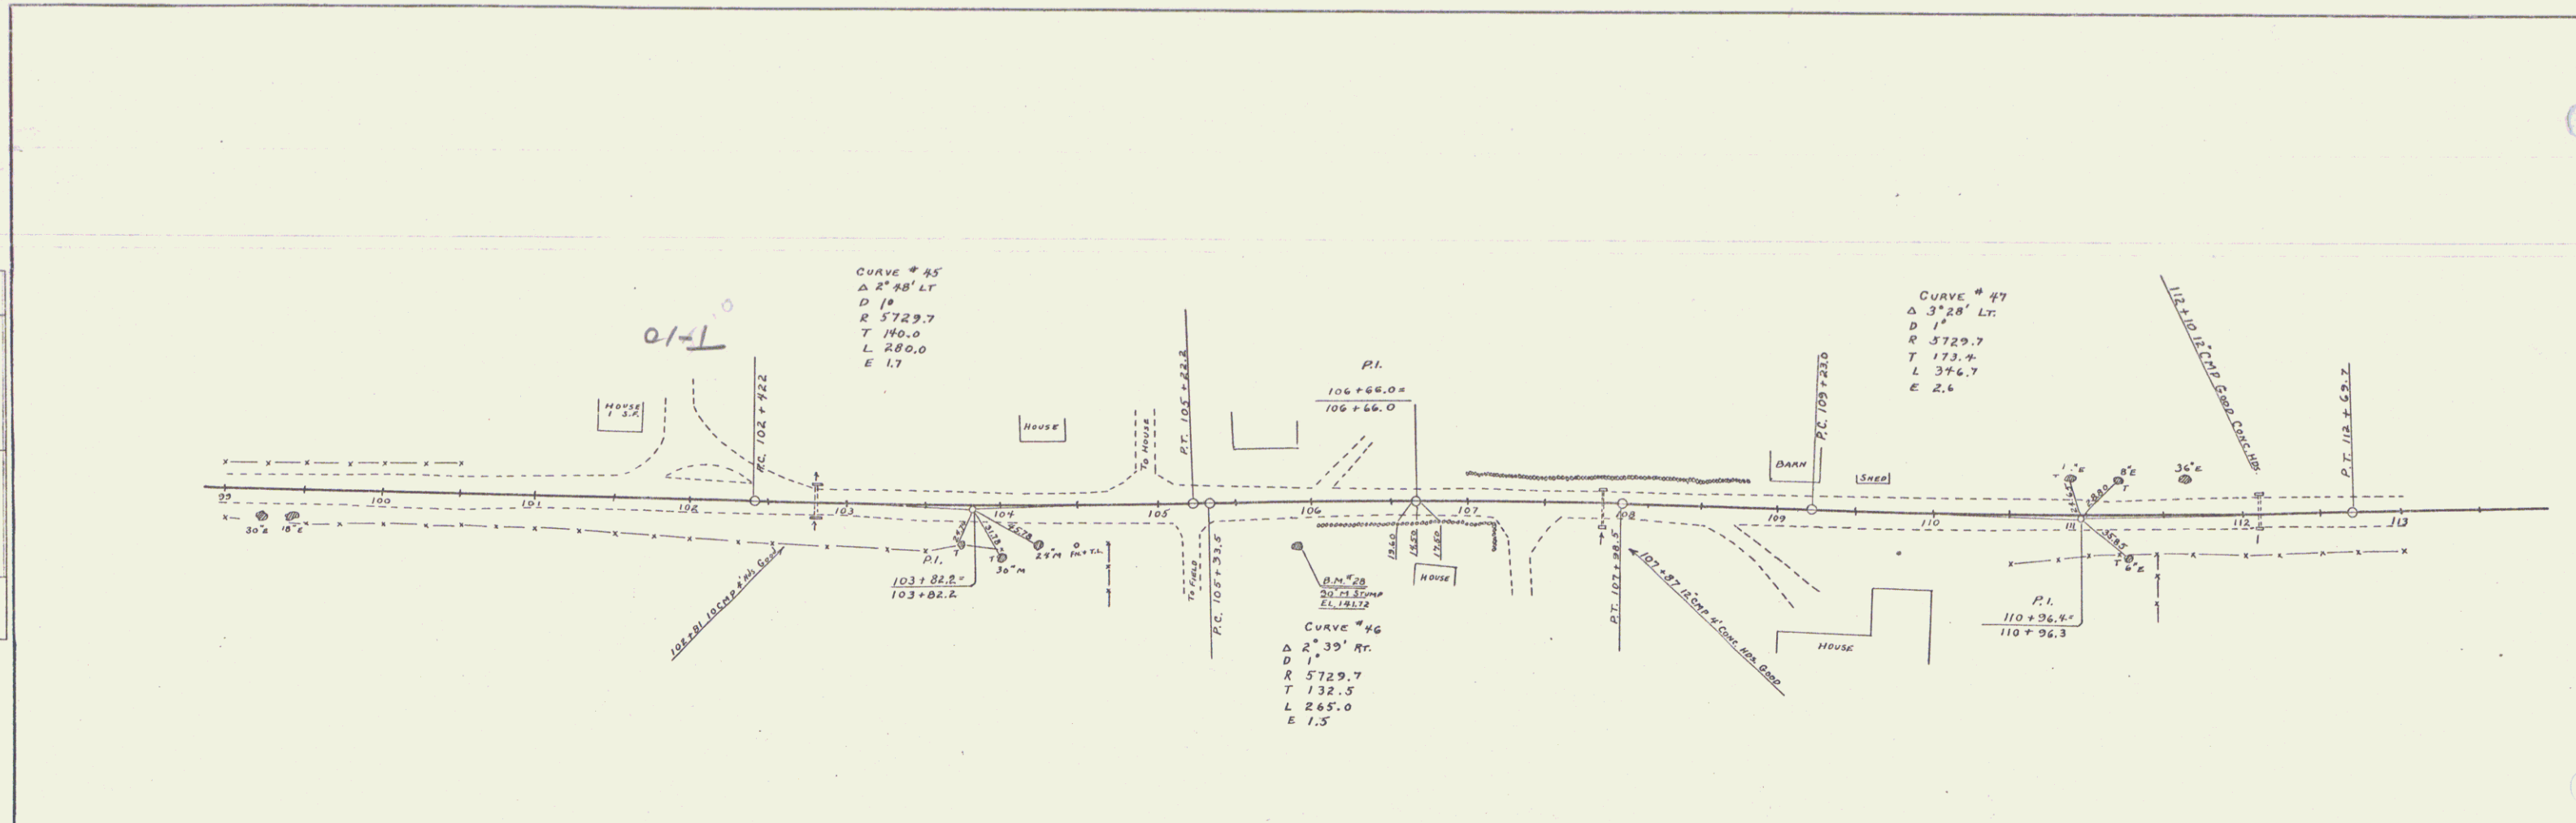