
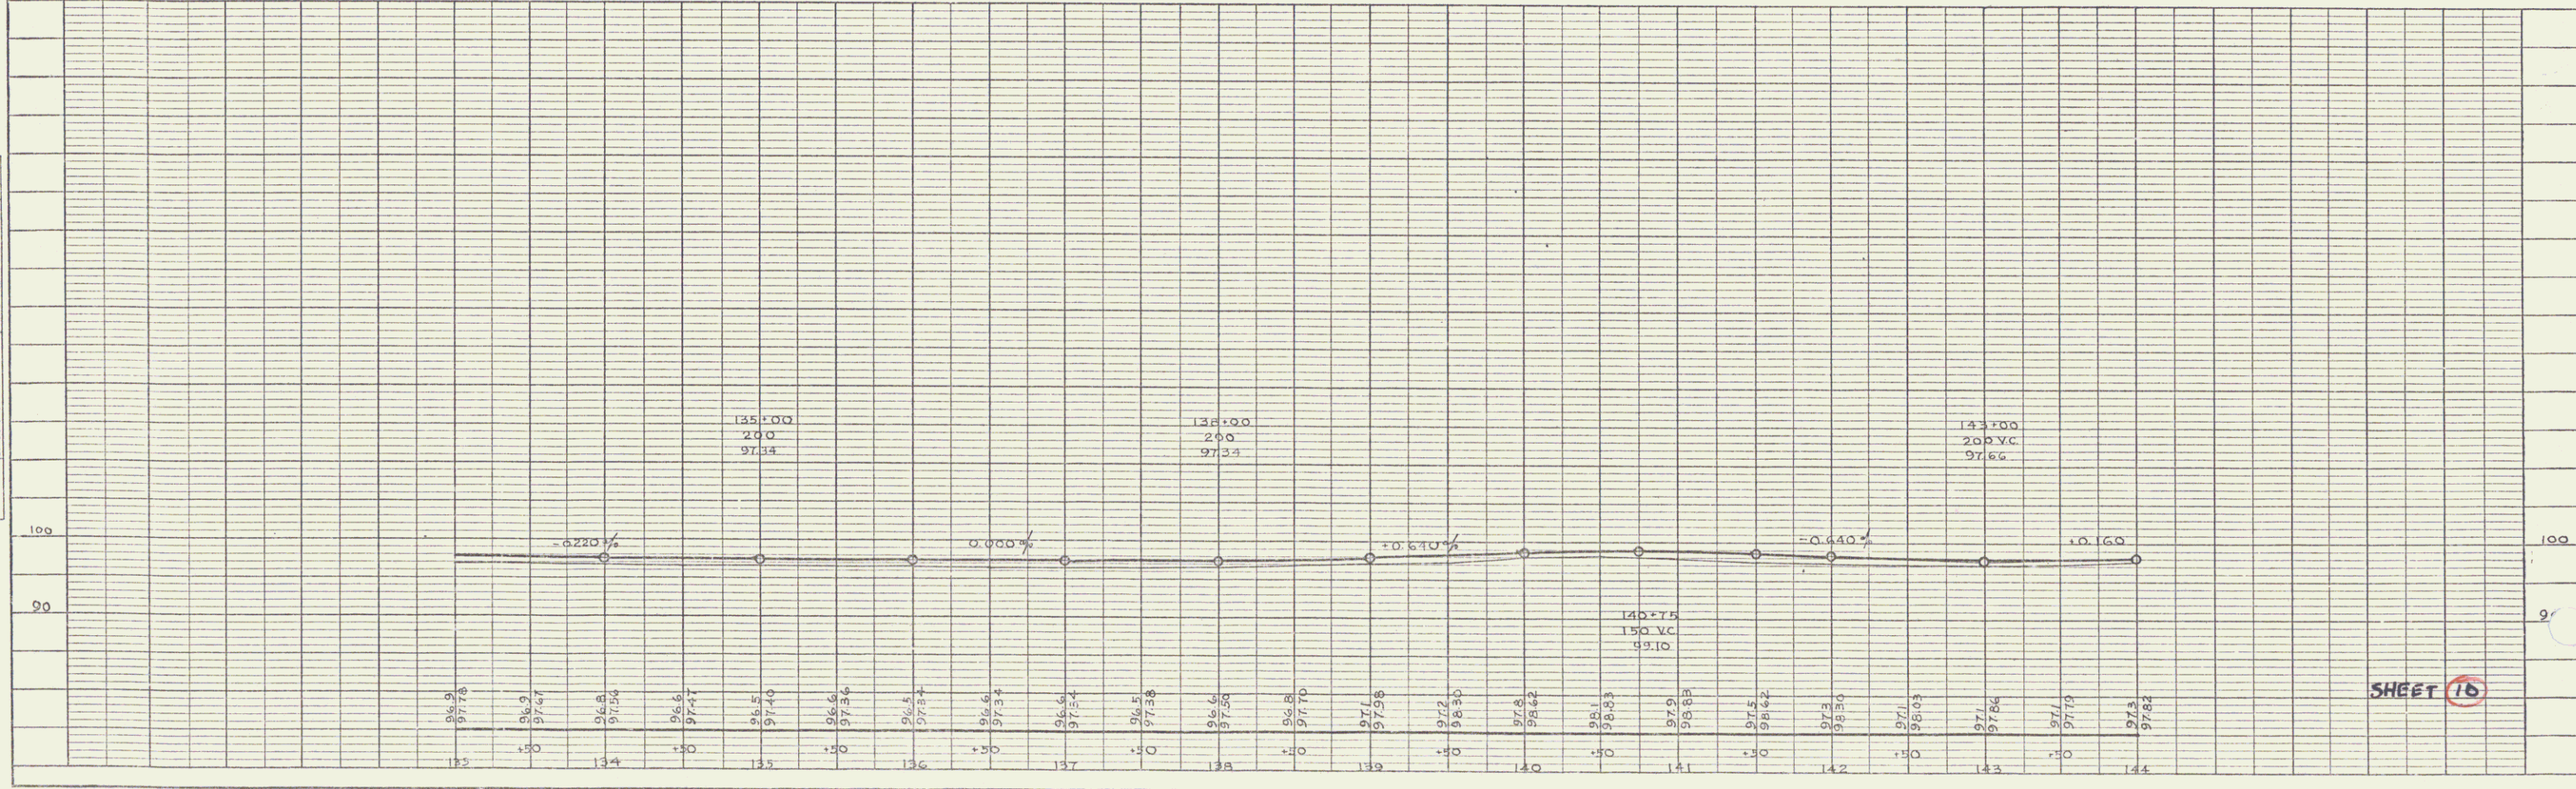


PLAN
 DRAWN BY: _____
 CHECKED BY: _____
 DATE: _____

PROFILE
 DRAWN BY: _____
 CHECKED BY: _____
 DATE: _____

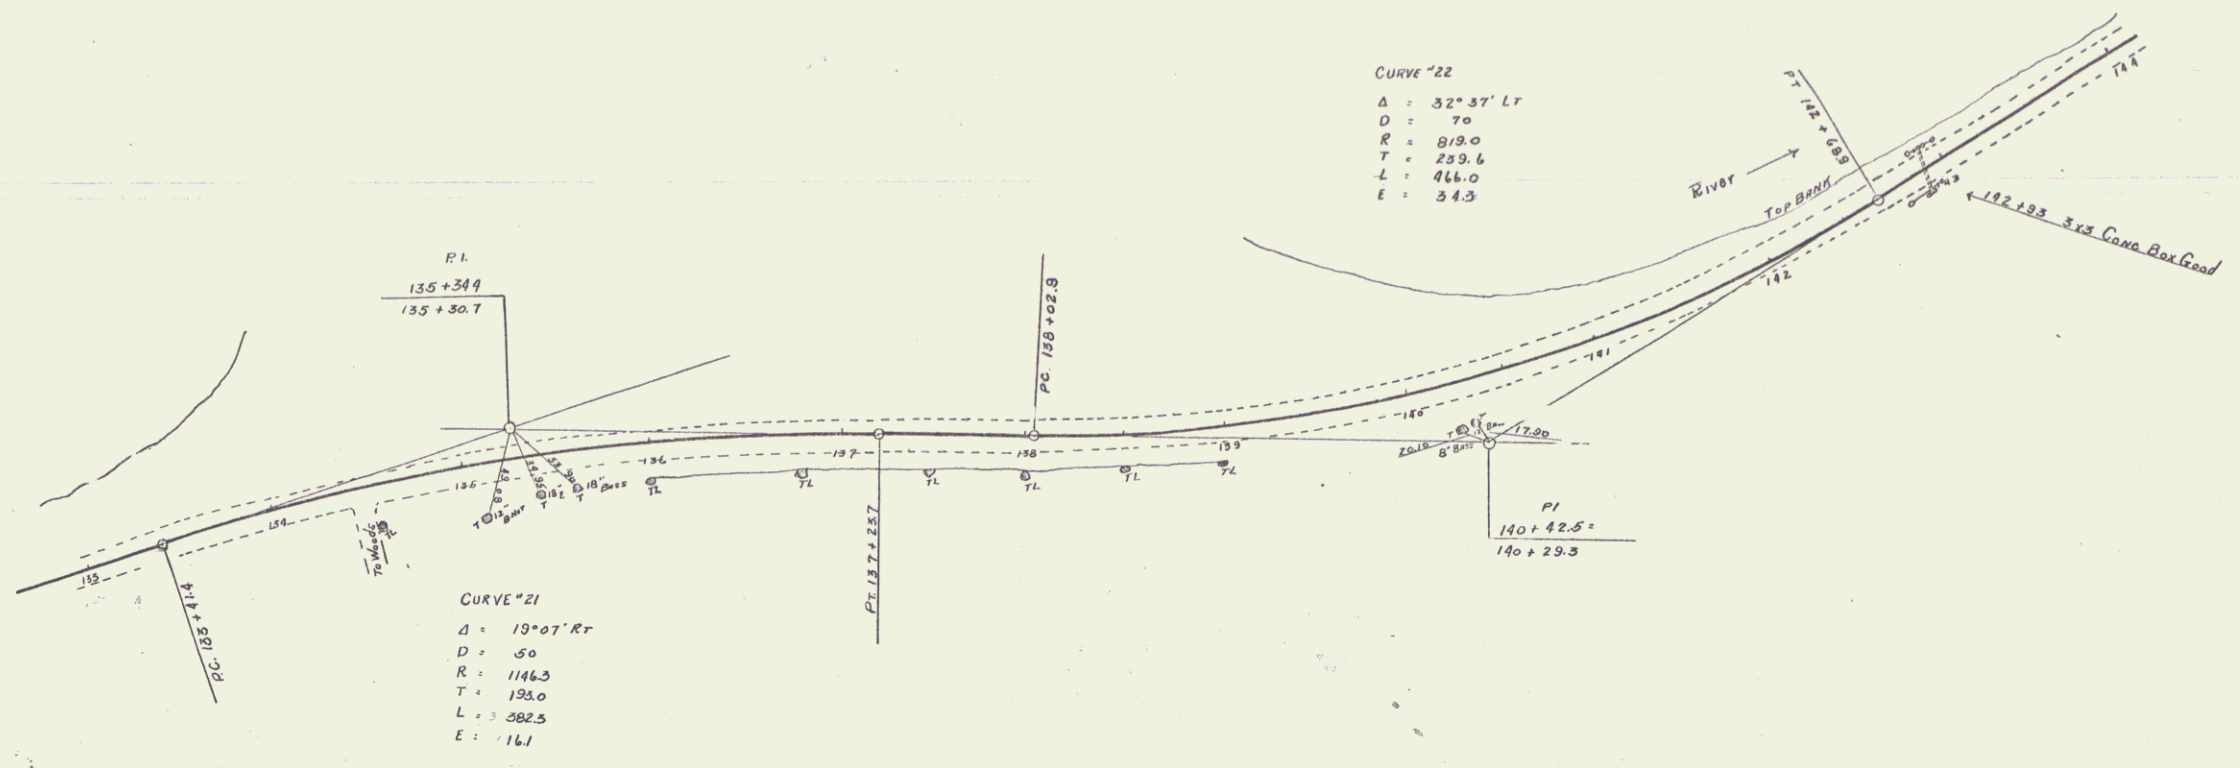

SHEET 16

Brandon S. S. S.