

DATE	
BY	
PLAN	REVISIONS
	1. DATE
	2. DESCRIPTION
	3. DRAWN BY
	4. CHECKED BY
	5. IN CHARGE
	6. DATE
	7. SHEET NO.
	8. TOTAL SHEETS
	9. PROJECT NO.
	10. DRAWING NO.

DATE	
BY	
PROFILE	REVISIONS
	1. DATE
	2. DESCRIPTION
	3. DRAWN BY
	4. CHECKED BY
	5. IN CHARGE
	6. DATE
	7. SHEET NO.
	8. TOTAL SHEETS
	9. PROJECT NO.
	10. DRAWING NO.

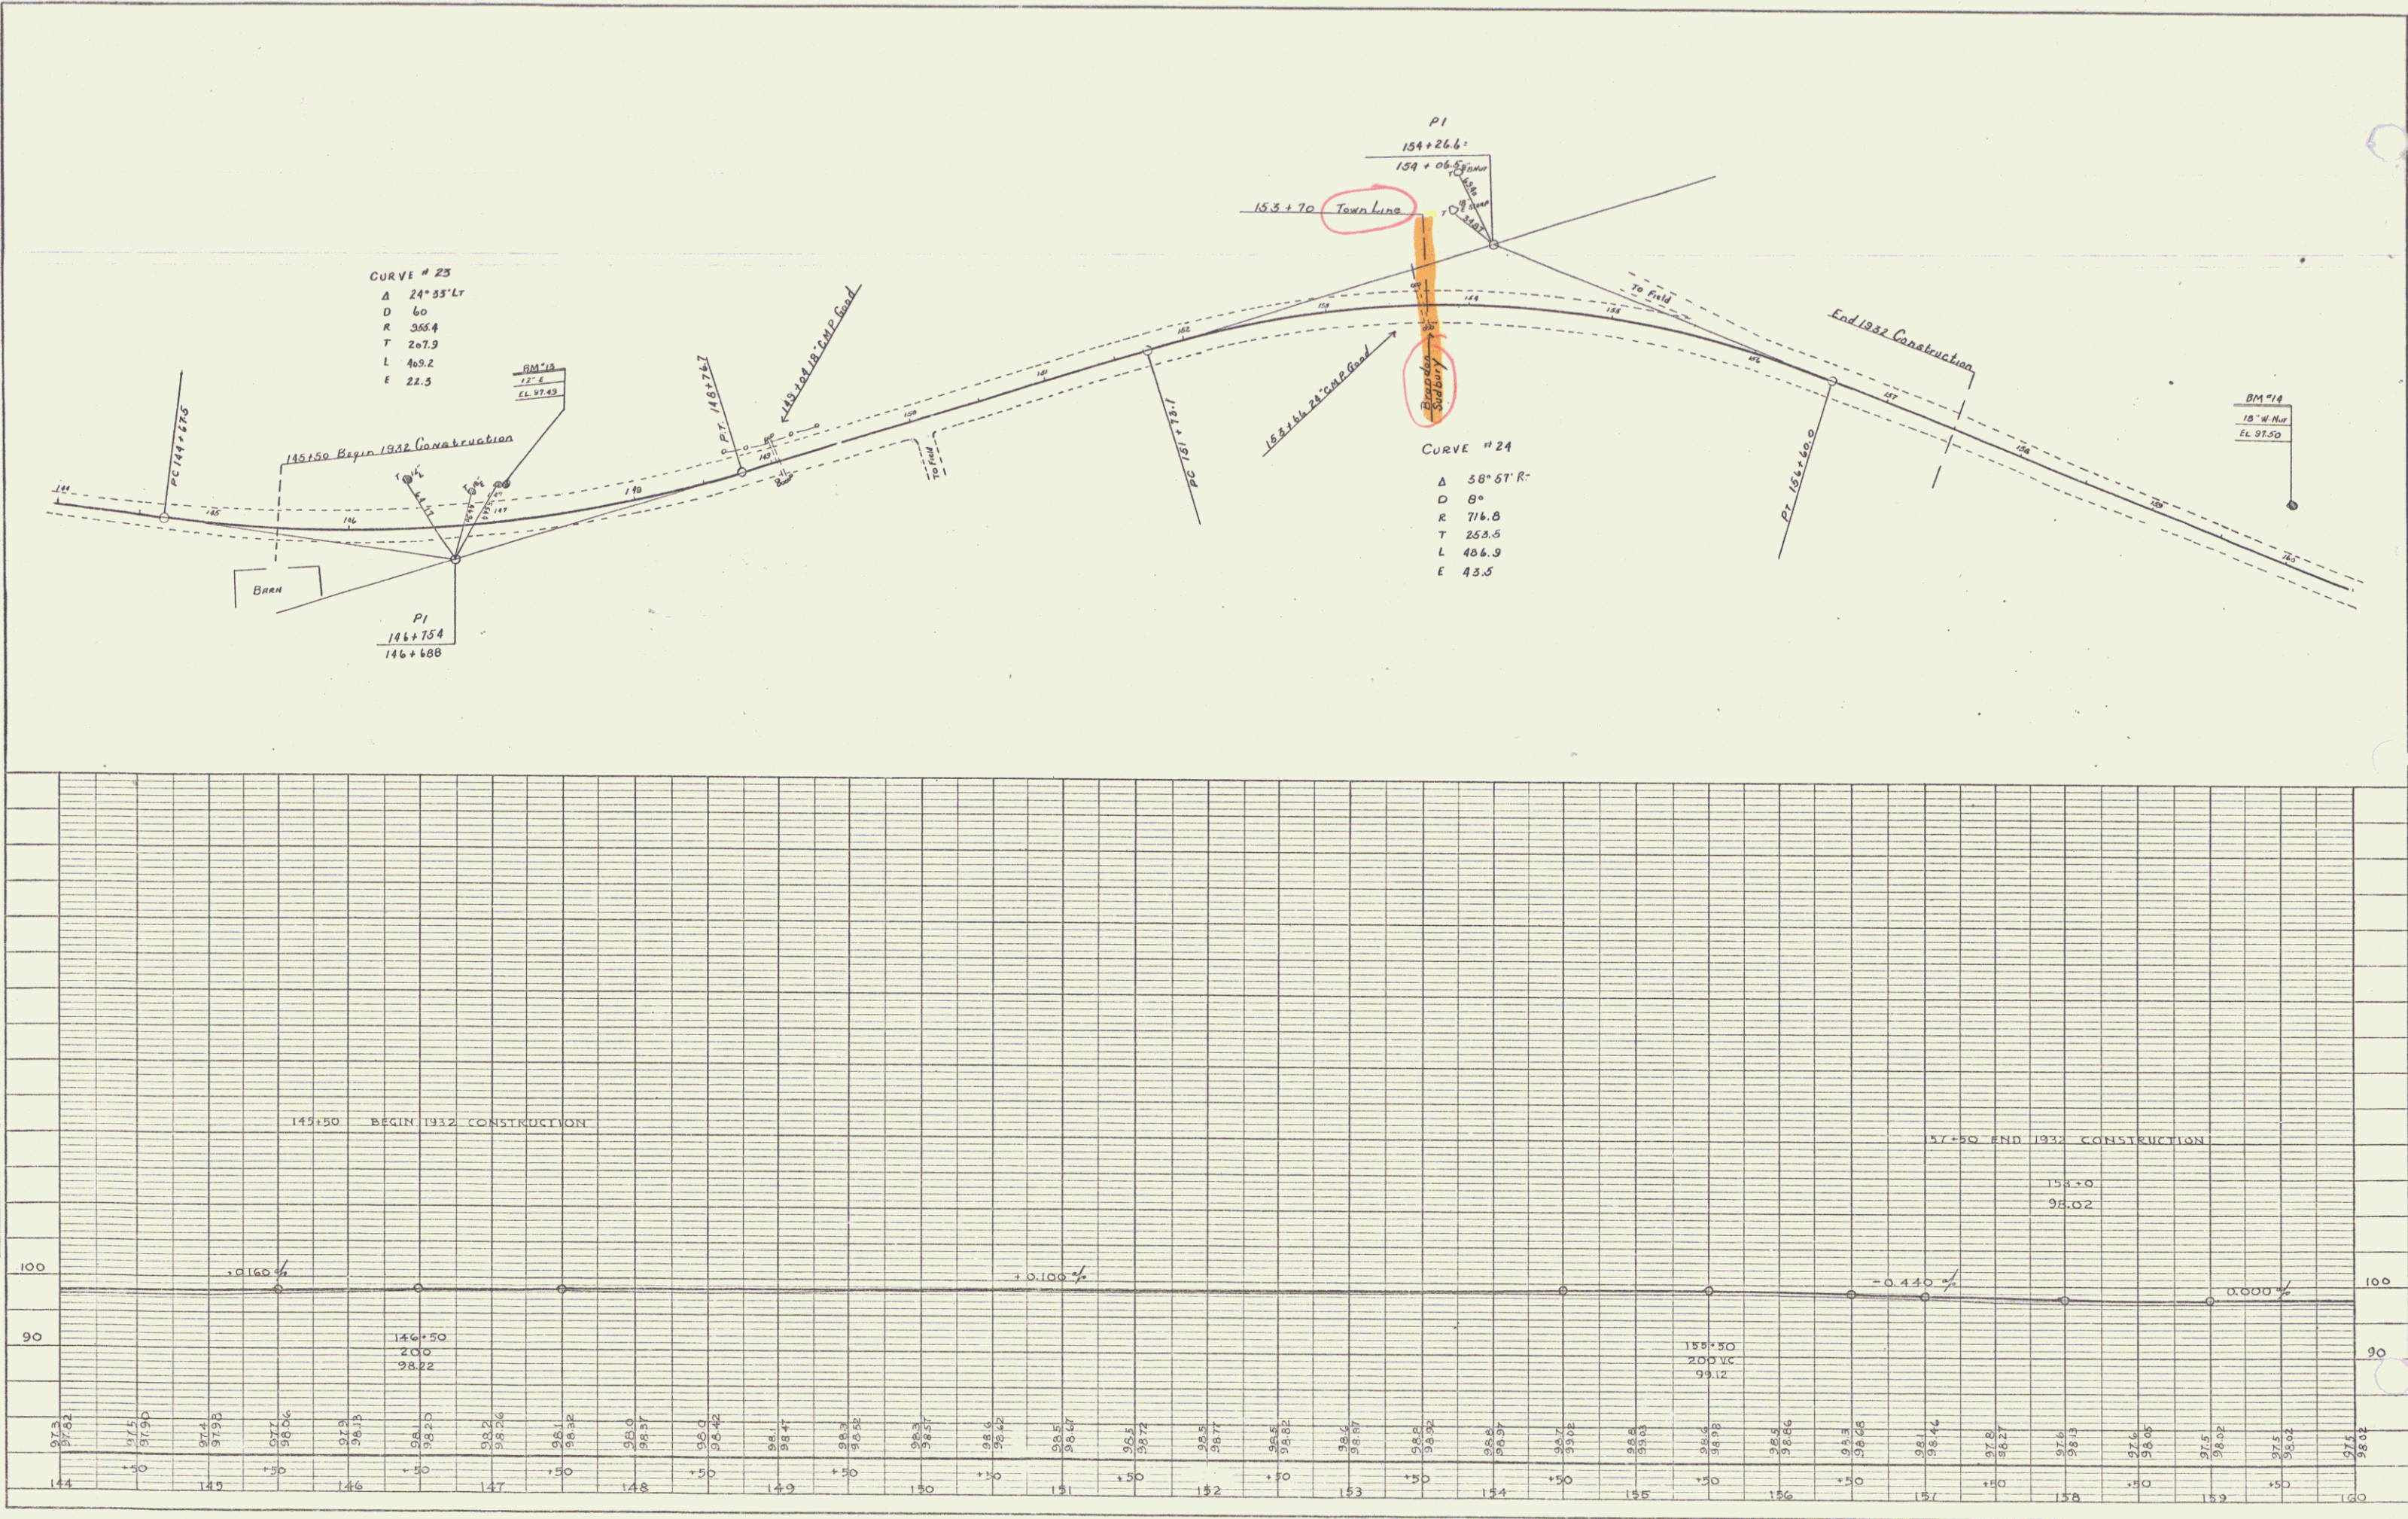


PLATE 1 - PLAN - PROFILE - P. P. & L. STATION
 KUFFEL & LUDER CO. NEW YORK