
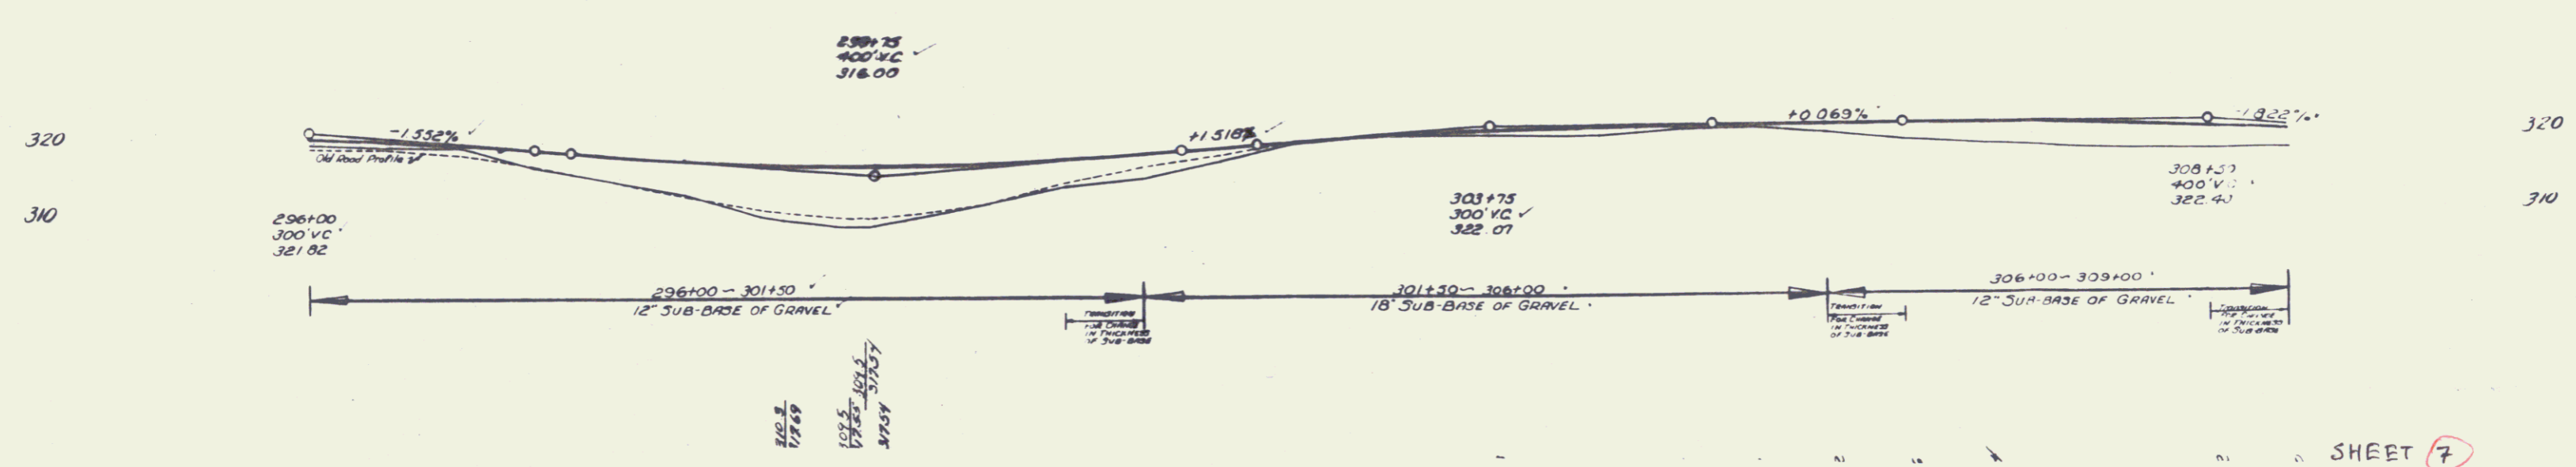


145  
 10/20/1941 7 50

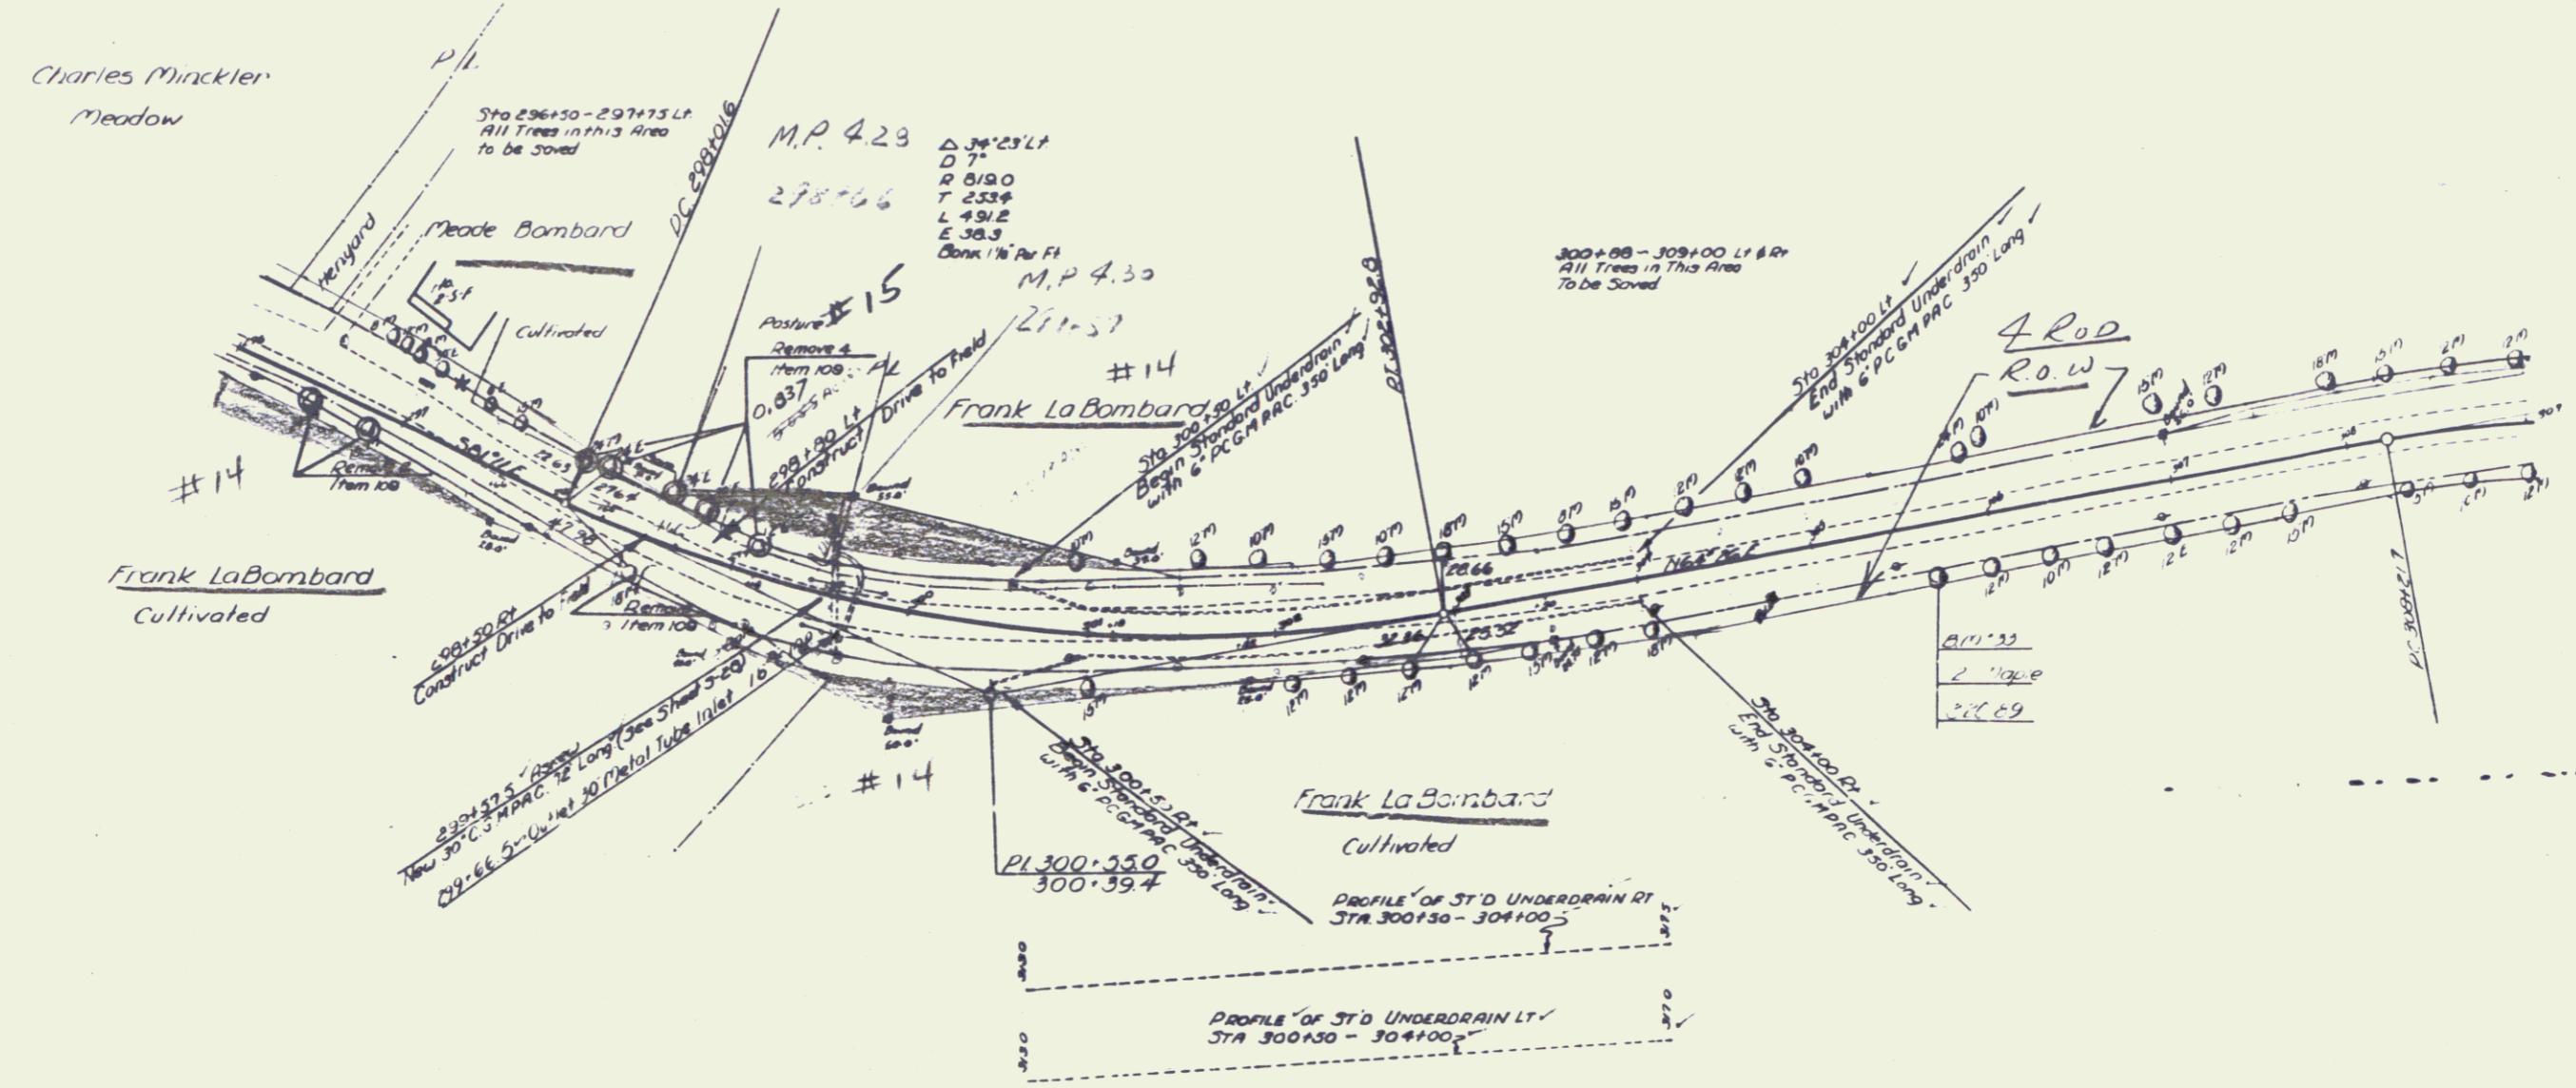

SHEET 7

5