


PLAN SHEET
 DATE BOOK
 ALPHABETICALLY
 BY
 DATE
 BY
 DATE
 BY
 DATE

PROFILE SHEET
 DATE BOOK
 ALPHABETICALLY
 BY
 DATE
 BY
 DATE
 BY
 DATE

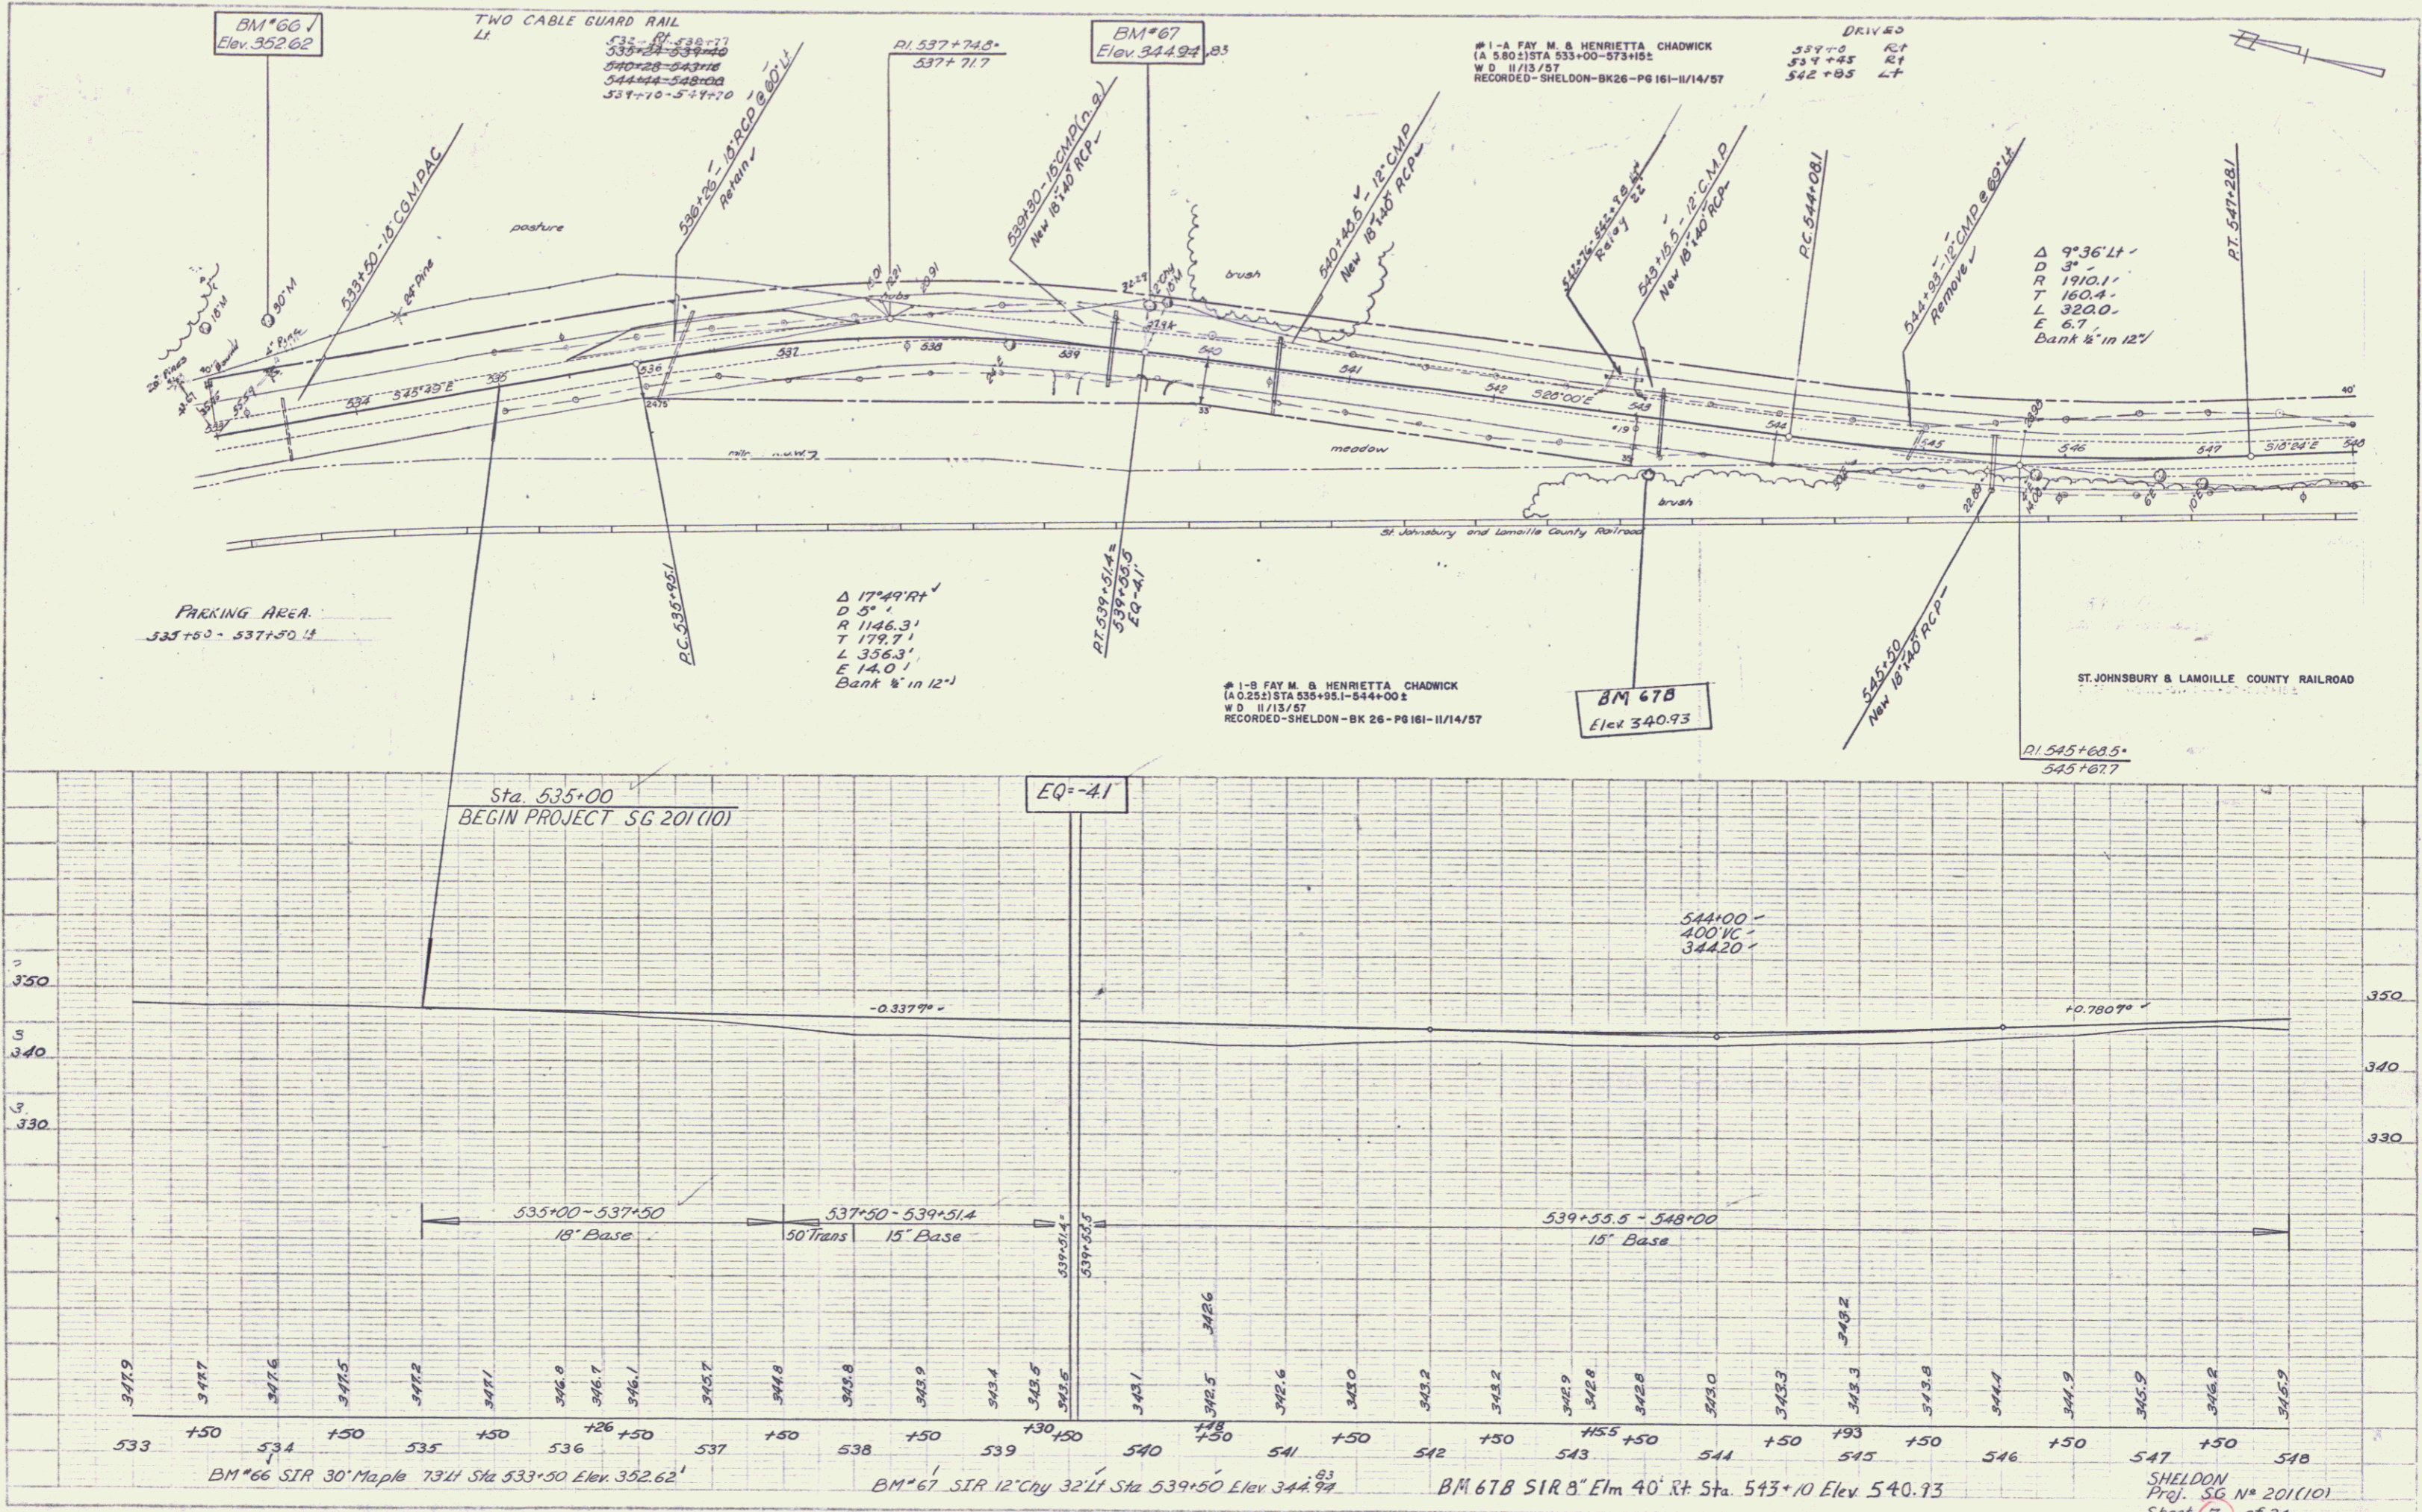

SHELDON
 Proj. SG No 201(10)
 Sheet 7 of 34