



TWO CABLE GUARD RAIL
 LI RT
 551+56-552+04
 552+48-554+15
 551+85-552+14
 552+70-553+15

CONSTRUCT DRIVE
 LI RT
 552+90 549+85

PARKING AREA
 549+75-551+25 RT

PLAN	DATE	BY
REVISION		
NOTE BOOK		
NO.		
DATE		
BY		
DATE		
BY		
DATE		

PROFILE	DATE	BY
REVISION		
NOTE BOOK		
NO.		
DATE		
BY		
DATE		
BY		
DATE		

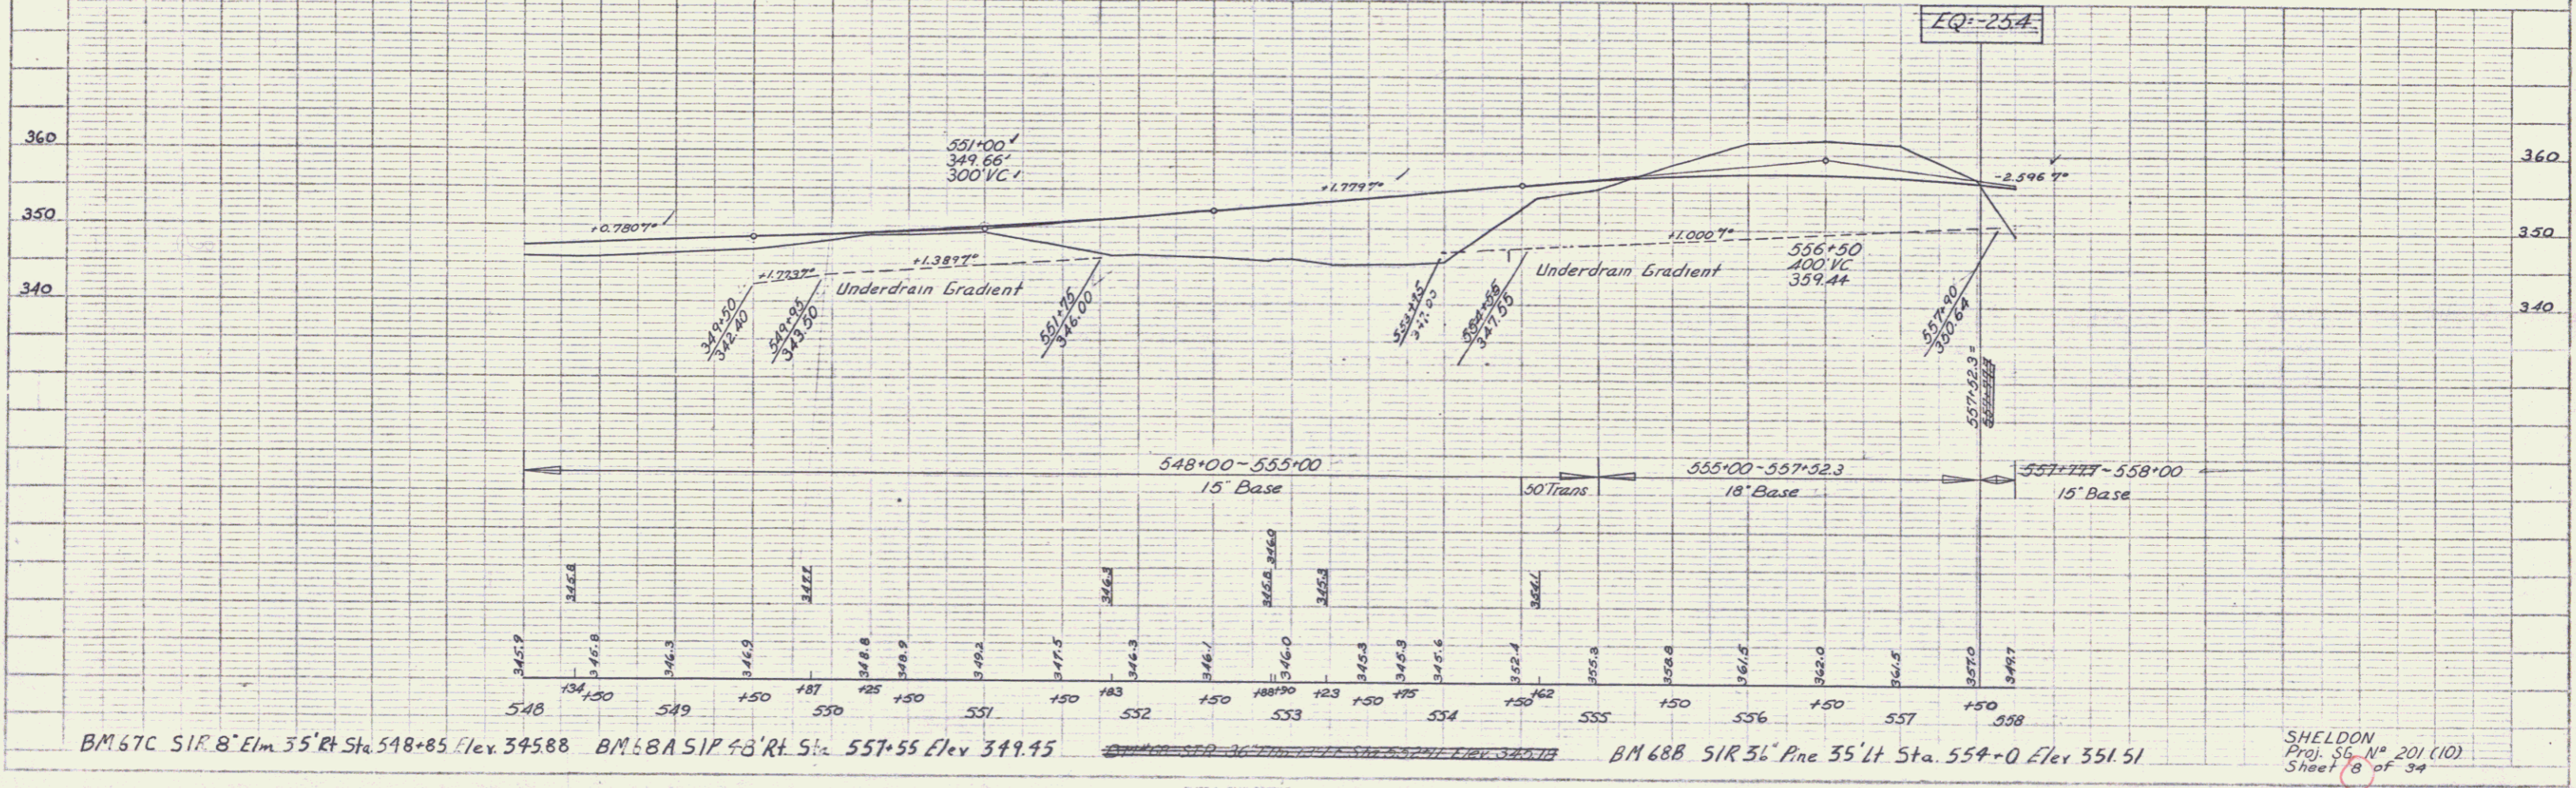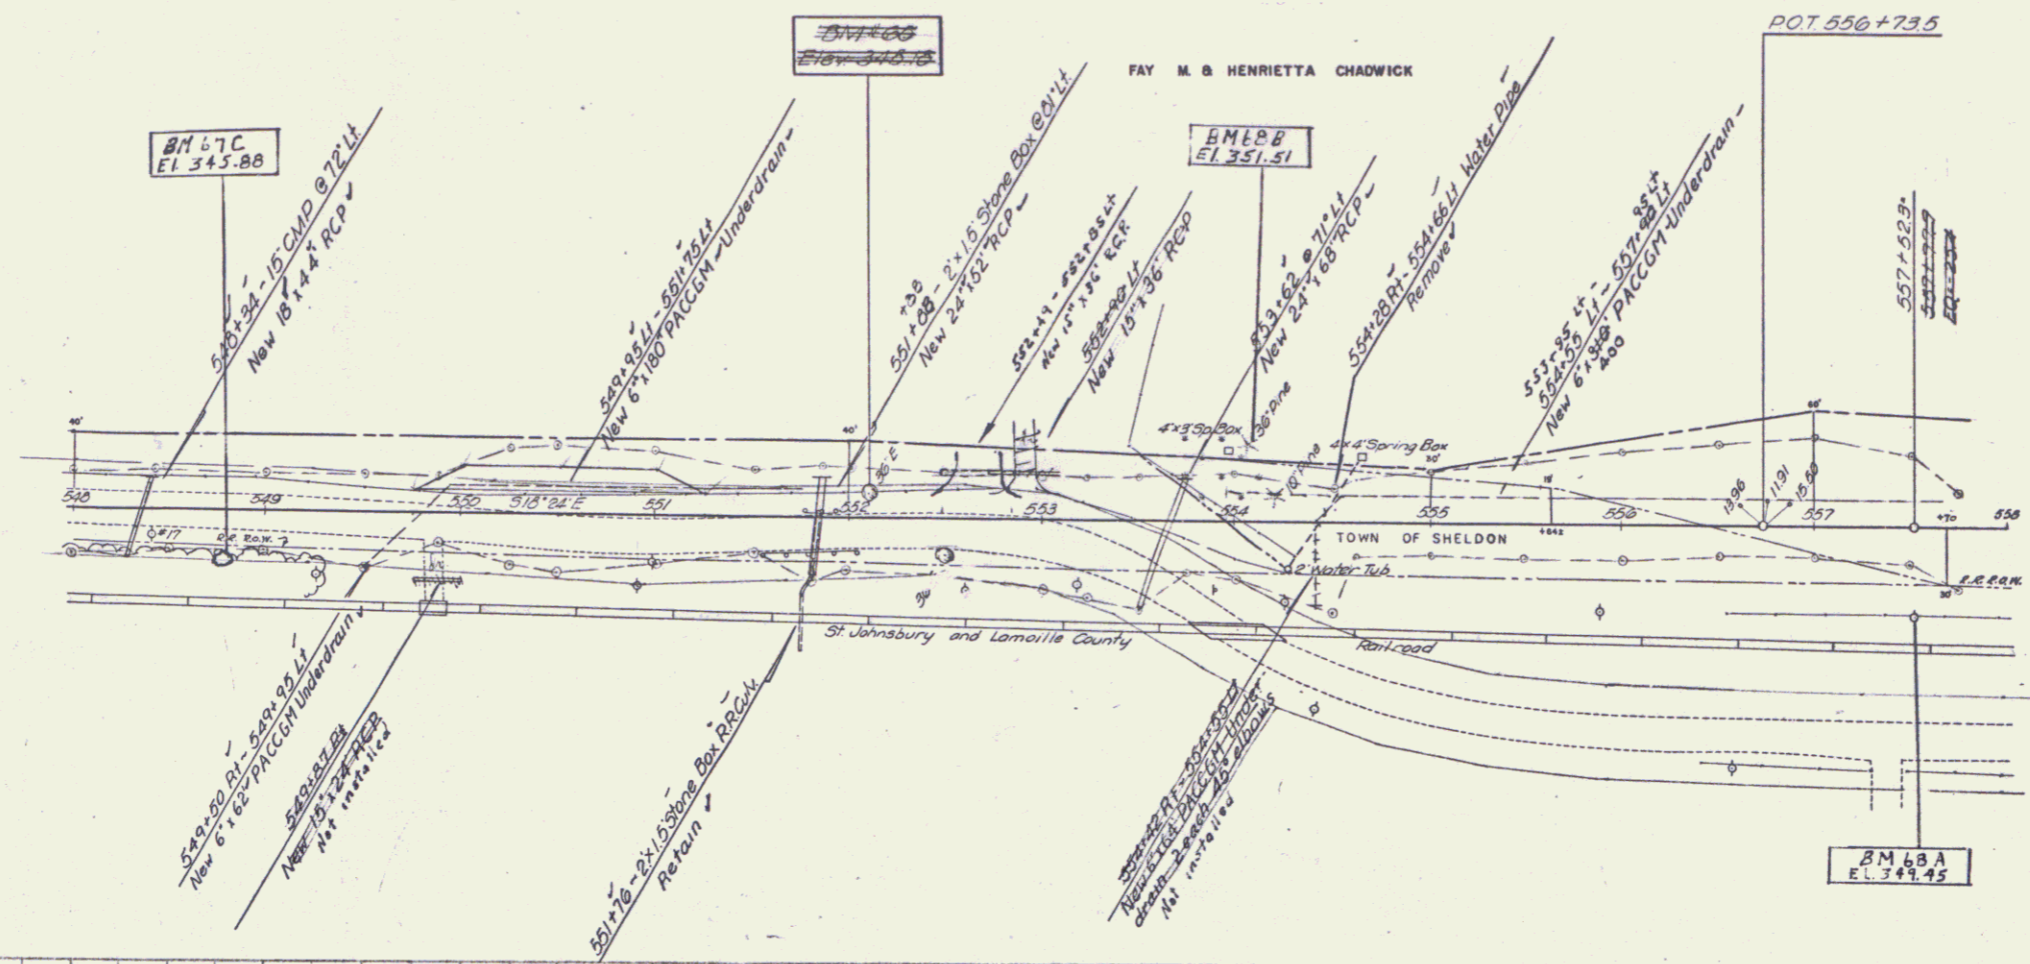

BM 67C SIR 8' Elm 35' Rt Sta 548+85 Elev 345.88 BM 68A SIR 4.8' Rt Sta 557+55 Elev 349.45 BM 68B SIR 36' Pine 35' Lt Sta 554+0 Elev 351.51

SHELDON
 Proj. 56 N° 201 (10)
 Sheet 8 of 34