
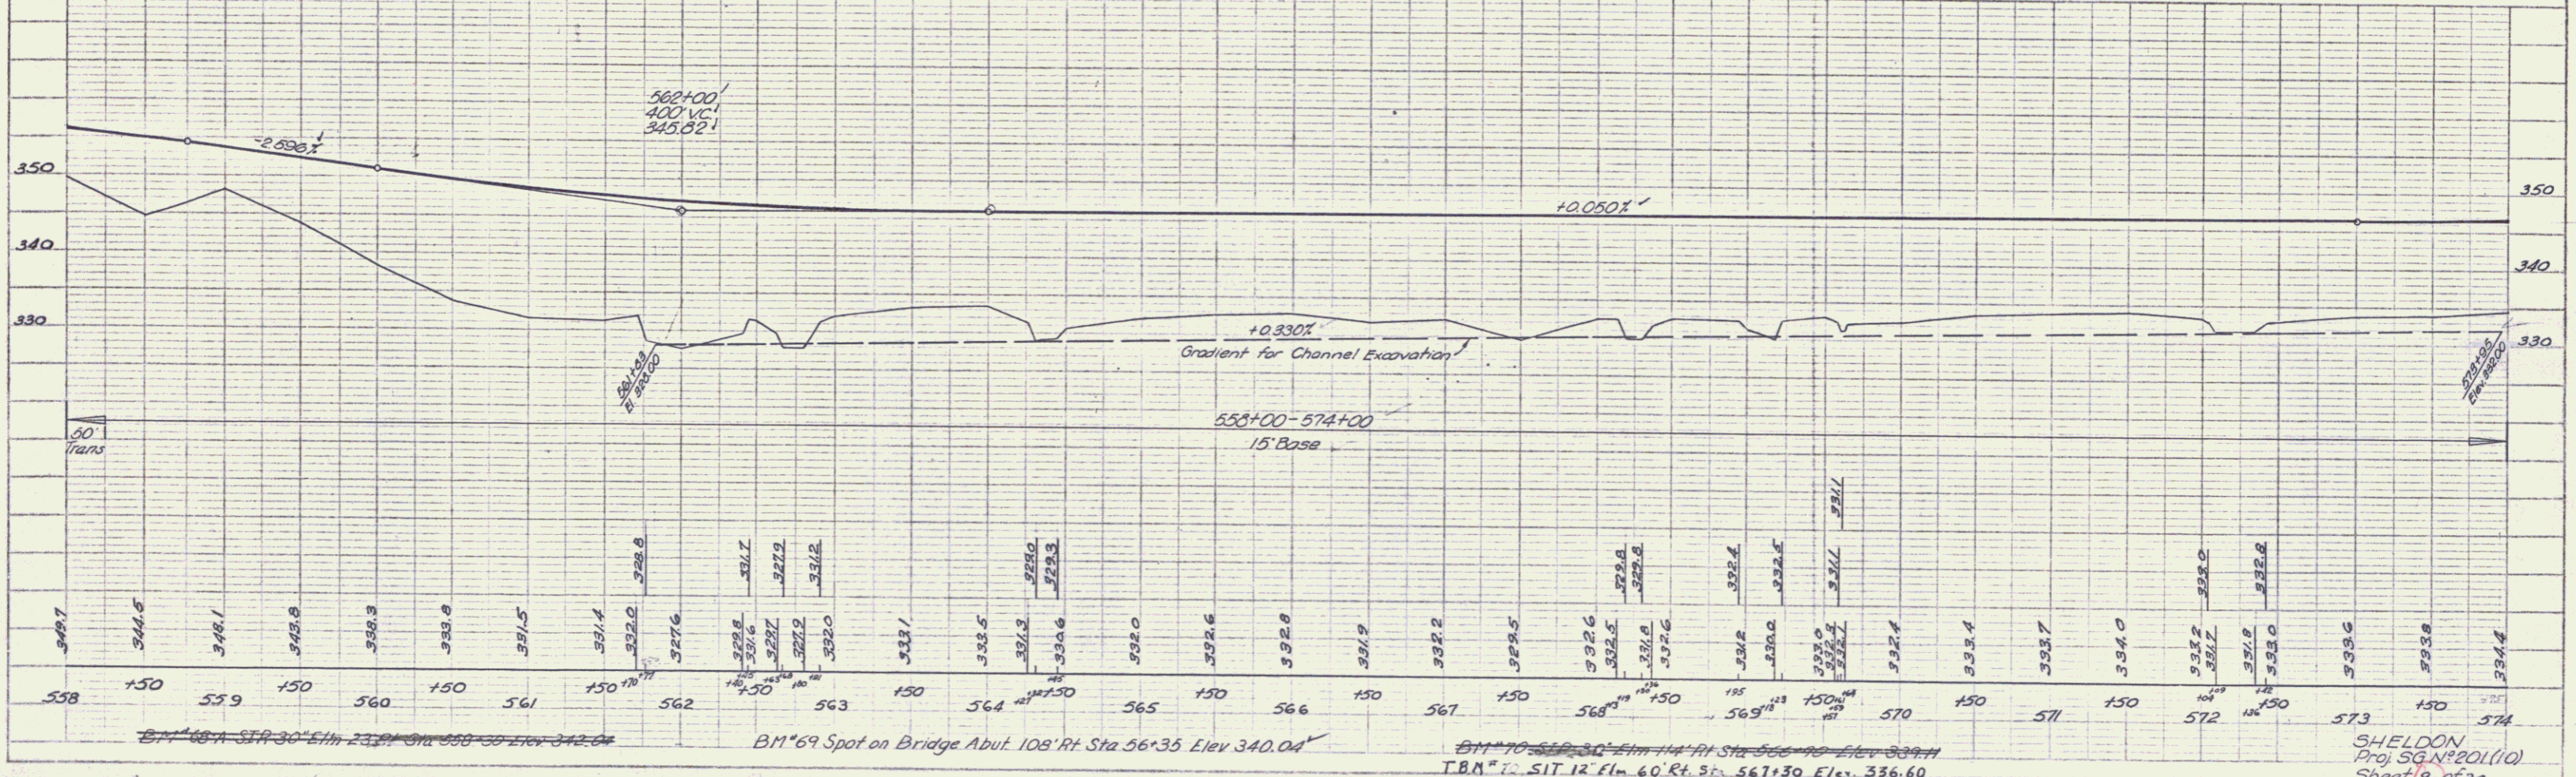


PLAN
 DATE: 10/1/03
 DRAWN BY: J. L. LEBLANC
 CHECKED BY: C. E. H.
 SCALE: 1" = 40'

PROFILE
 DATE: 10/1/03
 DRAWN BY: J. L. LEBLANC
 CHECKED BY: C. E. H.
 SCALE: 1" = 40'

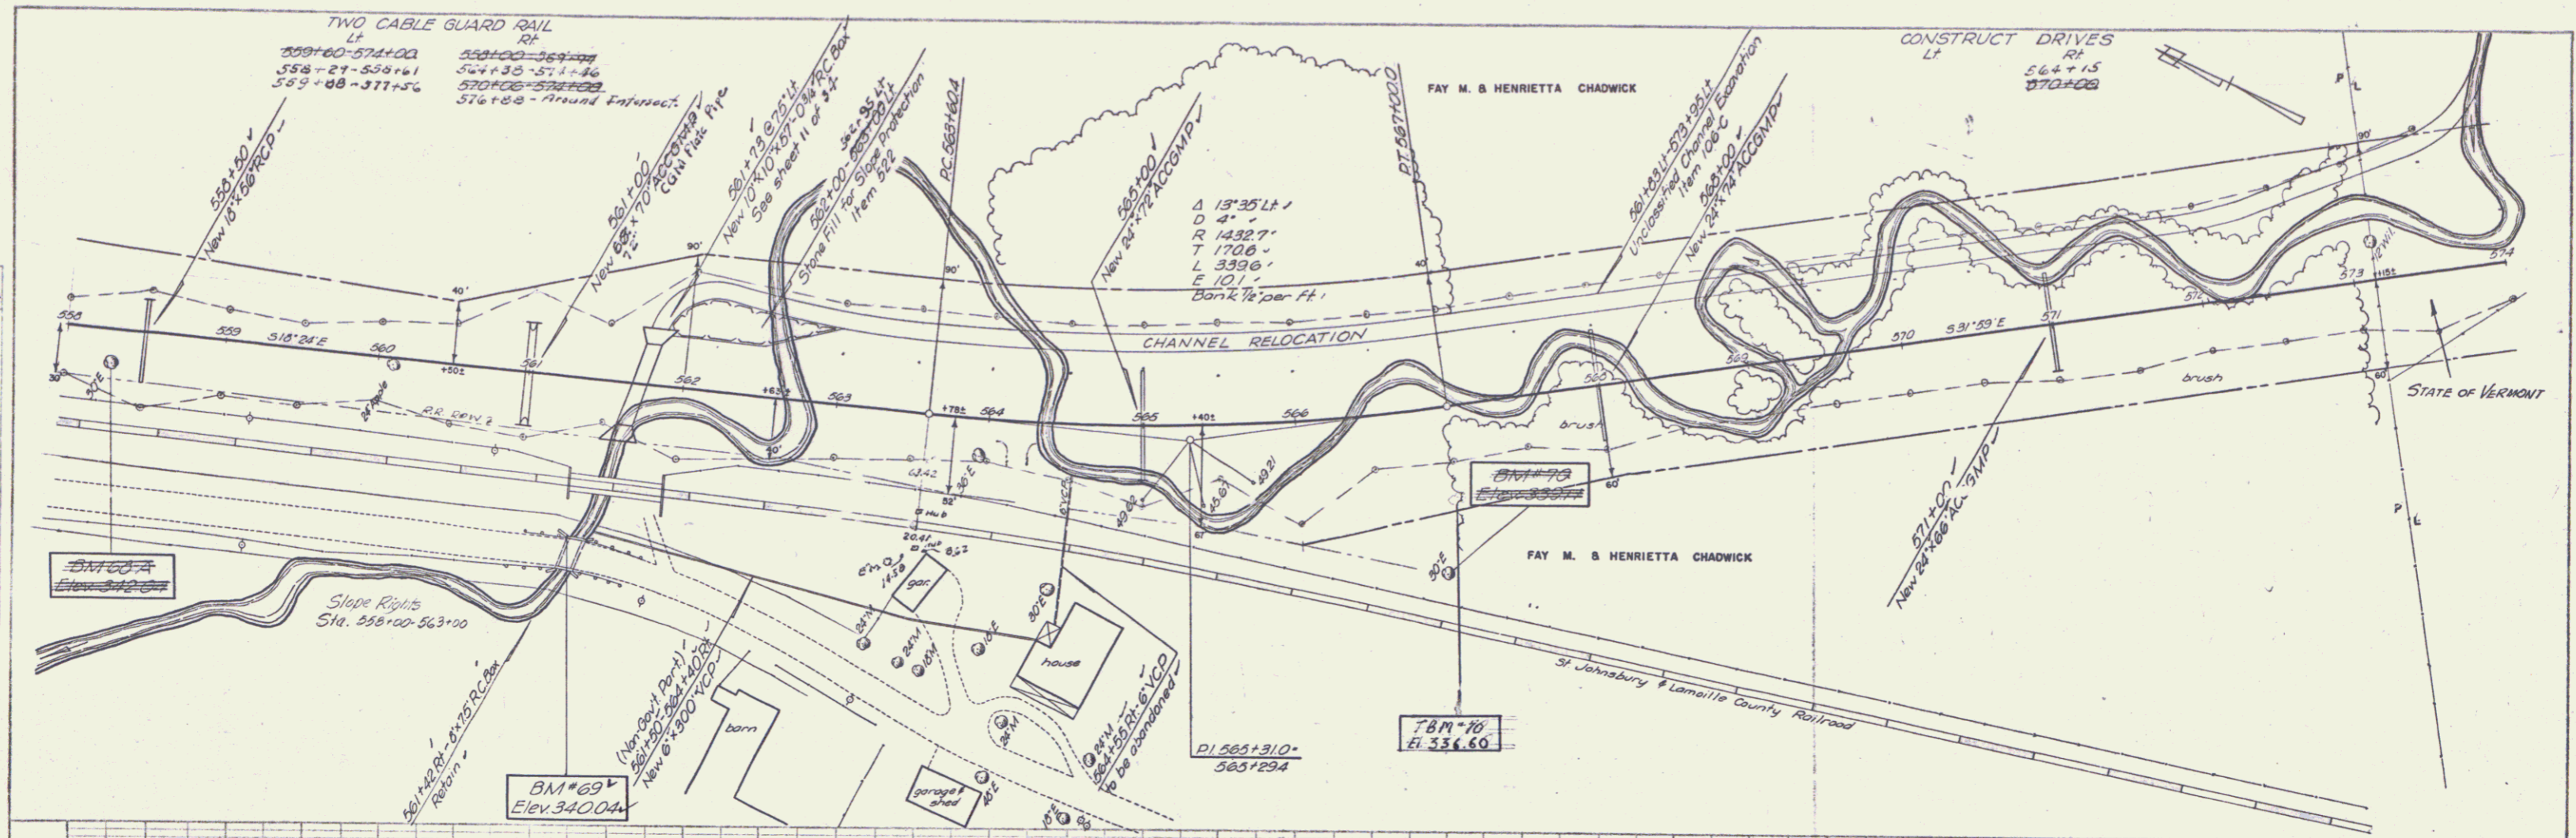

SHELDON
 Proj. SG No. 201(10)
 Sheet 9 of 34