
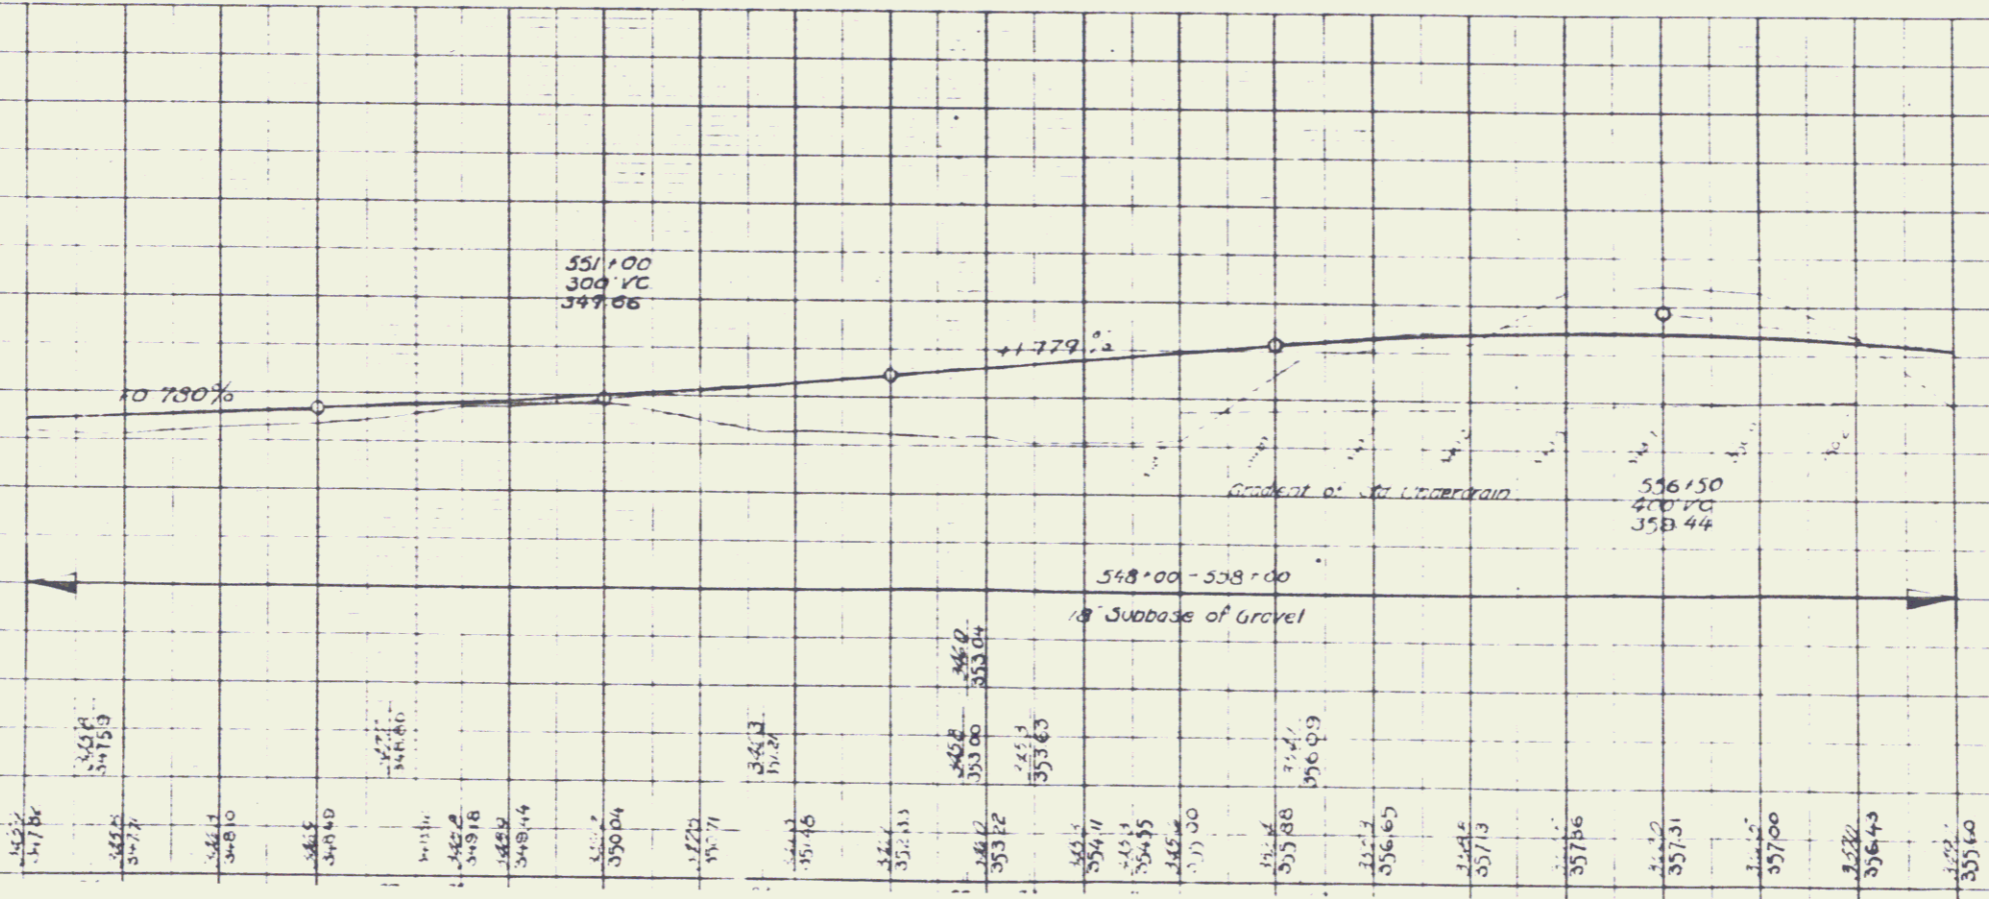


PLAN
 DRAWN BY
 CHECKED BY
 DATE
 PROJECT NO.
 SHEET NO.

TITLE
 PROJECT NO.
 SHEET NO.

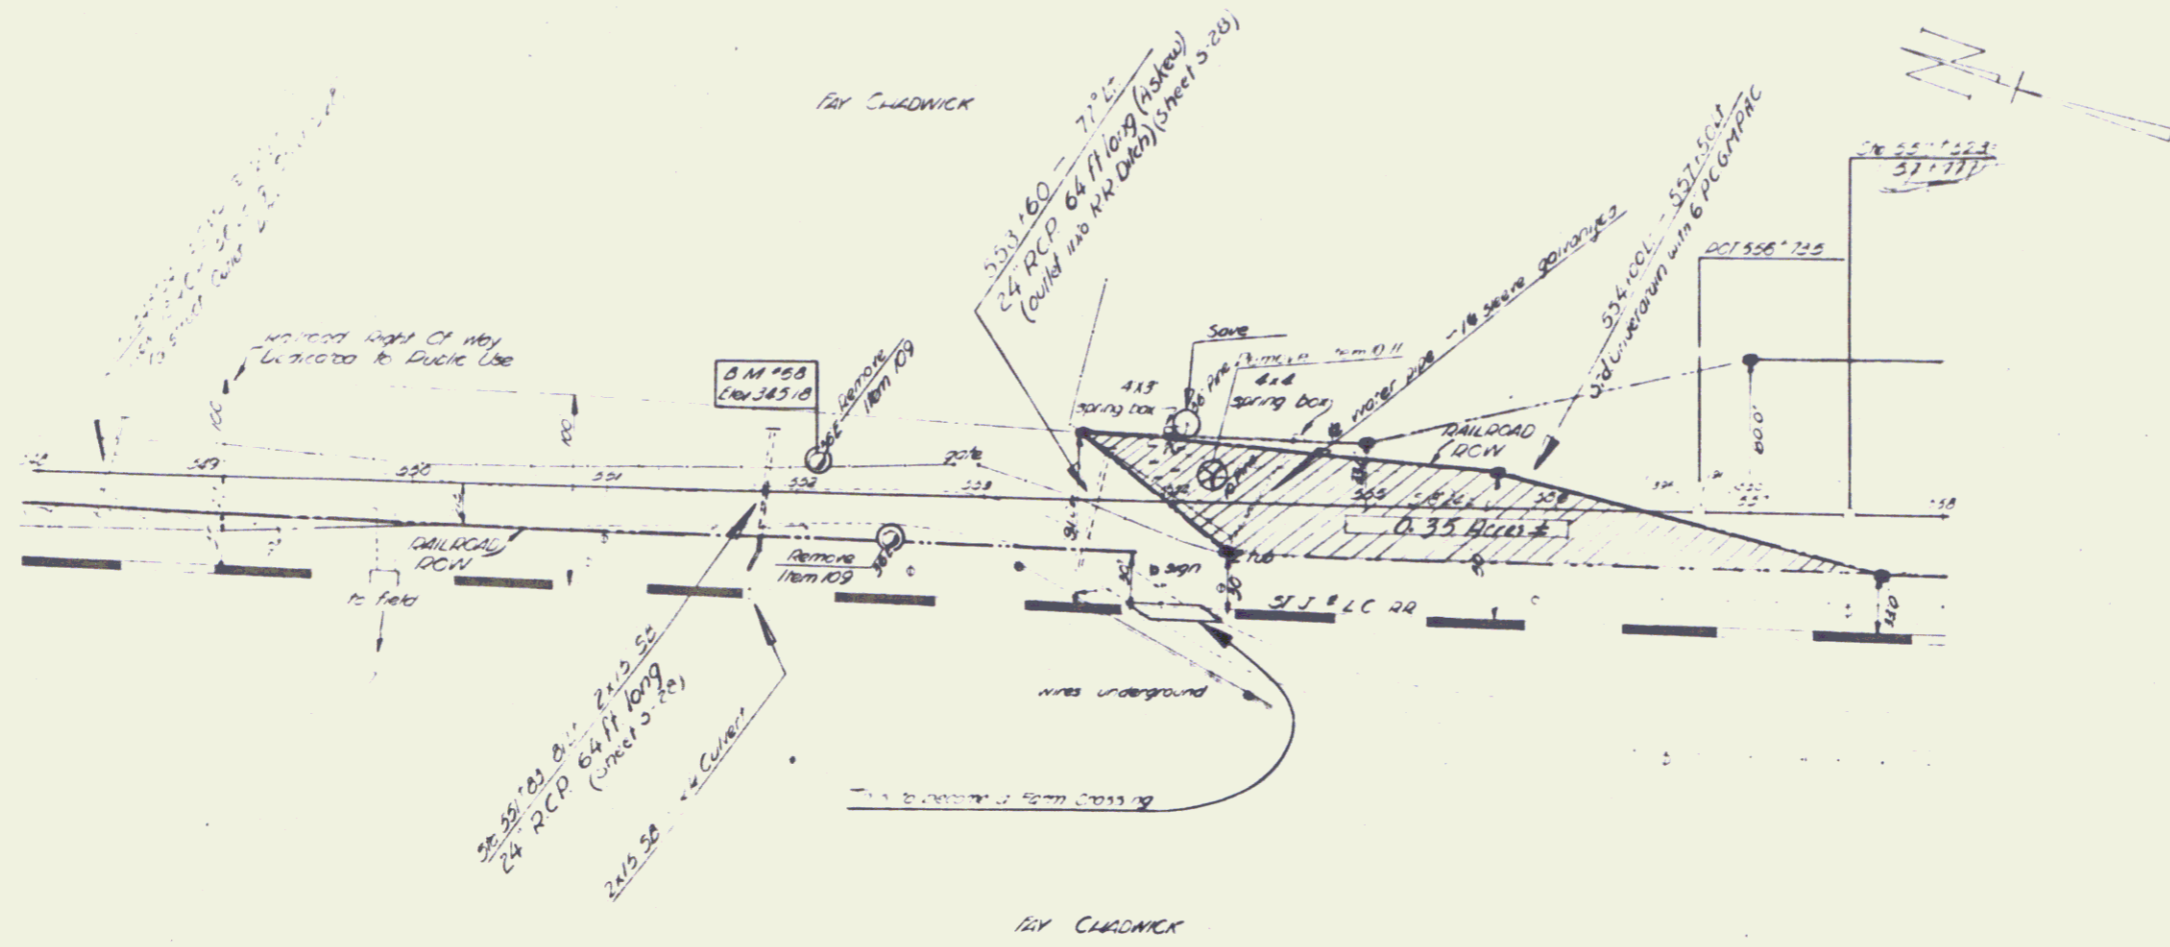

SHEET SA

4