

INDEX OF SHEETS		
SHEET NO. 1	TITLE PAGE	
2	TYPICAL CROSS-SECTION OF IMPROVEMENT	GRADING, DRAINAGE, BASE, GUARD RAIL & DOUBLE TACK COAT OF REFINED TAR, ITEM 29.
3	BANKING AND WIDENING TABLES	
4-10	PLAN AND PROFILE	STA. 473+00 TO STA. 549+50
11	CULVERT DETAILS	6' X 8' R.C.B. STA. 50+00
12	STANDARD STRUCTURE SHEET	S 28 (PIPE CULVERTS)
13		S 30 (GUARD RAIL & TIMBER CURB)
14		S 30A (BOUNDARY MARKERS)
15		S 40 (BARRICADES, SIGNS, & LIGHTS)
16		S 41 (TYPICAL GRADING CROSS SECTIONS)
17-30	CROSS SECTIONS	

STATE OF VERMONT
STATE HIGHWAY DEPARTMENT

PLAN AND PROFILE OF PROPOSED
STATE HIGHWAY

FEDERAL AID SECONDARY PROJECT

TOWNS OF HIGHGATE-SHELDON
VERMONT ROUTE 104B


BEGINNING AT A POINT 472.5 FEET NORTHERLY FROM THE HIGHGATE SHELDON TOWN LINE AND EXTENDING SOUTHERLY 5891.9 FEET.

LENGTH OF PROJECT 5891.9 FEET = 1.115 MILES

STANDARD STRUCTURE SHEETS APPROVED BY THE CHIEF ENGINEER


SHEET	3 28	4 10 41
	3 30	3 12 41
	3 30A	4 12 41
	3 40	9 3 40

FED. ROAD DIST. NO.	STATE	PROJECT NO.	SECTION	SHEET NO.	TOTAL SHEETS
VT	VT	201 F(1)	1	32	

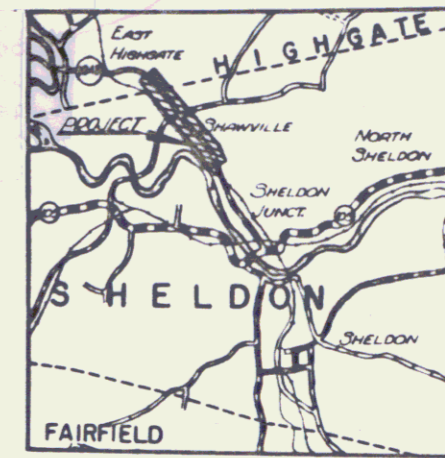

Project SN FAS 201 F(1)
Pin # ODR 446
Route VT 78
Date 11/13/1942

CORRECTED WITH RECORD PLAN
of B. O'Connell - 2/20/43
RECORD PLANS

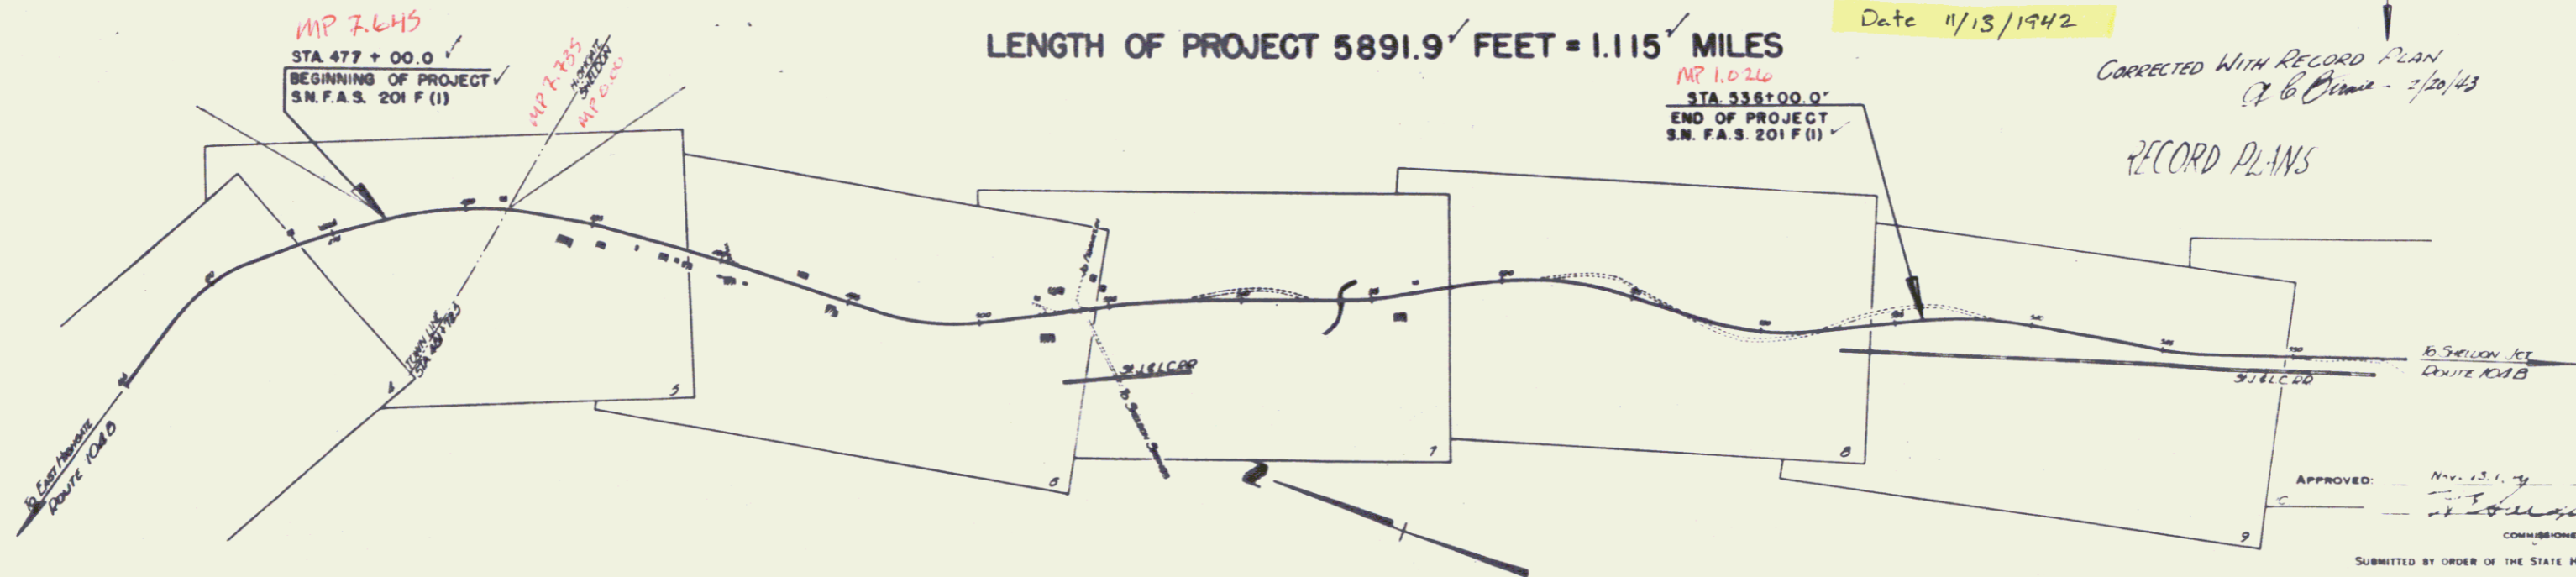

SYMBOL	DESCRIPTION
--- ---	COUNTY LINE
--- ---	TOWN LINE
--- ---	FENCE LINE
--- ---	STONE WALL
--- ---	UNFENCED PROPERTY
--- ---	GUARD RAIL
--- ---	TRAVELED WAY
--- ---	RAILROAD

APPROVED: *[Signature]*
COMMISSIONER OF HIGHWAYS
SUBMITTED BY ORDER OF THE STATE HIGHWAY BOARD

RECOMMENDED FOR APPROVAL

RECEIVED
VT 78
DISTRICT ENGINEER

THESE PLANS ARE SUBJECT TO SUCH REVISIONS AS MAY BE

SHEET 1