


34 143
2014 1942 4 39

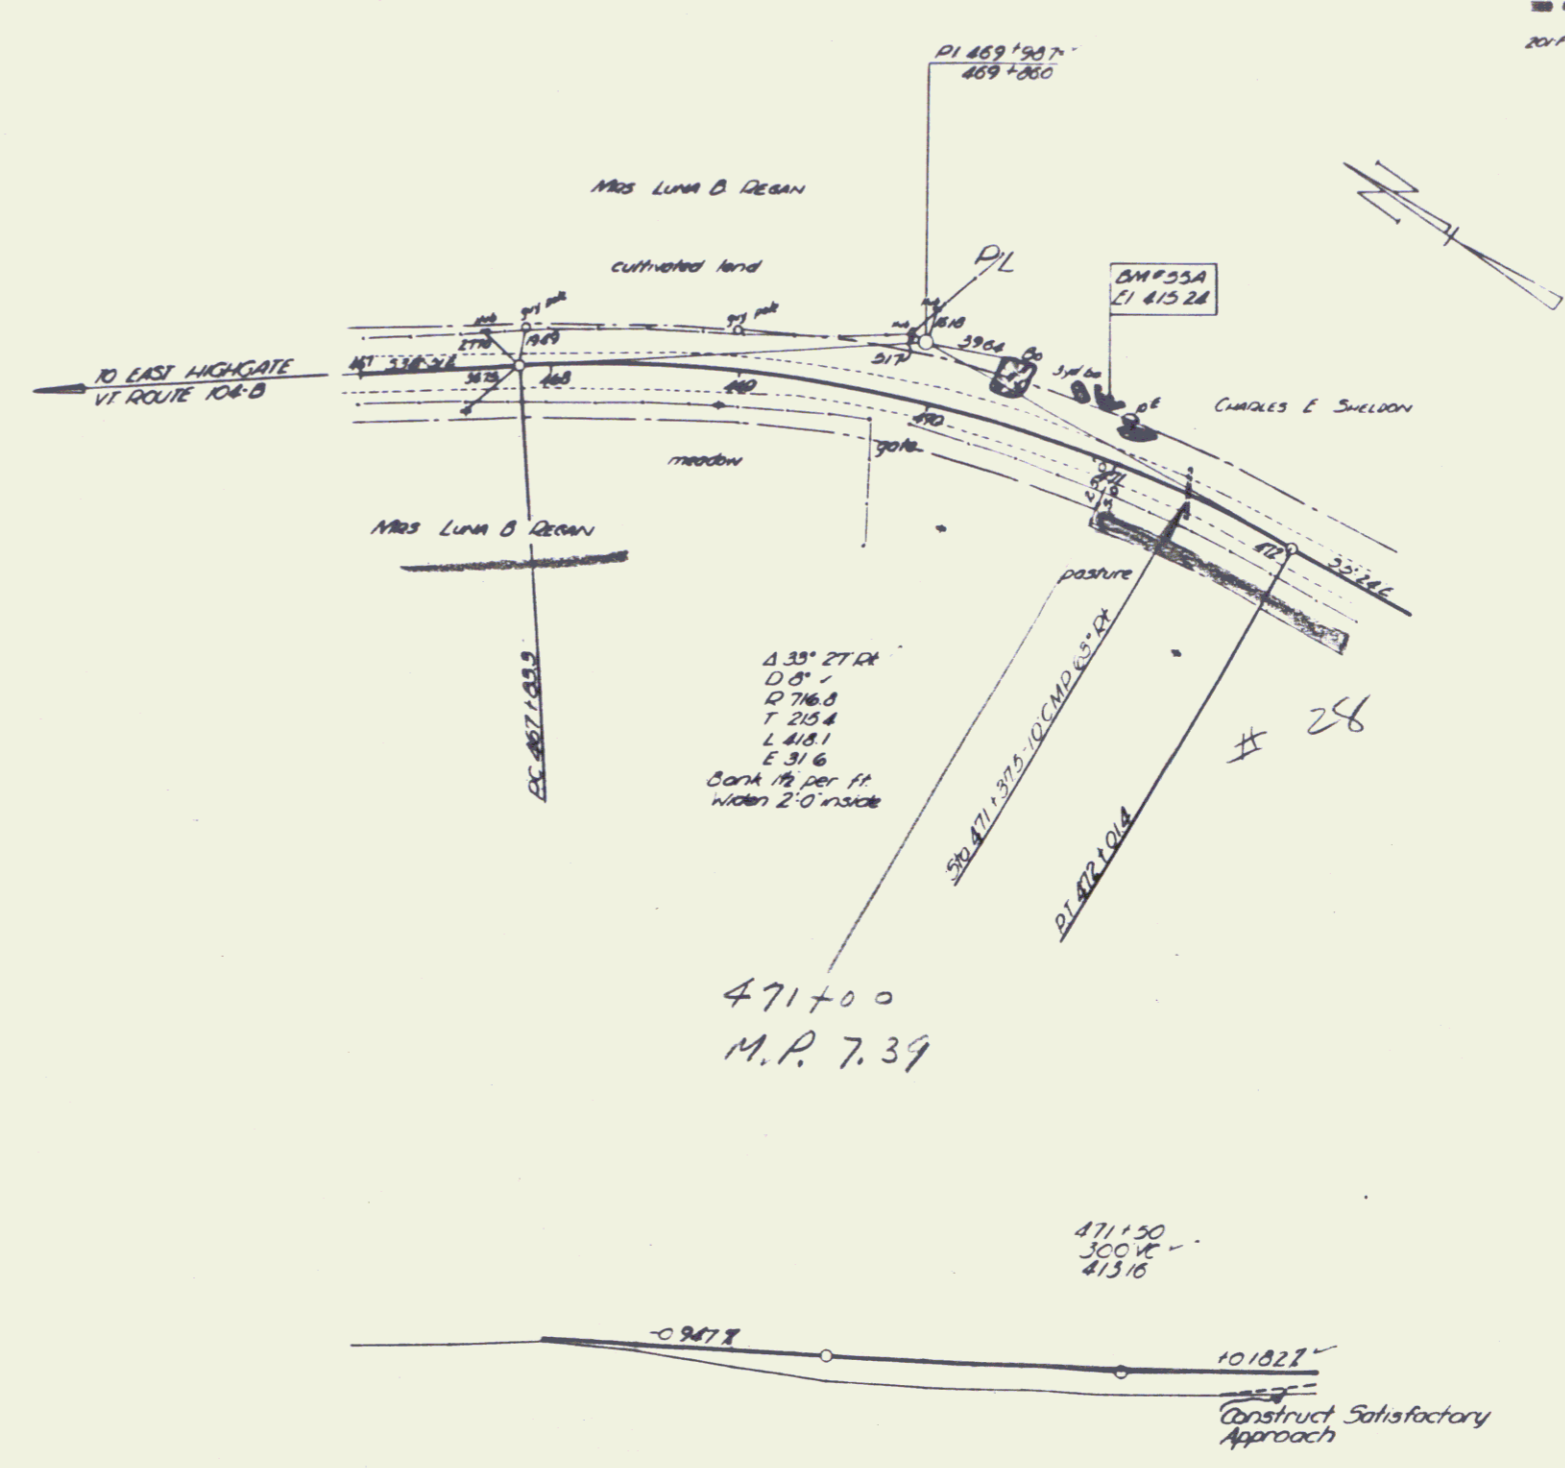

Δ 35° 27' 24"
D 8' ✓
R 716.8
T 25.4
L 418.1
E 31.6
Bank 1% per ft
Widen 2'0 inside

471+00
M.P. 7.39

471+50
300' ✓
413.16

101822
Construct Satisfactory
Approach

420

410

4627
4285

SHEET 4