



1/4" = 100'

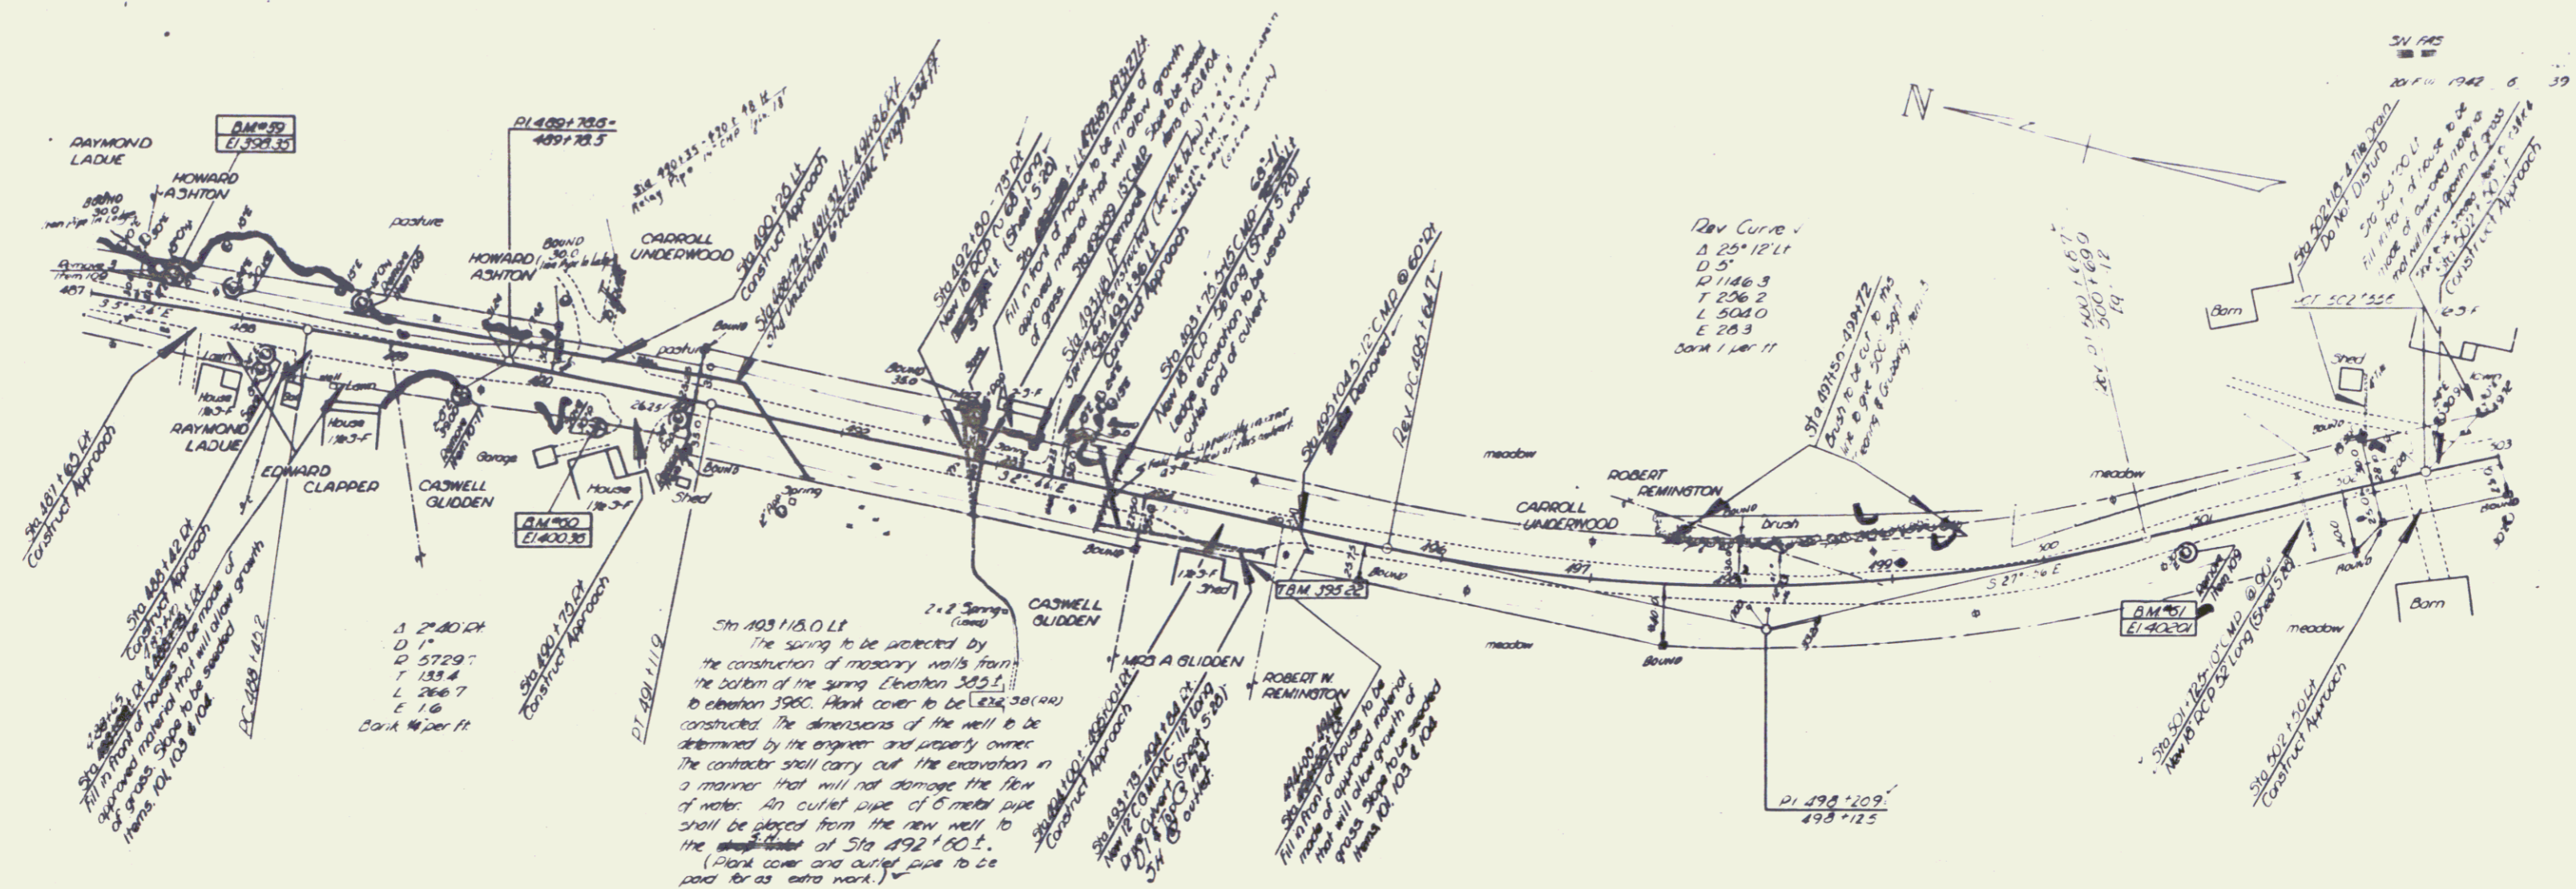

Vertical Curve

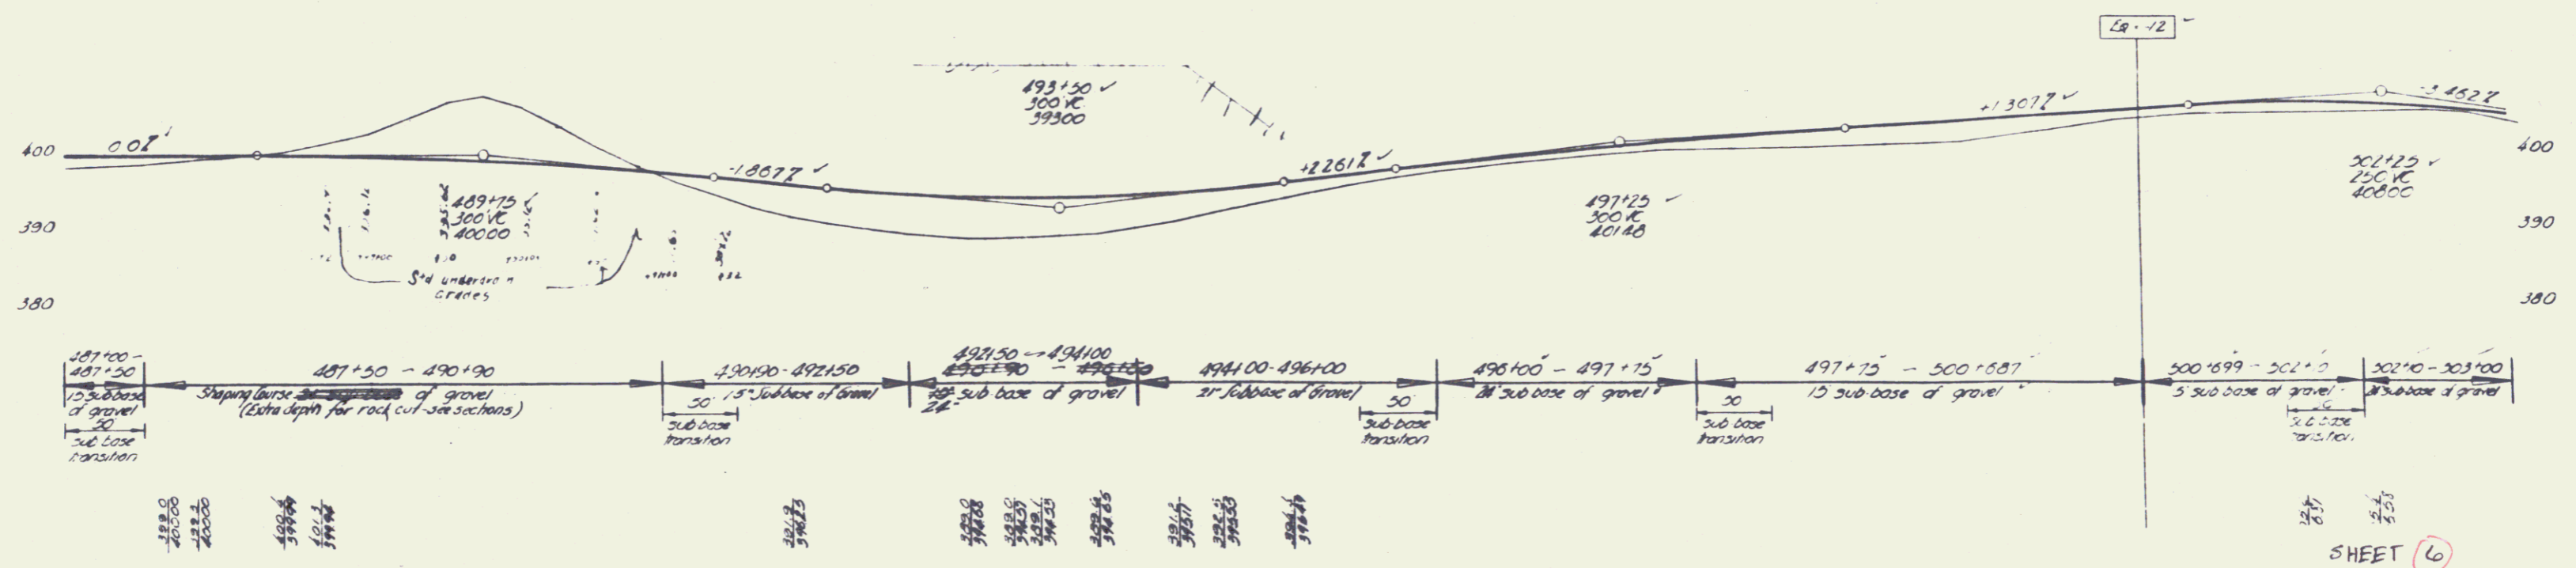

SHEET 6

4