
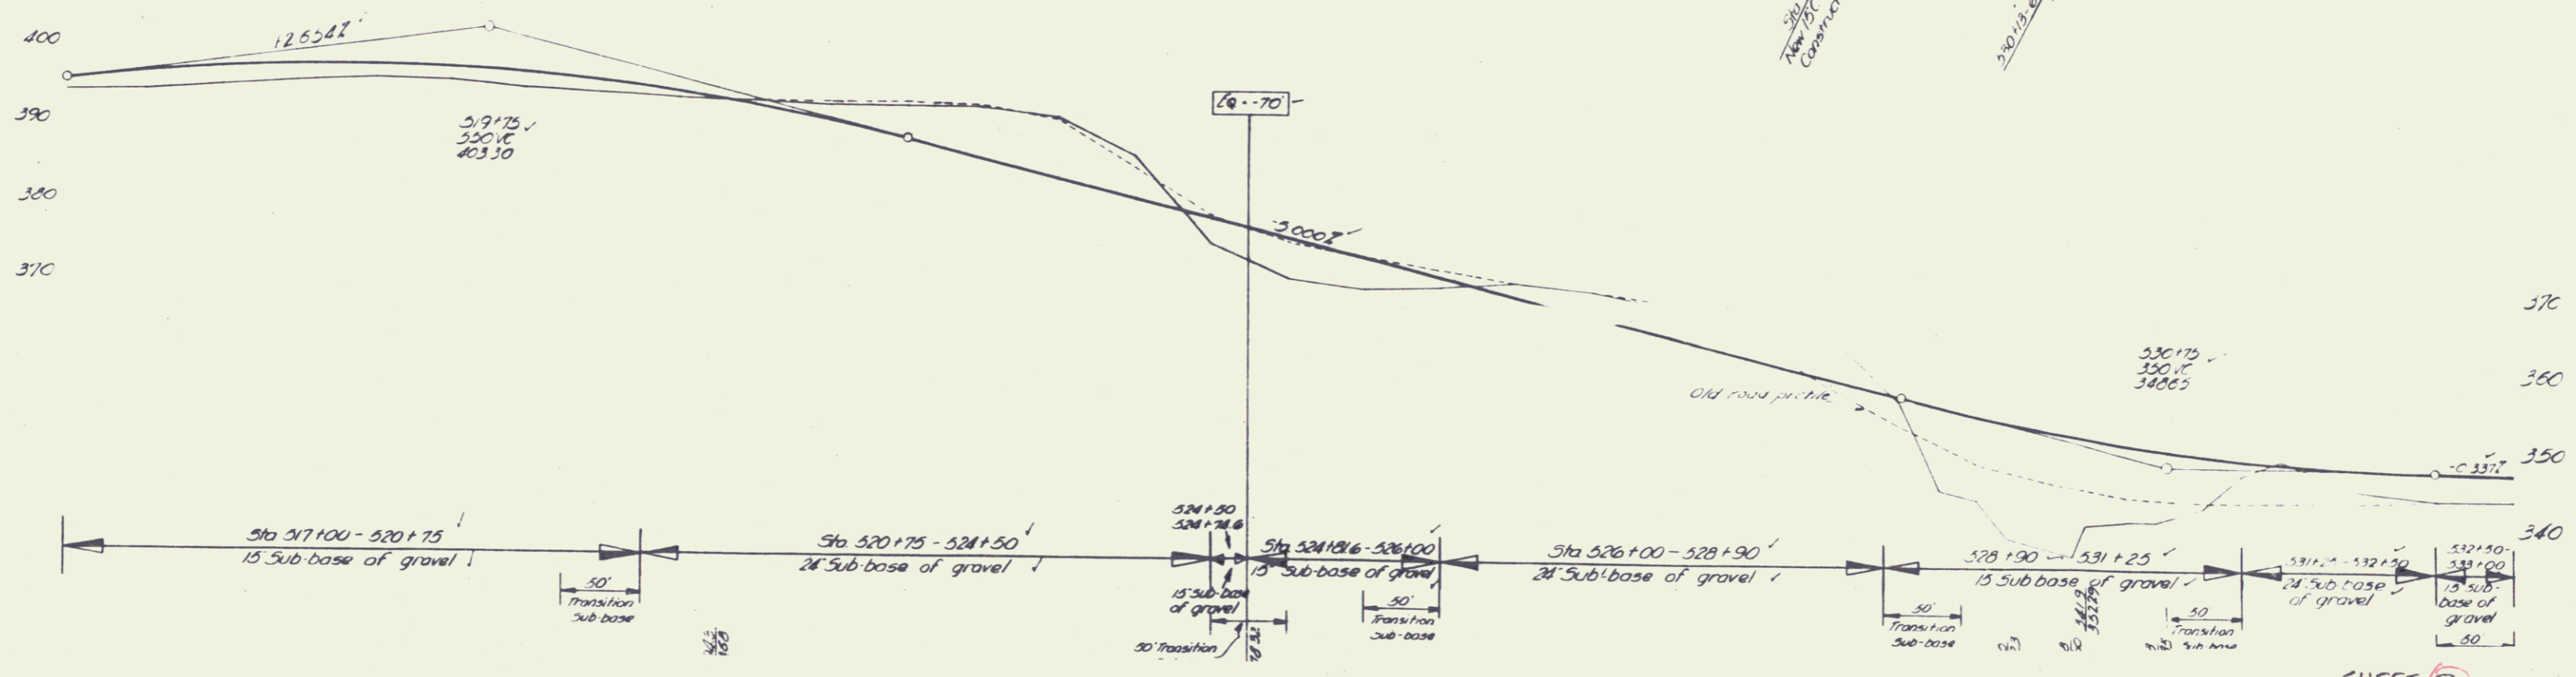


24 F45  
 2017.042 0 39

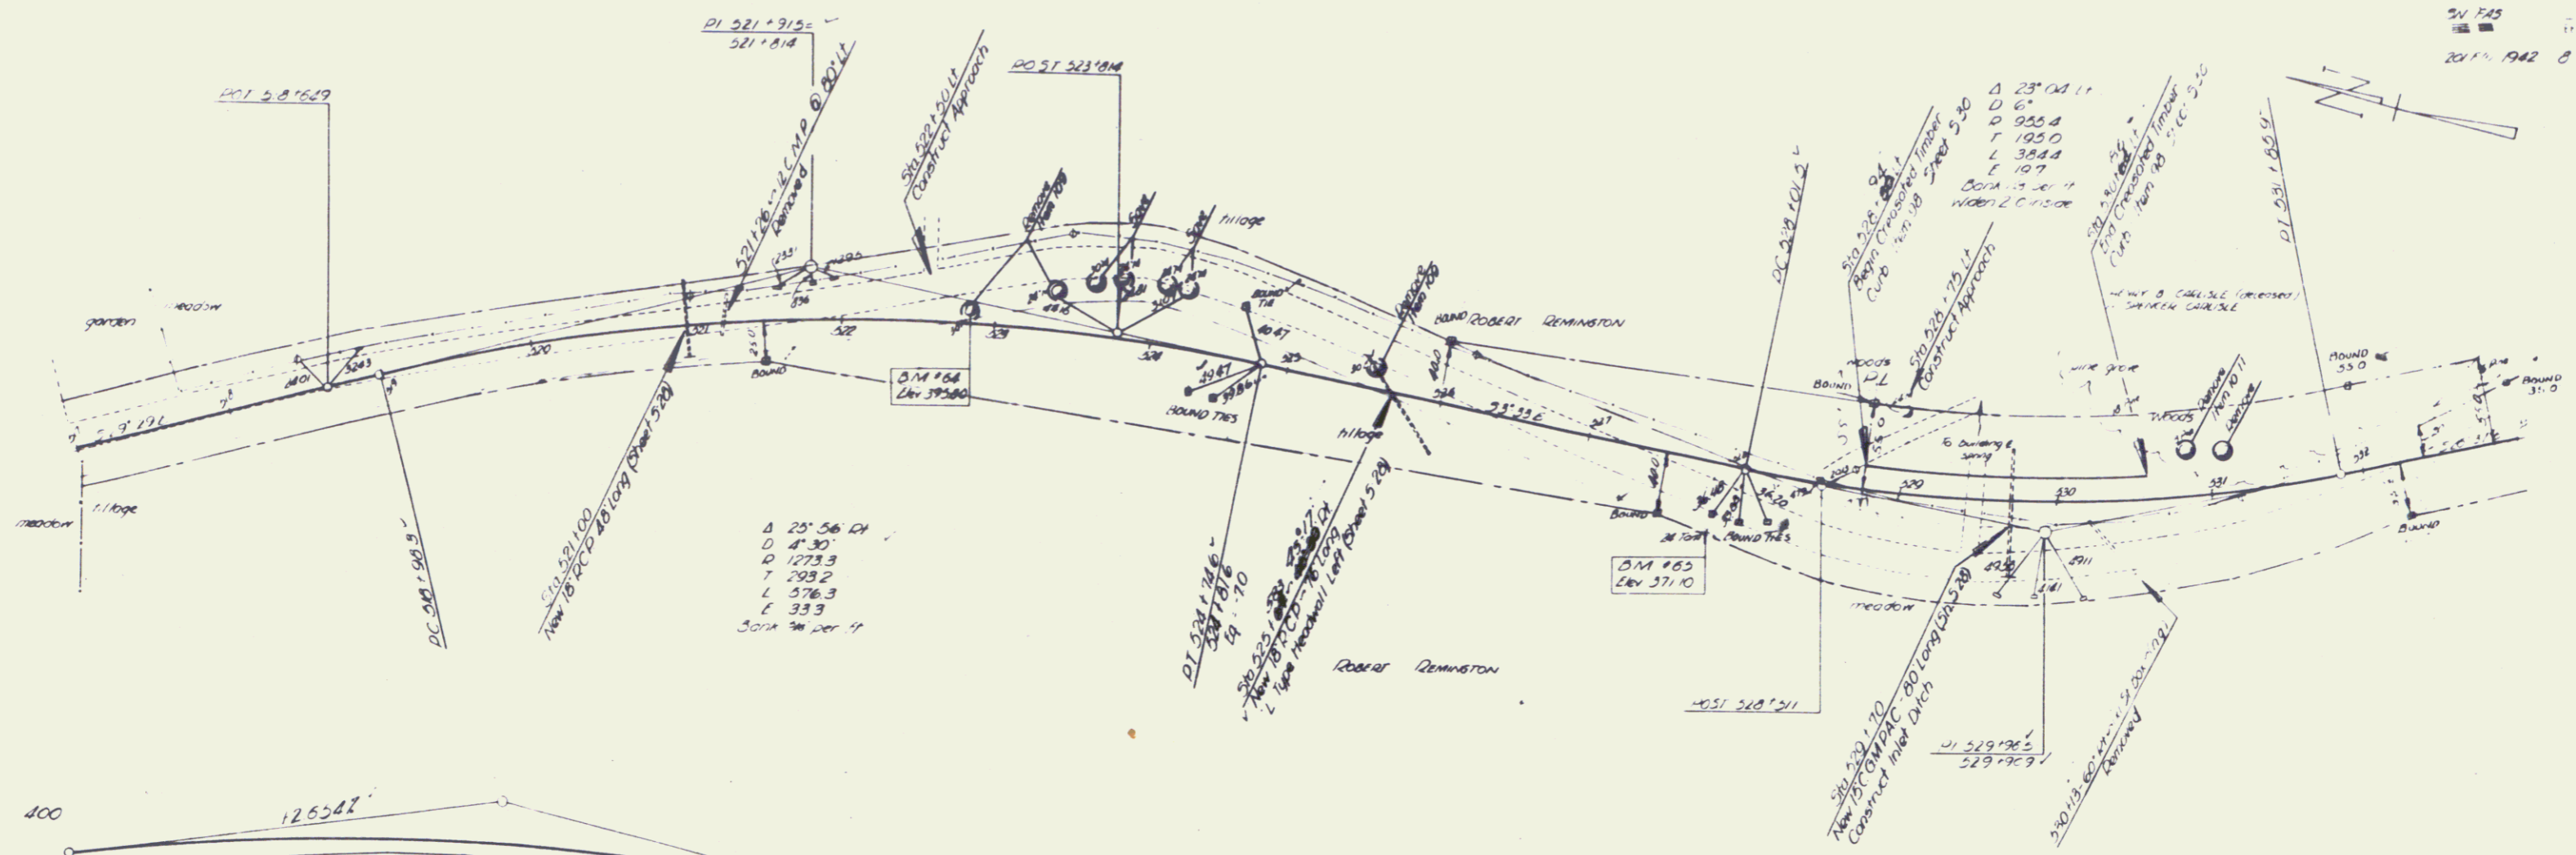

SHEET 8