

INDEX OF SHEETS

SHEET NO. 1	TITLE PAGE
2	TYPICAL CROSS-SECTION OF IMPROVEMENT
3	BANKING AND WIDENING TABLES
4	SUMMARY OF QUANTITY SHEET - ITEMS
5-6	QUANTITY SHEET - DRAINAGE STRUCTURES
7-16	EARTHWORK SHEETS
17-25	PLAN AND PROFILE
26	DETAILS OF 16 X 7 BOX CULVERT
27	STANDARD STRUCTURE SHEET
28	S 28 HEAD WALLS
29	S 30 GUARD RAIL
30	S 30-A UNDER DRAIN
31	S 40 BARRICADES, SIGNS, & LIGHTS
32	S 41 ROUNDING SLOPES
33	S 49-47 CATCH BASINS
34	SB II BARRICADES, SIGNS, & LIGHTS
35	DWG SB2-1 SUPERSTRUCTURE 30' ROADWAY
36	DWG SB5C-1 RAILING
37	DWG SB 20 "D", "J", "I" DETAILS
38	DWG SLAG SQUARE, 30' ROADWAY
39	DWG SLAG 15° ASKEW, 30' ROADWAY
39A	DWG SLAG 30° ASKEW, 30' ROADWAY
39B	DWG SLAG 45° ASKEW, 30' ROADWAY
39C	DETAILS OF ALTERATIONS ON VALVE BOXES STA. 22+06 & 25+12
39D	RESERVOIR STA. 30+30
39E	SPRING BOX STA. 31+60 RT.
40-69	CROSS SECTIONS

STANDARD STRUCTURE SHEETS APPROVED BY THE CHIEF ENGINEER VERMONT STATE DEPT. OF HIGHWAYS

S 28	APRIL 26, 1941
S 30	NOV. 10, 1947
S 30A	APRIL 19, 1941
S 40	DEC. 18, 1945

STATE OF VERMONT
STATE HIGHWAY DEPARTMENT


PLAN AND PROFILE OF PROPOSED
STATE HIGHWAY

SECONDARY PROJECT
TOWN OF CHELSEA
CHELSEA - FAIRLEE ROAD
VERMONT ROUTE 113

BEGINNING AT A POINT 50.4 FEET EASTERLY OF THE INTERSECTION OF VERMONT ROUTES 110 AND 113, AND EXTENDING EASTERLY 11,895.6 FT.

LENGTH OF PROJECT 11,895.6 FEET = 2.253 MILES


FED. ROAD DIST. NO.	STATE	PROJ. NO.	SHEET NO.	TOTAL SHEETS
9	VT.	5176(2)	1	69

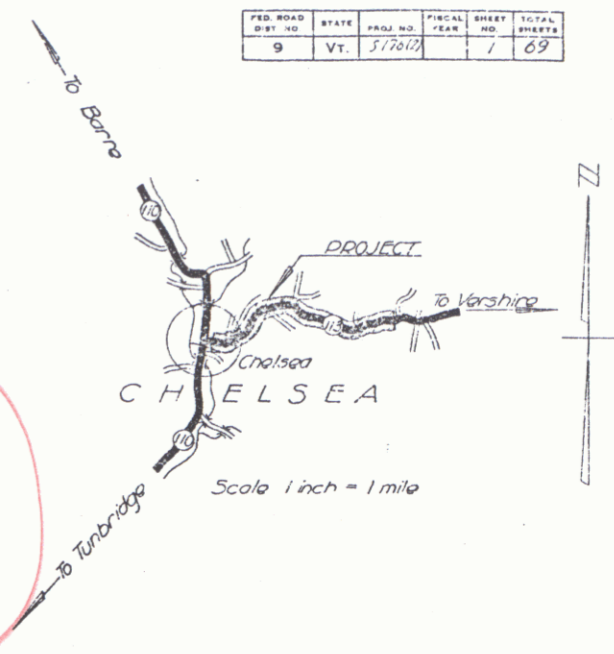

PROJECT: S176(2)
Route: VT 113
Town: Chelsea
P.N. 00R447
Date: 07/09/1948


RIGHT-OF-WAY DIVISION
TOWN FILE
PERPETUAL
MP 2.26
STA. 127+50.0
END PROJECT S176(2)
of 4-113
(To Be Returned To R.O.W. Division)

VT 113

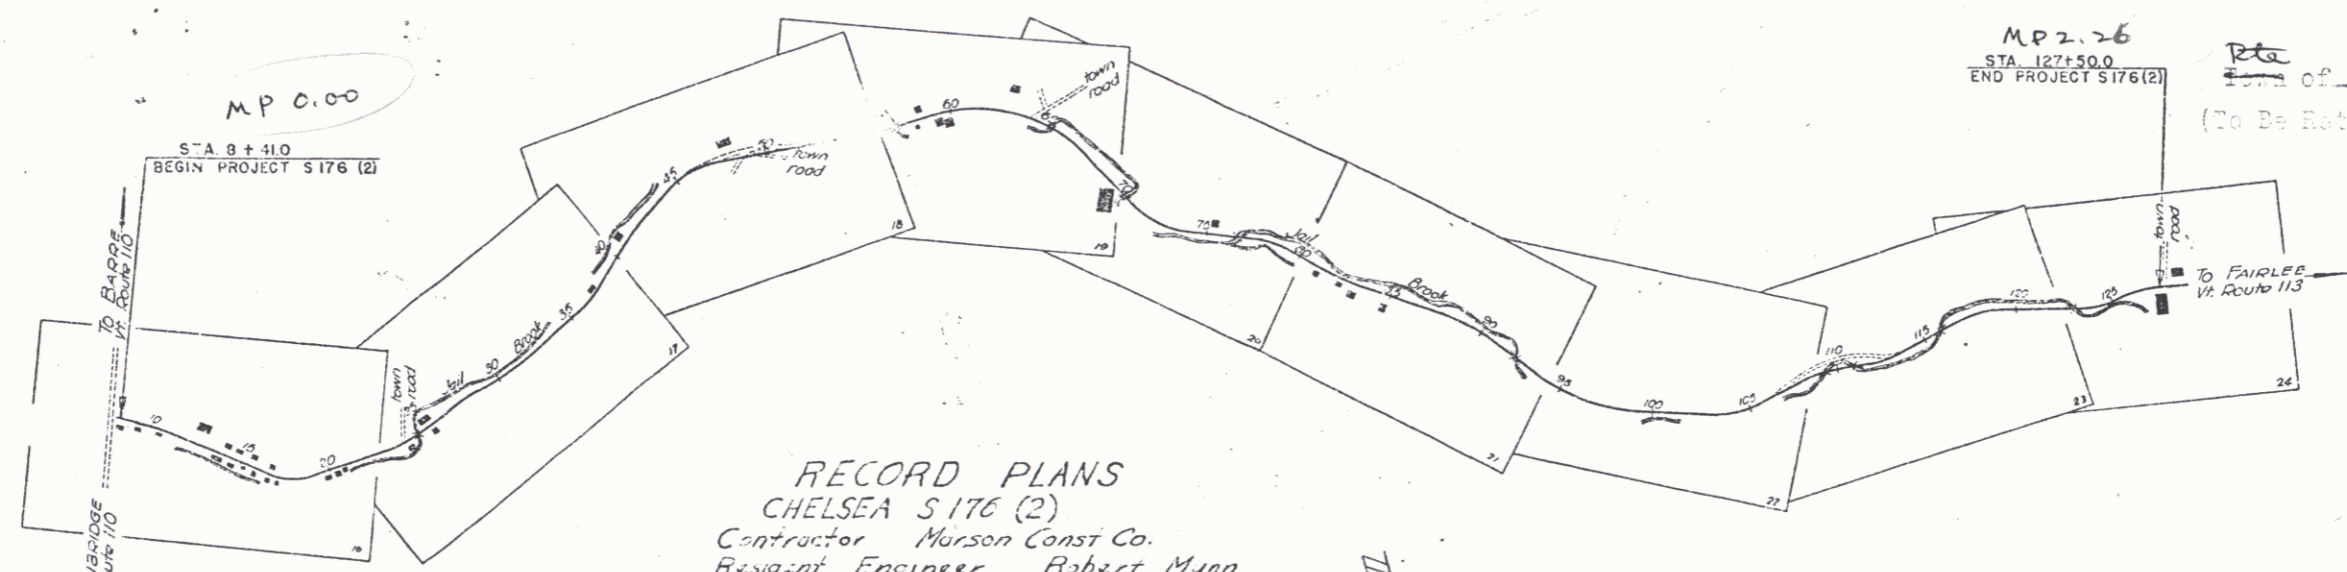

RECORD PLANS
CHELSEA S176(2)
Contractor: Marson Const. Co.
Resident Engineer: Robert Munn
Inspector: Dan Borzone

APPROVED: 26 JULY 48
H.P. Sargent
COMMISSIONER OF HIGHWAYS
SUBMITTED BY ORDER OF THE STATE HIGHWAY BOARD

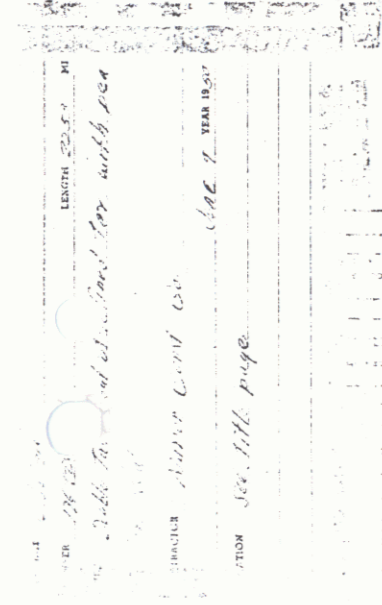

CURVE DATA

DEFLECTION ANGLE	Δ
DEGREE OF CURVE	D
RADIUS OF CURVE	R
TANGENT DISTANCE	T
LENGTH OF CURVE	L
EXTERNAL DISTANCE	E
POINT OF INTERSECTION	P. I.
POINT OF CURVE	P. C.
POINT OF TANGENT	P. T.
POINT ON TANGENT	P. O. T.

SCALES

TITLE	1" = 500'
TYPICAL	1" = 2'
PLAN	1" = 50'
PROFILE HORIZONTAL	1" = 50'
PROFILE VERTICAL	1" = 10'
CROSS SECTIONS	1" = 5'

THESE PLANS ARE SUBJECT TO SUCH REVISIONS AS MAY BE REQUIRED BY THE PUBLIC ROADS ADMINISTRATION OR THE COMMISSIONER OF HIGHWAYS.
CONSTRUCTION IS TO BE CARRIED ON IN ACCORDANCE WITH THE PLANS AND THE STANDARD ROAD AND BRIDGE SPECIFICATIONS OF 1936, AS APPROVED DECEMBER 20, 1936 BY THE PUBLIC ROADS ADMINISTRATION, INCLUDING ALL SUBSEQUENT APPROVED REVISIONS AND SUCH REVISED SPECIFICATIONS AND SPECIAL PROVISIONS AS ARE SUBMITTED WITH THE PLANS.

RECOMMENDED FOR APPROVAL
PUBLIC ROADS ADMINISTRATION
FEDERAL WORKS AGENCY
APPROVED
PUBLIC ROADS ADMINISTRATION
FEDERAL WORKS AGENCY

APPROVED: [Signature]	APPROVED: [Signature]	SERIES NO. 116 FILED
[Signature]	[Signature]	SHEET 1 OF 69