


CONSTRUCT DRIVES

LT	RT
11-16	9-100
12-12	10-107
10-197	12-100
10-12	13-113
	14-130
	15-135
	16-124

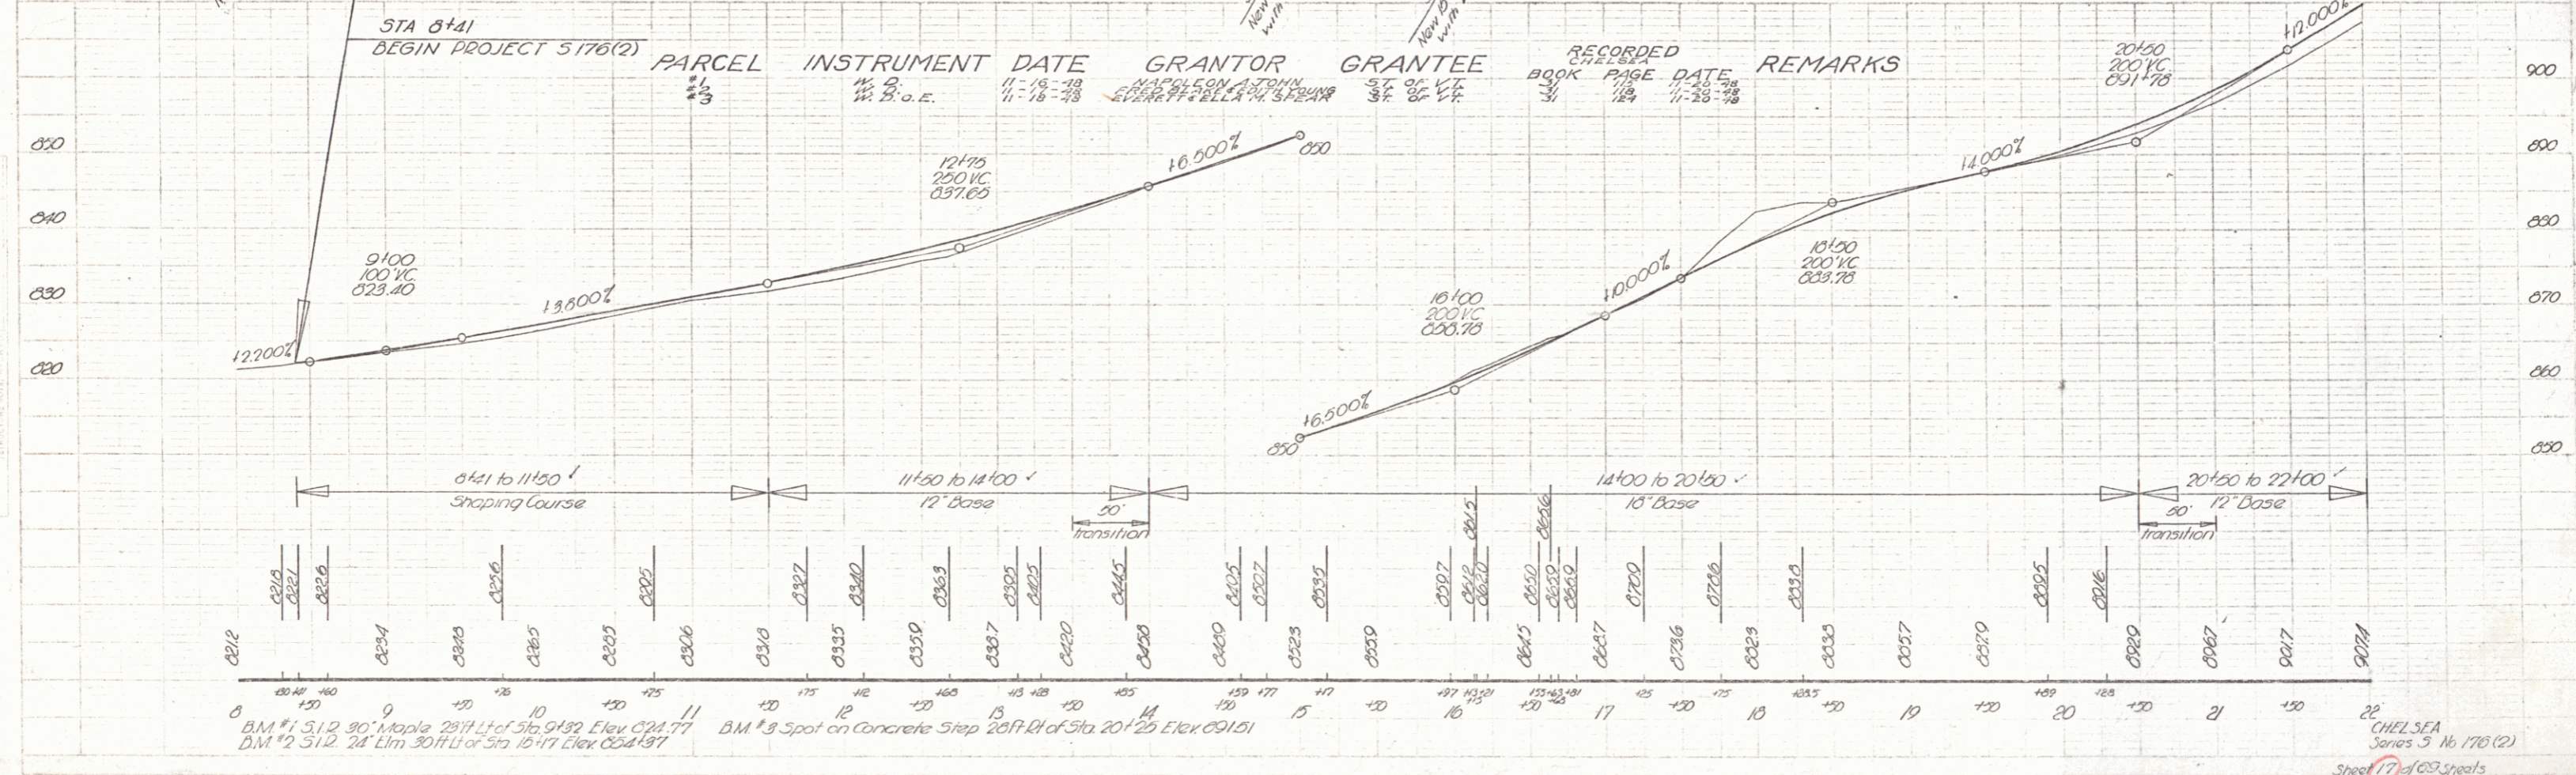

STA 0+41 BEGIN PROJECT 5176(2)

PARCEL INSTRUMENT DATE GRANTOR GRANTEE RECORDED BOOK PAGE DATE REMARKS

11-18-78 11-18-78 SPENCER & ELLA M. SPEAR 37 36 VT 31 124 11-25-78

12+70 to 13+00 13+00 to 14+00 14+00 to 16+00 16+00 to 20+00 20+00 to 22+00

Shaping Course 17' Base 18' Base 17' Base

50' transition 50' transition

BM #1 30' Maple 2811' Lot of Sta. 9+92 Elev. 024.77
 BM #2 24' Elm 311' Lot of Sta. 10+47 Elev. 024.97
 BM #3 Spot on Step 2017' Elev. of Sta. 20+20 Elev. 021.01

CHELSEA Series 3 No 176(2) Sheet 17 of 60 sheets