



CONSTRUCT APPROACH
49 + 22 to Town Road
CONSTRUCT DRIVES
40 + 17 42 + 30
40 + 25 42 + 30

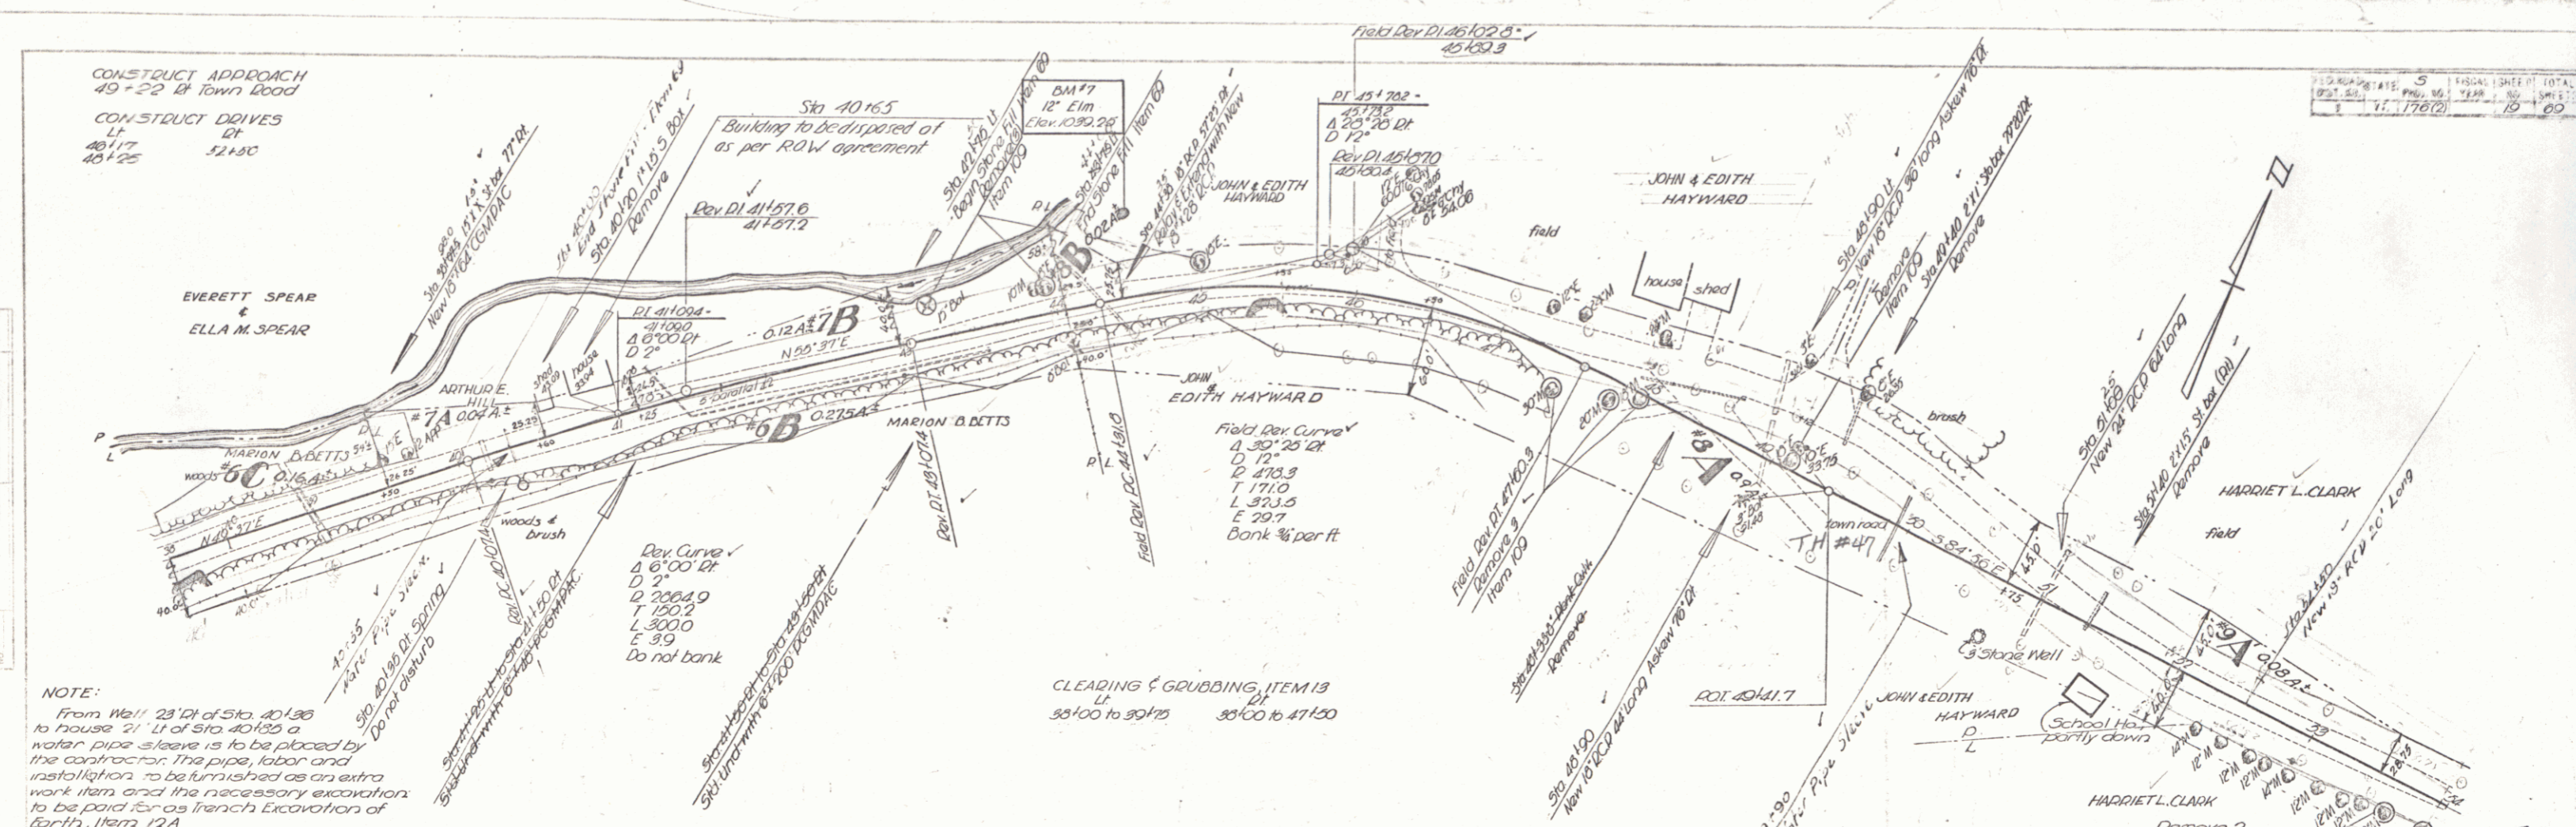

NOTE:
From Well 23' DI of Sta. 40+30 to house 21' DI of Sta. 40+125 a water pipe sleeve is to be placed by the contractor. The pipe, labor and installation to be furnished as an extra work item and the necessary excavation to be paid for by trench excavation of earth, item 12A

CLEARING & GRUBBING, ITEM 13
38+00 to 39+75 39+00 to 41+50

PARCEL	INSTRUMENT	DATE	GRANTOR	GRANTEE	RECORDED BOOK	RECORDED PAGE	RECORDED DATE	REMARKS
8A, B, & C	W. D.	11-18-48	MARION B. BETTS	ST. OF VT.	31	120	11-23-48	
8A & B	W. D. & E.	11-30-48	ARTHUR E. HILL	"	31	128	12-3-48	
8A & B'	W. D.	1-10-49	JOHN & EDITH HAYWARD	ST. OF VT.	31	135	1-18-49	
8A & B' (Shed)	W. D.	11-20-48	HARRIET L. CLARK	ST. OF VT.	31	132	12-15-48	

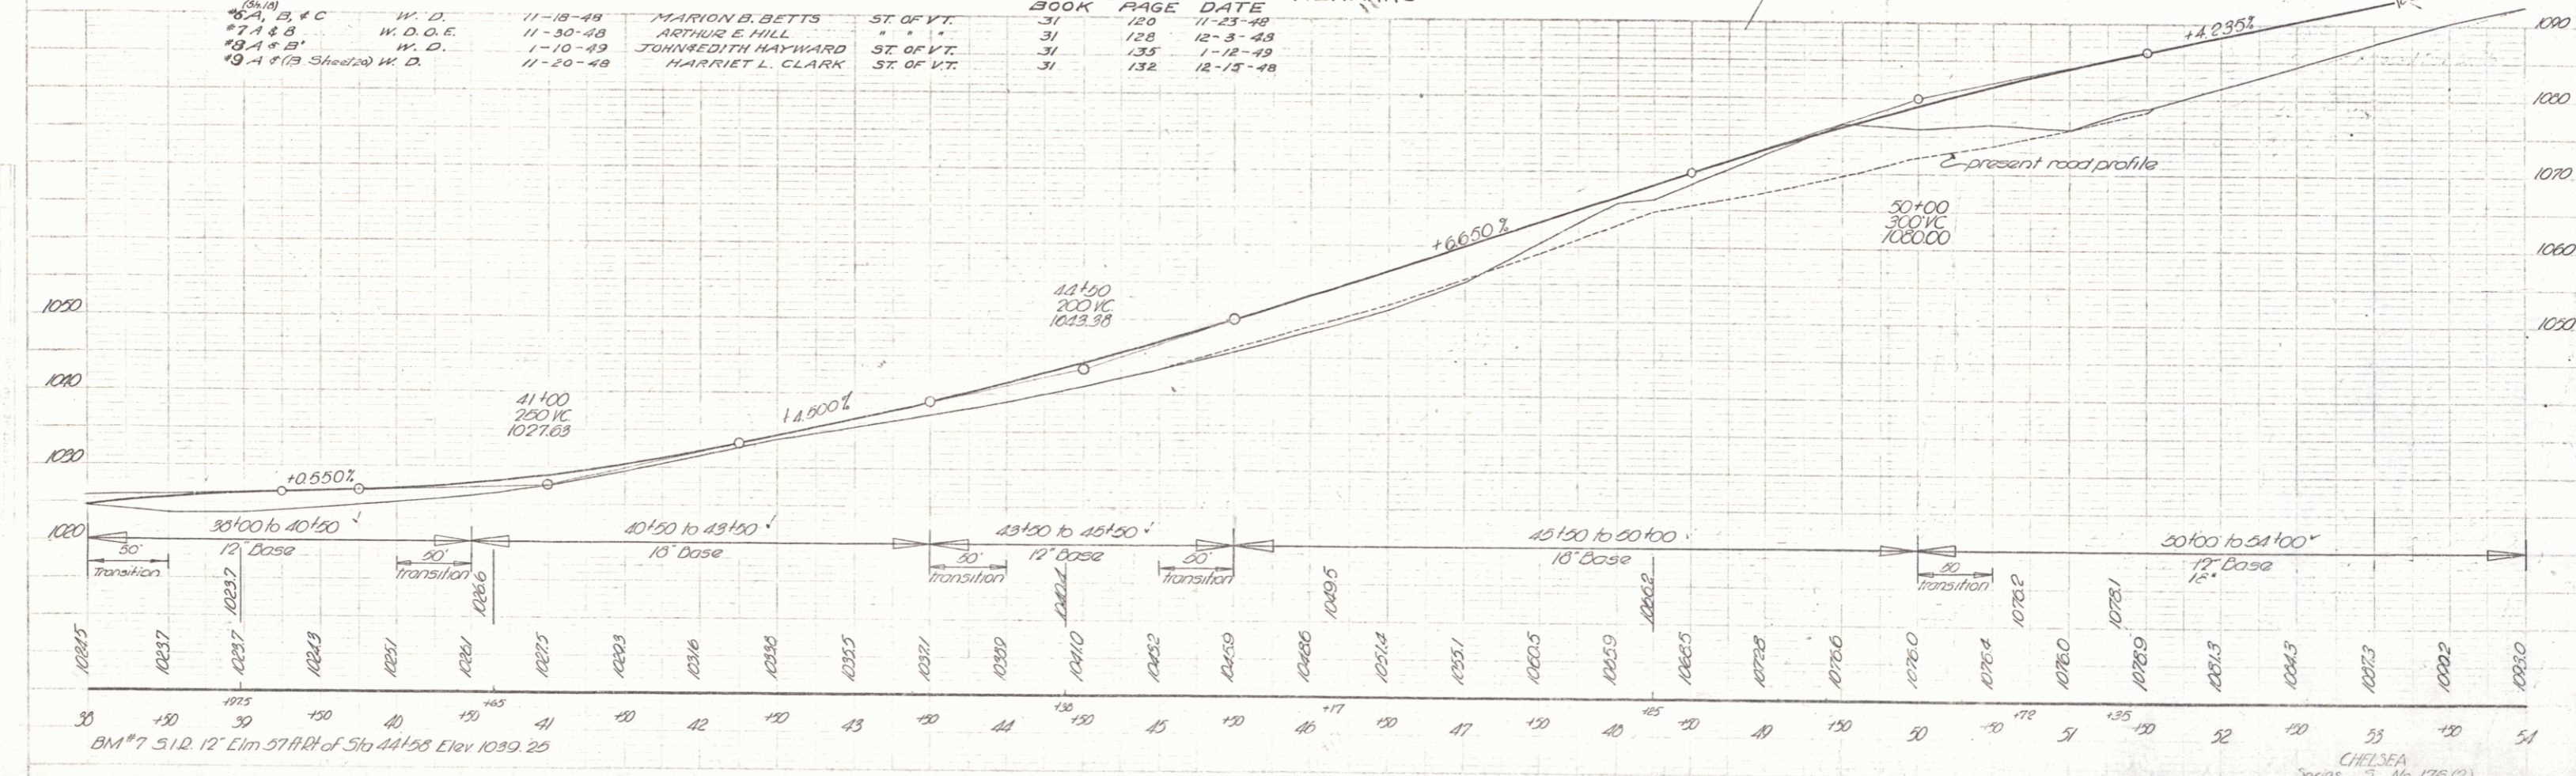

BM #7 51 D. 12' Elm 57' RR of Sta 44+95 Elev 1039.25

CHLSEA
Series No 176 (2)
Sheet 19 of 19 Sheets