

CONSTRUCT DRIVES

Sta	Pos.
553+25	RM
561+50	RM
563+33	RM
566+50	LR
566+64	RT
571+87	RT

36 JOHN DARLING
SLOPE RIGHTS - 563+00-564+00
W.D.O.E. 8/15/56
RECORDED - VERSHIRE - BK25-PG24-8/29/56

37A FLOYD S. & ALICE MATTOON
(A.O.C. 2) STA 566+00-566+50
W.D.O.E. 8/15/56
RECORDED - VERSHIRE - BK25-PG26-8/29/56

37B FLOYD S. & ALICE MATTOON
(A.O.C. 2) STA 573+00-578+00
W.D.O.E. 8/15/56
RECORDED - VERSHIRE - BK25-PG26-8/29/56

A 16'-43" LH
D 6"
R 255.4
T 140.4
L 278.6
E 10.2
Bank 1/4 per ft.

36 JOHN DARLING
SLOPE RIGHTS - 563+00-564+00
W.D.O.E. 8/15/56
RECORDED - VERSHIRE - BK25-PG24-8/29/56

37A FLOYD S. & ALICE MATTOON
(A.O.C. 2) STA 566+00-566+50
W.D.O.E. 8/15/56
RECORDED - VERSHIRE - BK25-PG26-8/29/56

37B FLOYD S. & ALICE MATTOON
(A.O.C. 2) STA 573+00-578+00
W.D.O.E. 8/15/56
RECORDED - VERSHIRE - BK25-PG26-8/29/56

563+25 - 564+78 LH
Resume and End Three Cable Guard Rail with
Steel Posts, Item 543

36 JOHN DARLING
SLOPE RIGHTS - 563+00-564+00
W.D.O.E. 8/15/56
RECORDED - VERSHIRE - BK25-PG24-8/29/56

37A FLOYD S. & ALICE MATTOON
(A.O.C. 2) STA 566+00-566+50
W.D.O.E. 8/15/56
RECORDED - VERSHIRE - BK25-PG26-8/29/56

37B FLOYD S. & ALICE MATTOON
(A.O.C. 2) STA 573+00-578+00
W.D.O.E. 8/15/56
RECORDED - VERSHIRE - BK25-PG26-8/29/56

POST 565+28.7
Δ 19'-20" RH

36 JOHN DARLING
SLOPE RIGHTS - 563+00-564+00
W.D.O.E. 8/15/56
RECORDED - VERSHIRE - BK25-PG24-8/29/56

37A FLOYD S. & ALICE MATTOON
(A.O.C. 2) STA 566+00-566+50
W.D.O.E. 8/15/56
RECORDED - VERSHIRE - BK25-PG26-8/29/56

37B FLOYD S. & ALICE MATTOON
(A.O.C. 2) STA 573+00-578+00
W.D.O.E. 8/15/56
RECORDED - VERSHIRE - BK25-PG26-8/29/56

Inacc. PT 568+75.7
= 568+54.5

36 JOHN DARLING
SLOPE RIGHTS - 563+00-564+00
W.D.O.E. 8/15/56
RECORDED - VERSHIRE - BK25-PG24-8/29/56

37A FLOYD S. & ALICE MATTOON
(A.O.C. 2) STA 566+00-566+50
W.D.O.E. 8/15/56
RECORDED - VERSHIRE - BK25-PG26-8/29/56

37B FLOYD S. & ALICE MATTOON
(A.O.C. 2) STA 573+00-578+00
W.D.O.E. 8/15/56
RECORDED - VERSHIRE - BK25-PG26-8/29/56

PT 572+37.0
Δ 13'-46" RH

36 JOHN DARLING
SLOPE RIGHTS - 563+00-564+00
W.D.O.E. 8/15/56
RECORDED - VERSHIRE - BK25-PG24-8/29/56

37A FLOYD S. & ALICE MATTOON
(A.O.C. 2) STA 566+00-566+50
W.D.O.E. 8/15/56
RECORDED - VERSHIRE - BK25-PG26-8/29/56


37B FLOYD S. & ALICE MATTOON
(A.O.C. 2) STA 573+00-578+00
W.D.O.E. 8/15/56
RECORDED - VERSHIRE - BK25-PG26-8/29/56

2) Non-Boat Participation
561+49 Install sleeve for water pipe across
roadway, Item 103-A. Sleeve to be furnished
by property owner Length 7'

35 B HARRY BAILEY
(A.O.C. 2) STA 562+00-564+00
W.D.O.E. 8/15/56
RECORDED - VERSHIRE - BK25-PG32-9/8/56

BRIDGE DATA (Bc. No. 20)

TYPE	PRESENT	PROPOSED
OVERALL SPAN	41'	41'
CLEAR SPAN L TO STEAM	25'	25'
CLEAR HEIGHT	7'	7'
ROADWAY WIDTH	20'	28'
WATERWAY	175'	178'
ELEV. MAX. HIGH WATER	794.00	798.00

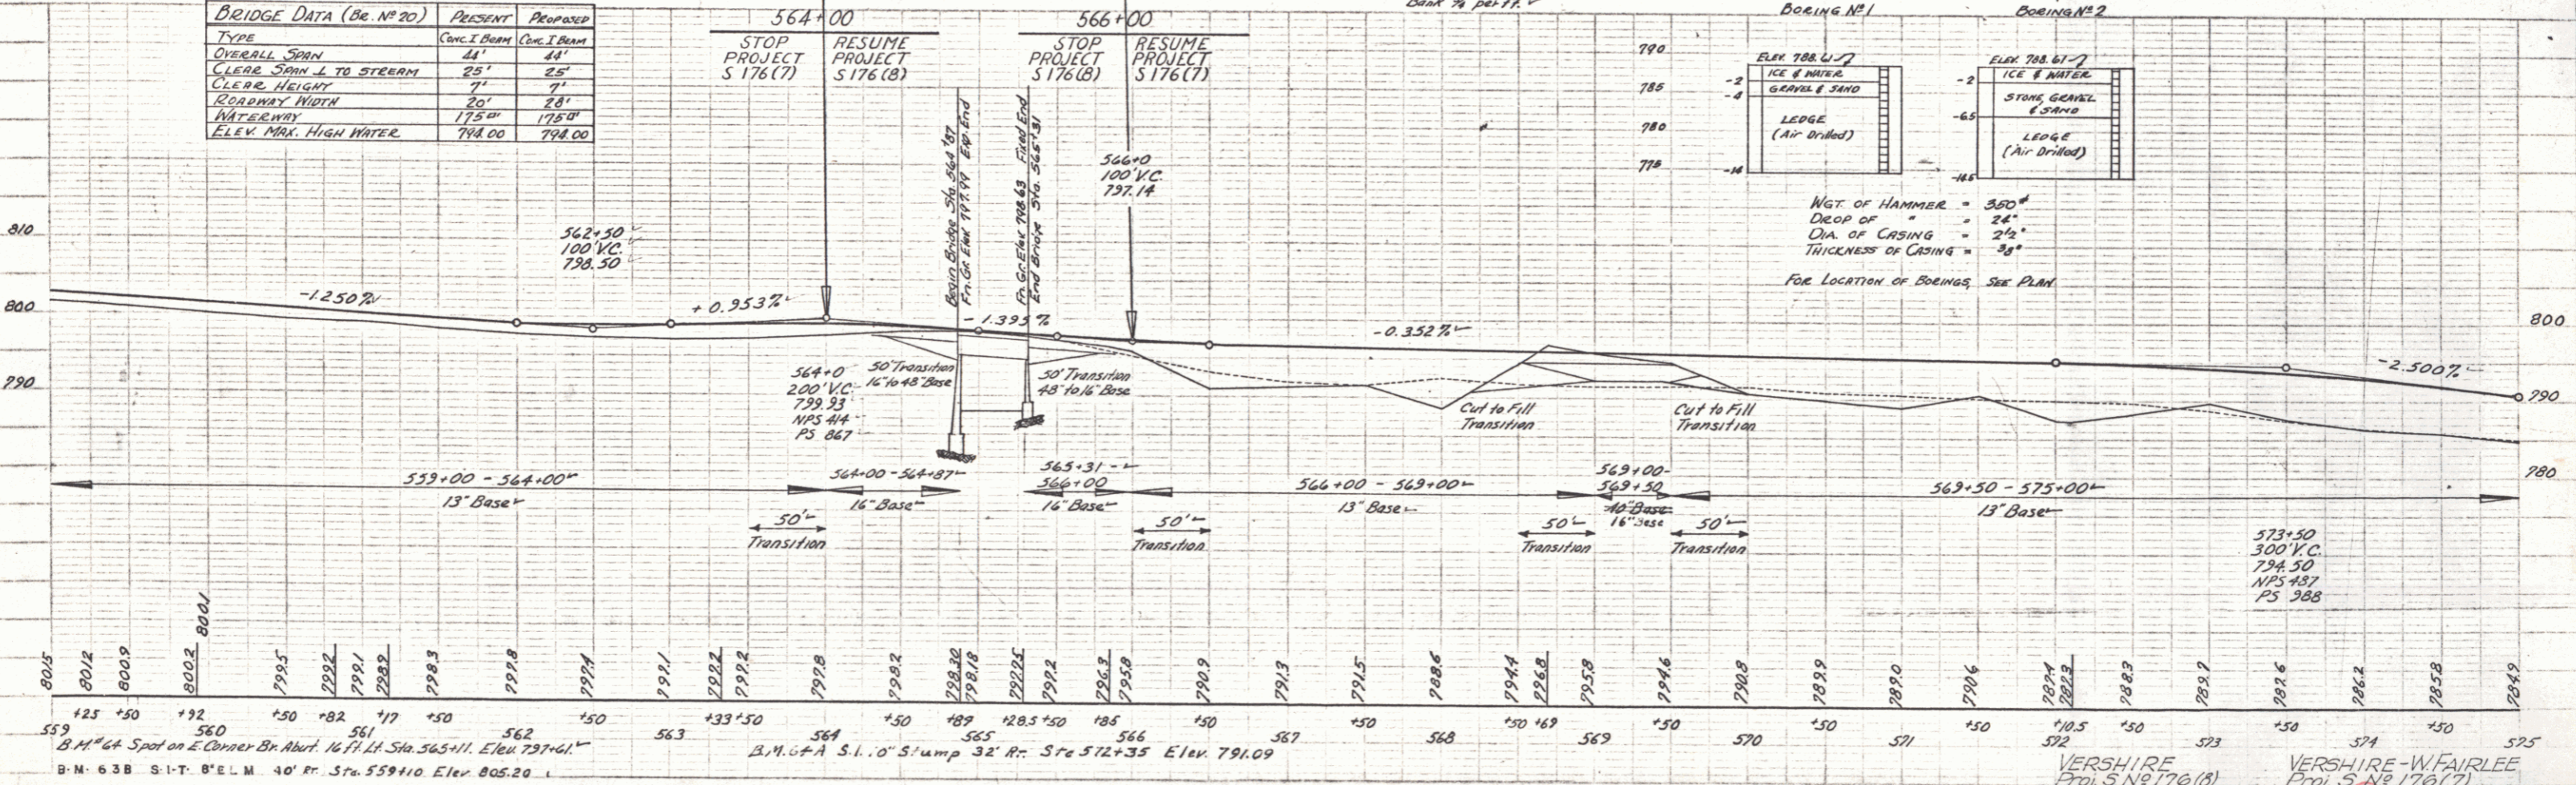

VERSHIRE
Proj. S. No. 176 (B)
Sheet 12 of 60

VERSHIRE - W. FAIRLEE
Proj. S. No. 176 (7)
Sheet 15 of 60