
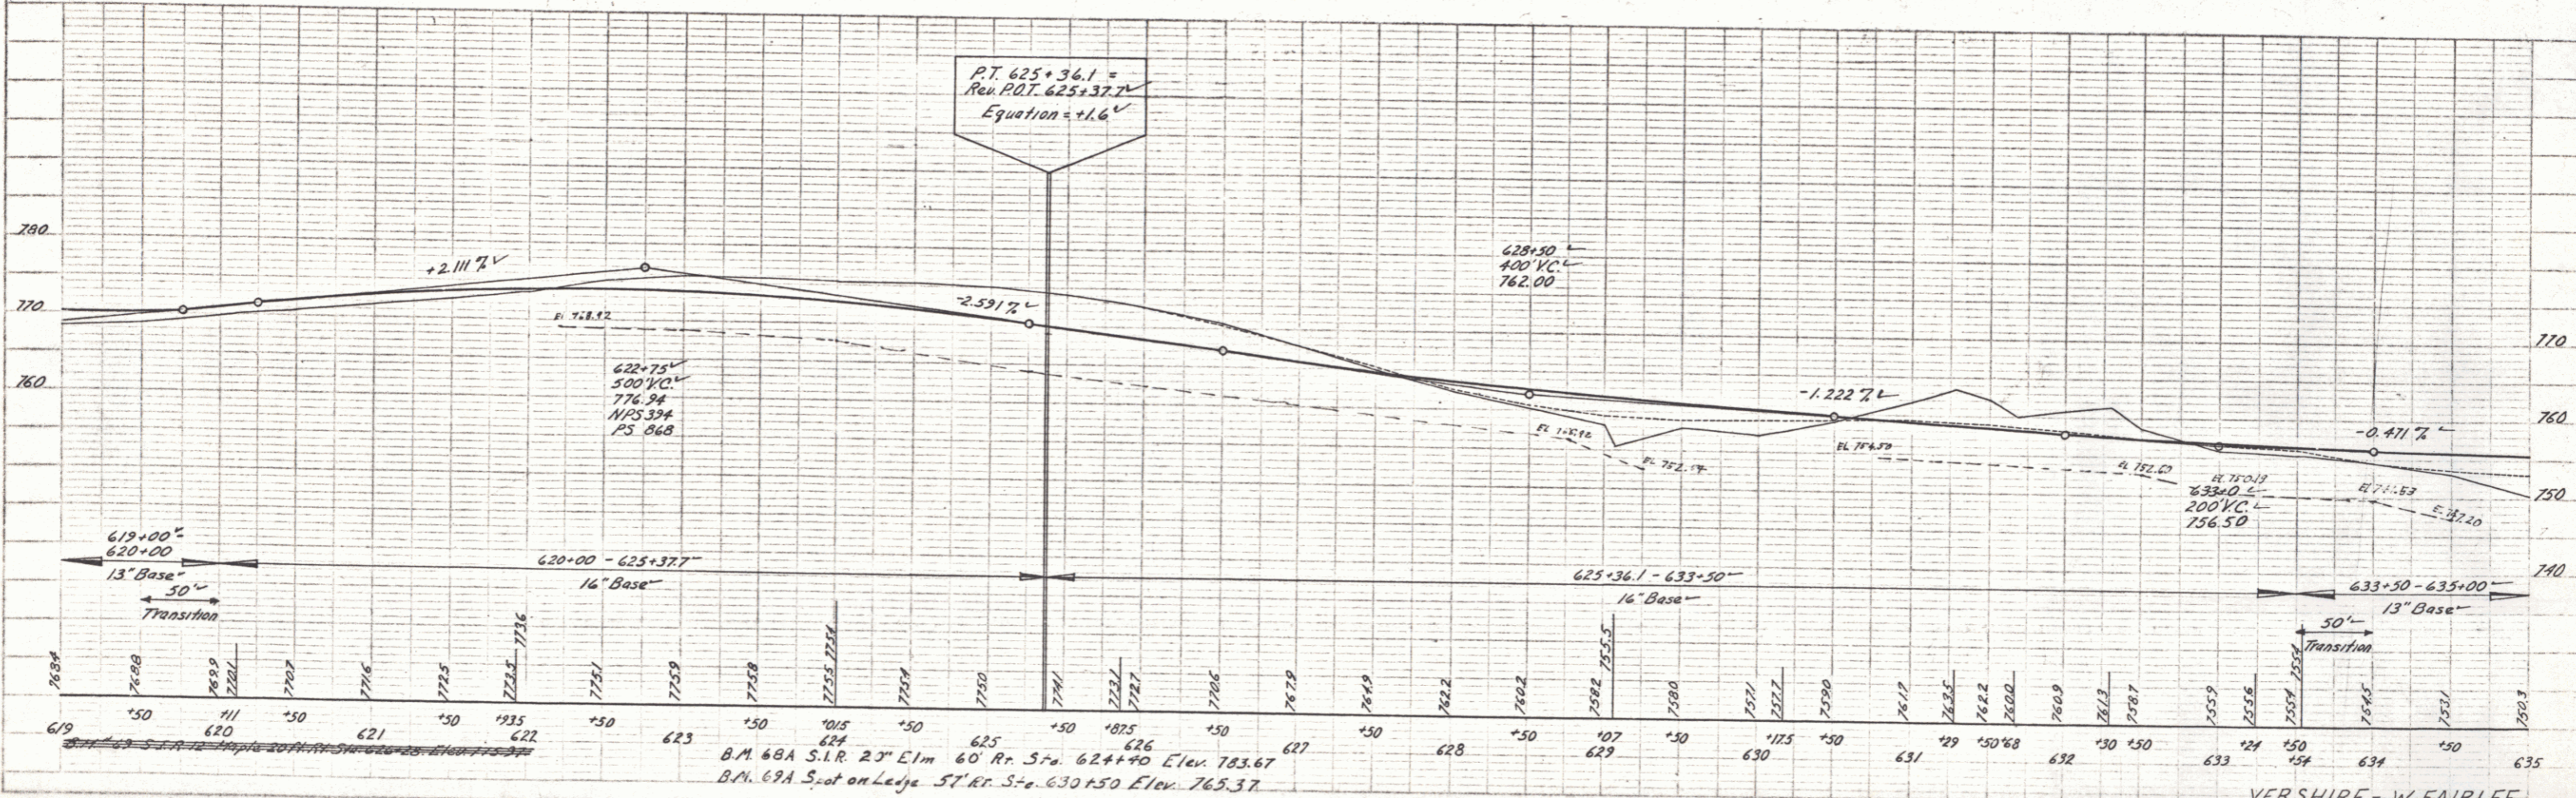


PLAN  
 DATE: 8/29/58  
 DRAWN BY: W.F. FAIRLEE  
 CHECKED BY: W.F. FAIRLEE

PROFILES  
 DATE: 8/29/58  
 DRAWN BY: W.F. FAIRLEE  
 CHECKED BY: W.F. FAIRLEE

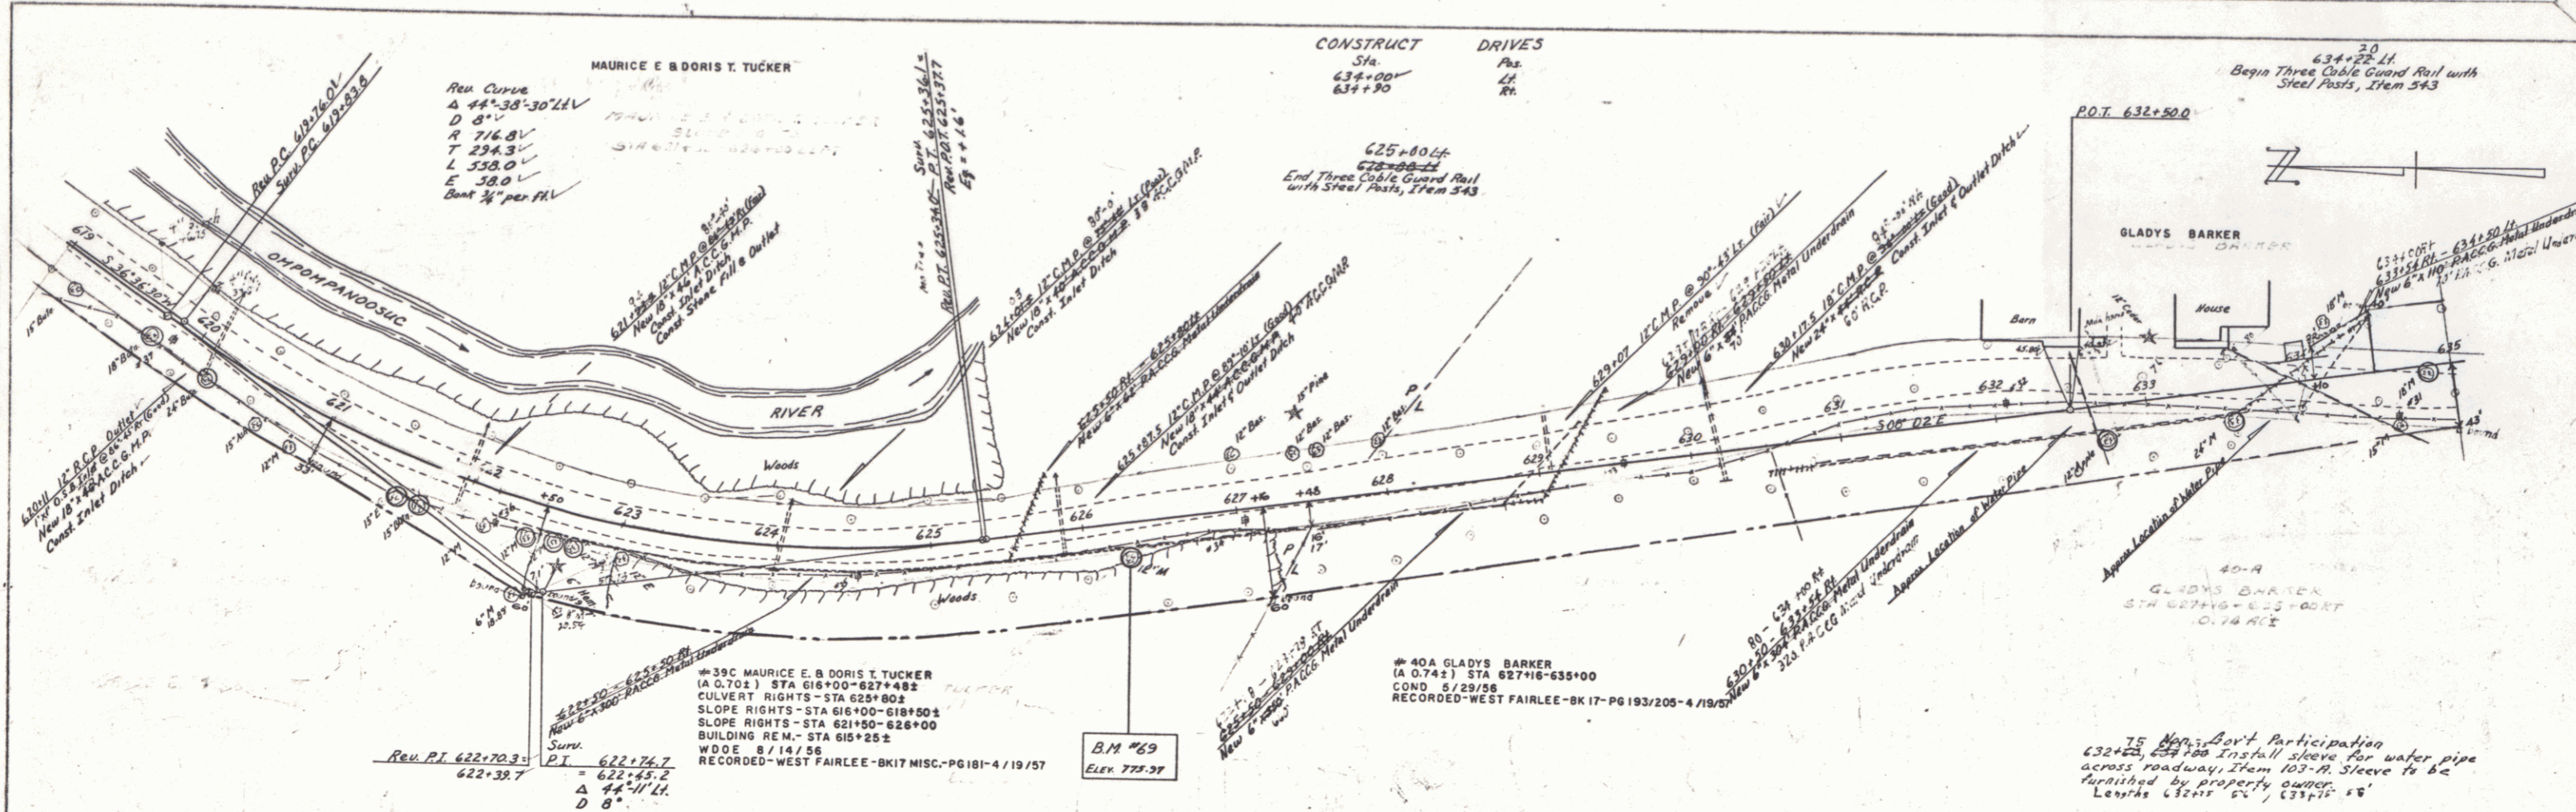

B.M. 68A S.I.R. 20' Elm 60' R. Sta. 624+40 Elev. 783.67  
 B.M. 69A Spot on Ledge 51' R. Sta. 630+50 Elev. 763.37  
 VERSHIRE - W. FAIRLEE  
 Project S-46 176 (7)  
 Sheet 19 of 68 Sheets  
 10