



Non-Govt Participation
 650+00 Install Sleeves for water pipe
 across roadway, Item 103-A.
 651+35 Sleeves to be furnished by
 property owner.
 Length 35'

PLAN
 DATE: 10-27-57
 DRAWN BY: W. FAIRLEE
 CHECKED BY: W. FAIRLEE

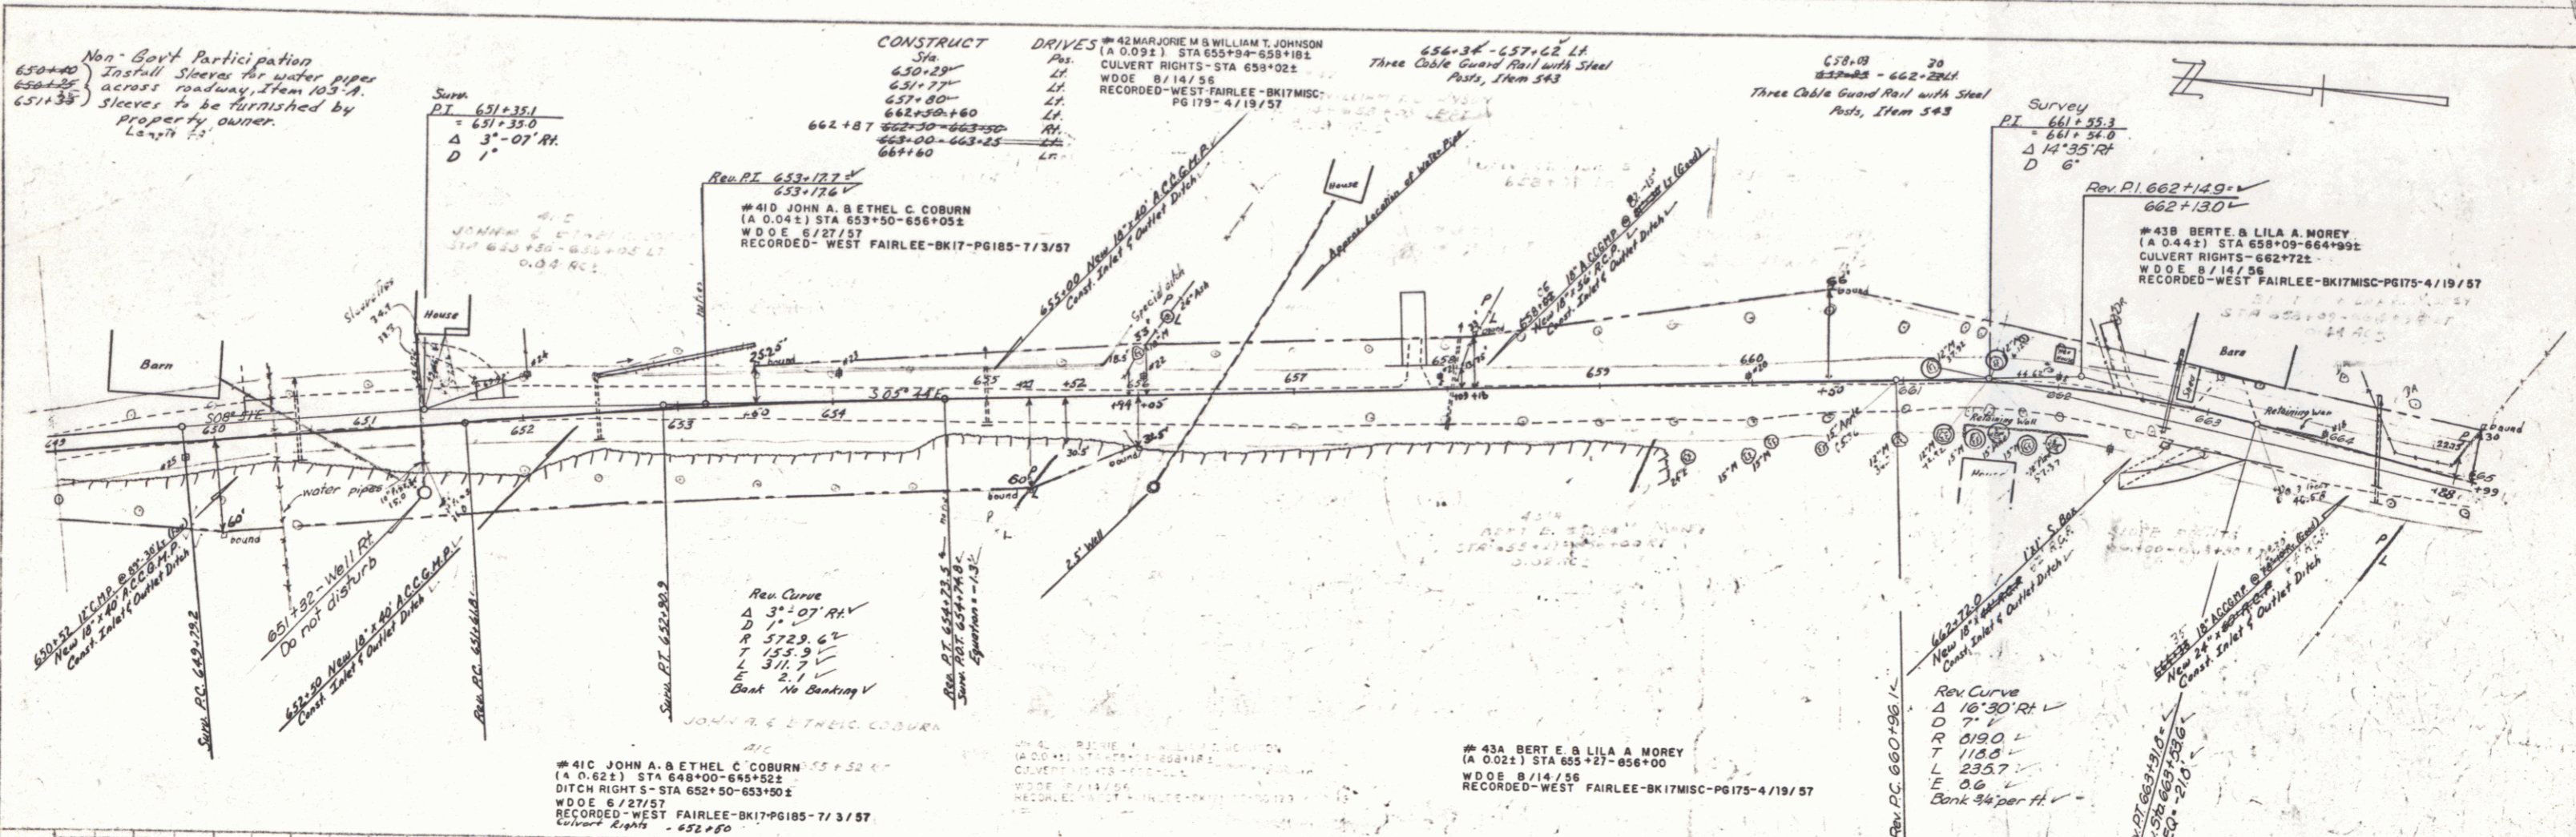

SECTION
 DATE: 10-27-57
 DRAWN BY: W. FAIRLEE
 CHECKED BY: W. FAIRLEE

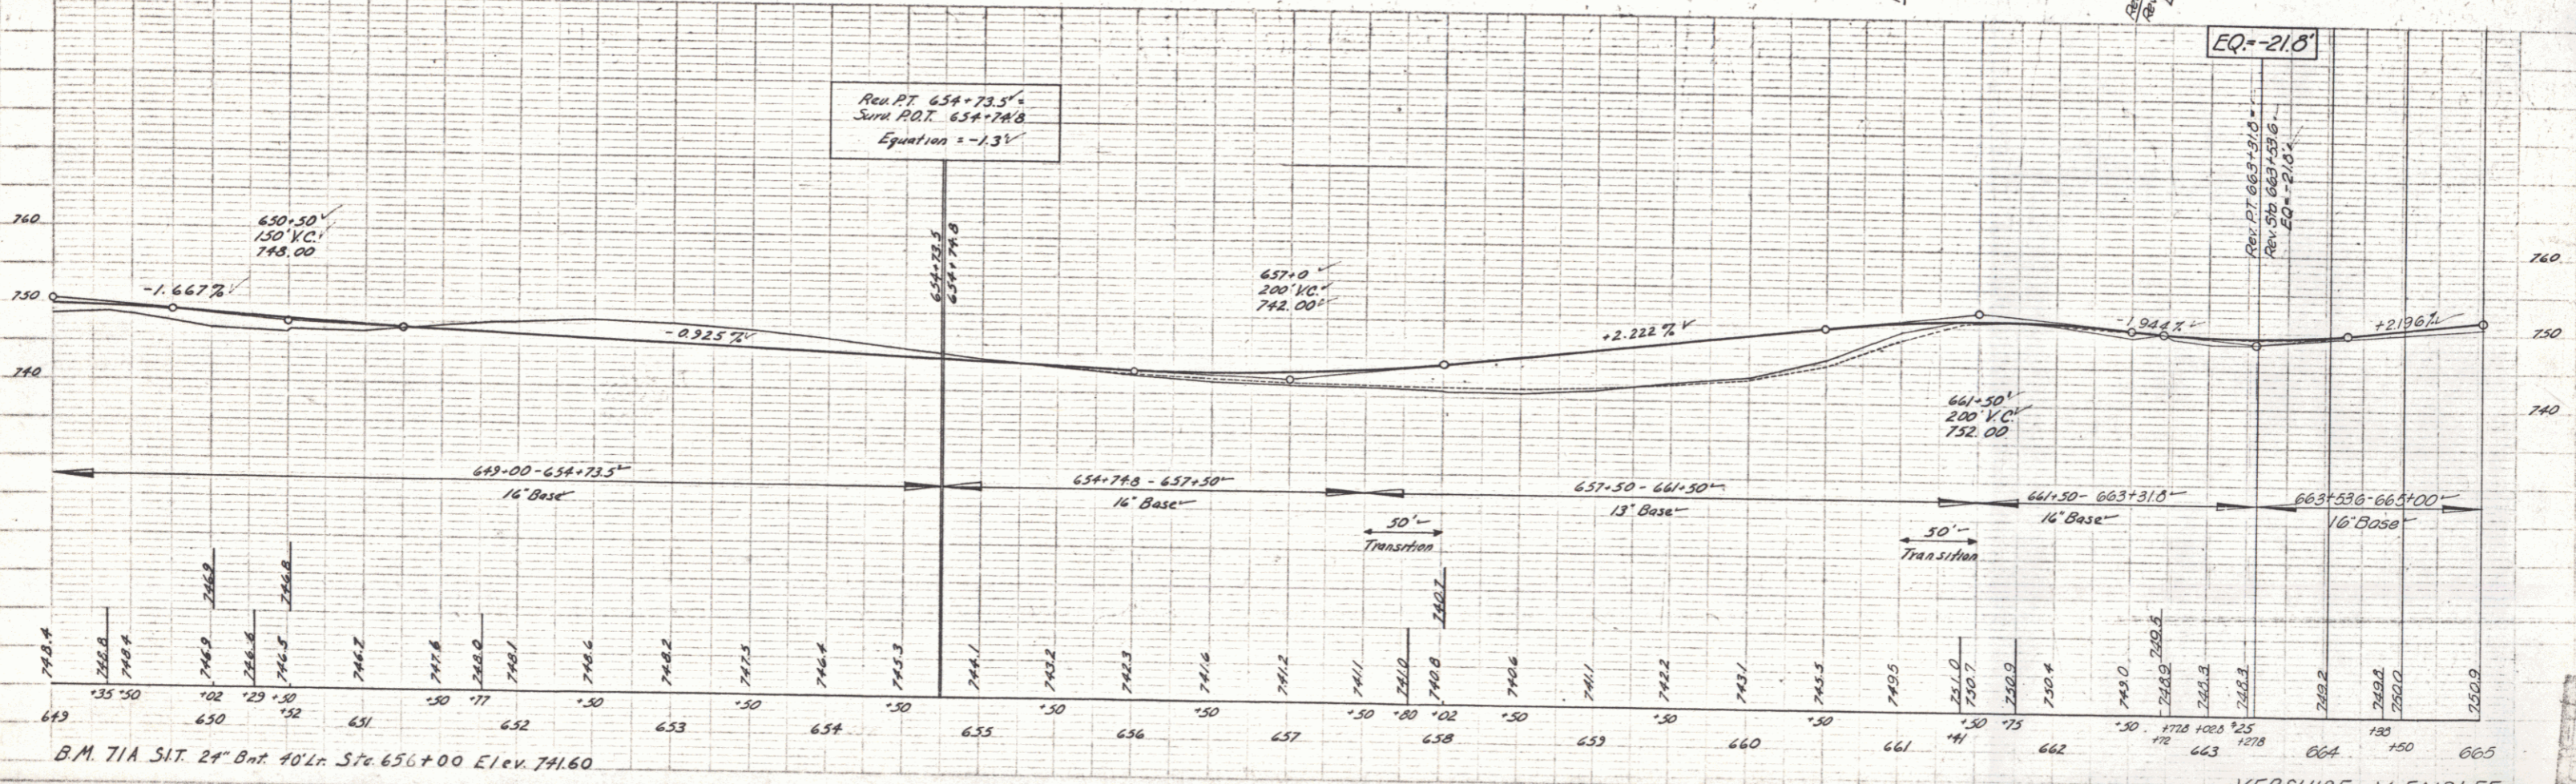

B.M. 71A Sit. 24' Bx. 40' Lx. Sta. 656+00 Elev. 741.60

VERSHERE - W. FAIRLEE.
 Project S. No. 176 (7)
 Sheet (2) of 25 sheets