

- SHEET NO. 1 TITLE PAGE  
 2 TYPICAL CROSS-SECTION OF IMPROVEMENT (DOUBLE TACK COAT OF REFINED TAR WITH PEASTONE SEAL)  
 3 ROADWAY STANDARD SHEET RS 56-1 (BANKING)  
 4 ROADWAY STANDARD SHEET RS 56-12 (BARRICADES, SIGNS AND LIGHTS) ROADWAY  
 5 QUANTITY SHEET (ITEMS)  
 6 QUANTITY SHEET (DRAINAGE)  
 7-11 EARTHWORK SHEETS  
 12-27 PLAN AND PROFILE SHEETS  
 28 ROADWAY STANDARD SHEET RS 56-3 (MARKERS)  
 29 ROADWAY STANDARD SHEET RS 56-4 (DRAINAGE)  
 30 ROADWAY STANDARD SHEET RS 56-6 (TYPICAL GRADINGS AND TURNOUTS)  
 31 ROADWAY STANDARD SHEET RS 56-11 (THREE CABLE GUARD RAIL)  
 31-A ROADWAY STANDARD SHEET RS 56-14 (P.C. R.C.P. DROP INLETS)  
 32-37 CROSS-SECTION SHEETS

PROJECT NAME & NUMBER TYPE PAVT AREA  
 VERSHIRE-S176(6) - DOUBLE TK. CT- 47969 sq. yds.  
 RECORD PLANS

MATERIALS  
 PEASTONE - WELLS LAMSON, BARRE, VT. METAL PIPE - N.E. METAL PIPE CO.  
 TAR - KOPPERS PRODUCTS CO., EVERETT, MASS. STEEL GUIDE POSTS - BETHLEHEM STEEL  
 R.C.P. - VT. CONCRETE PIPE CO. - WINDSOR GUARD RAIL - BETHLEHEM STEEL  
 Y.T. GRAVEL - WOOD PIT - COMPTON, VT.  
 CONTRACTOR - OLSON CONST. CO. CONTRACT DATED - JAN. 11, 1957  
 RESIDENT ENGINEER - JOHN R. HUGHES CONTRACT STARTED - MARCH 25, 1957  
 INSPECTOR - EARL J. CRUICKSHANK CONTRACT COMPLETED - JULY 24, 1958  
 RECORD PLANS - JOHN R. HUGHES CONTRACT ACCEPTED - JULY 24, 1958


# TOWN OF VERSHIRE COUNTY OF ORANGE CHELSEA-WEST FAIRLEE ROAD VERMONT ROUTE 113

BEGINNING AT A POINT APPROXIMATELY 9667.1 FEET EASTERLY OF THE CHELSEA  
 VERSHIRE TOWN LINE AND EXTENDING EASTERLY 21,266.3 FEET EXCLUDING BRIDGES  
 AND APPROACHES

LENGTH OF ROADWAY 19,176.4 FEET = 3.6319 MILES 20765.2 FEET = 3.9328 MILES  
 LENGTH OF PROJECT 19,176.4 FEET = 3.6319 MILES 20765.2 FEET = 3.9328 MILES



MP 1.83  
 STA. 286+35  
 BEGIN PROJECT S176(6)  
 TO CHELSEA  
 STA. 497+50  
 END PROJECT S176(6)  
 MP 5.86

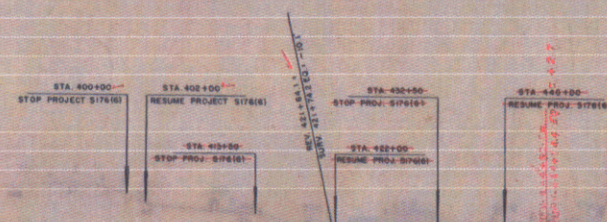

Project - S176(6)  
 Length - 21,266.3 feet  
 Date - 11/20/56  
 Design - John R. Hughes  
 Construction - Vershire  
 Pin - OOR 449

PROJECT VERSHIRE  
 ROUTE S. 176(6)  
 LENGTH 3.9328 MI.  
 TYPE DOUBLE TACK COAT OF REFINED TAR WITH P.E.A.  
 STONE SEAL SUBBASE OF CRUSHED GRAVEL FINE  
 GRADED  
 CONTRACTOR OLSON CONST. CO.  
 YEAR 1958  
 LOCATION CHELSEA WEST FAIRLEE ROAD VERMONT ROUTE 113  
 BEGINNING AT A POINT APPROXIMATELY 9667.1 FEET EASTERLY OF THE  
 CHELSEA - VERSHIRE TOWN LINE AND EXTENDING EASTERLY 21,266.3 FEET  
 EXCLUDING BRIDGES AND APPROACHES

VERSHERE S176(6)  
 CONTRACTOR - OLSON CONST. CO.  
 RECORD PLANS - J.R. HUGHES  
 CONTRACT COMPLETED - JULY 24, 1958

1000'  
 50'  
 10'

CONSTRUCTION OF JANUARY 1956, AS APPROVED BY THE BUREAU  
 OF PUBLIC ROADS JULY 5, 1956 INCLUDING ALL SUBSEQUENT  
 APPROVED REVISIONS AND SUCH REVISED SPECIFICATIONS AND SPECIAL  
 PROVISIONS AS ARE SUBMITTED WITH THE PLANS.

W. C. Bates 11-20-56  
 J. R. Hughes 11-20-56  
 R. H. Arnold 11-20-56  
 J. C. Merritt NOV. 20, 1956  
 H. B. Sargent NOV. 18, 1956

S 176(6)  
 1 87