

#198 ESTATE OF ERNEST LAKE
(A 0.051) STA 413+50-418+00 ±
SLOPE RTS - STA 413+50-418+50 ±
CHANNEL CHG - STA 414+00-419+00
BRIDGE RT-3 - STA 418+00
ADMINIS DEED - 8/27/57
RECORDED - VERSHIRE - BK 25-PG 64
7/8/57

#19A ESTATE OF ERNEST LAKE
(A 0.022) STA 411+26-411+60 ±
WDOE 8/14/56
RECORDED - VERSHIRE - BK 25-PG 15/16-8/29/56

#18B EVERETT F & BERTHA R STRAW
(A 0.022) STA 411+26-411+60 ±
WDOE 8/14/56
RECORDED - VERSHIRE - BK 25-PG 14-8/29/56

#20A NORMAN M MCLEOD
(A 0.041) STA 410+57-411+50 ±
WDOE 8/1/56
RECORDED - VERSHIRE - BK 25-PG 17-8/29/56

#20B NORMAN M MCLEOD
(A 0.011) STA 413+00-413+50 ±
WDOE 8/1/56
RECORDED - VERSHIRE - BK 25-PG 17-8/29/56

BRIDGE DATA (BR. N° 12)		
TYPE	PRESENT	PROPOSED
OVERALL LENGTH	24.75	26.75
CLEAR SPAN L TO STREAM	20'	20'
CLEAR HEIGHT	4.5'	4.5'
ROADWAY WIDTH	20'	20'
WATERWAYS	20'	20'
ELEVATION MAX. HIGH WATER	1090.00	1090.00

BM 57A
Elev. 1075.66

CONSTRUCT DRIVE S
Sta 409+25.28
410+25.38
410+35.38
410+39.19
411+20.00
411+06.00
412+00.00
412+20.00

#198 ESTATE OF ERNEST LAKE
(A 0.051) STA 417+50-422+00
ADMINIS DEED 8/14/56
RECORDED - VERSHIRE - BK 25-PG 15-8/29/56


#19B ESTATE OF ERNEST LAKE
(A 0.051) STA 417+50-422+00
ADMINIS DEED 8/14/56
RECORDED - VERSHIRE - BK 25-PG 15-8/29/56

#19C ESTATE OF ERNEST LAKE
(A 0.051) STA 417+50-422+00
ADMINIS DEED 8/14/56
RECORDED - VERSHIRE - BK 25-PG 15-8/29/56

#21A MAX L & JOSEPHINE RIEGER
(A 0.041) STA 414+30-416+75 ±
COND. 5/29/56
RECORDED - VERSHIRE - BK 24-PG 390/411
8/1/56

#21B MAX L & JOSEPHINE RIEGER
CHANNEL CHG - STA 414+00-419+00
WDOE 8/20/57
RECORDED - VERSHIRE - BK 25-PG 91
8/31/57

#21C MAX L & JOSEPHINE RIEGER
CHANNEL CHG - STA 414+00-419+00
WDOE 8/20/57
RECORDED - VERSHIRE - BK 25-PG 91
8/31/57

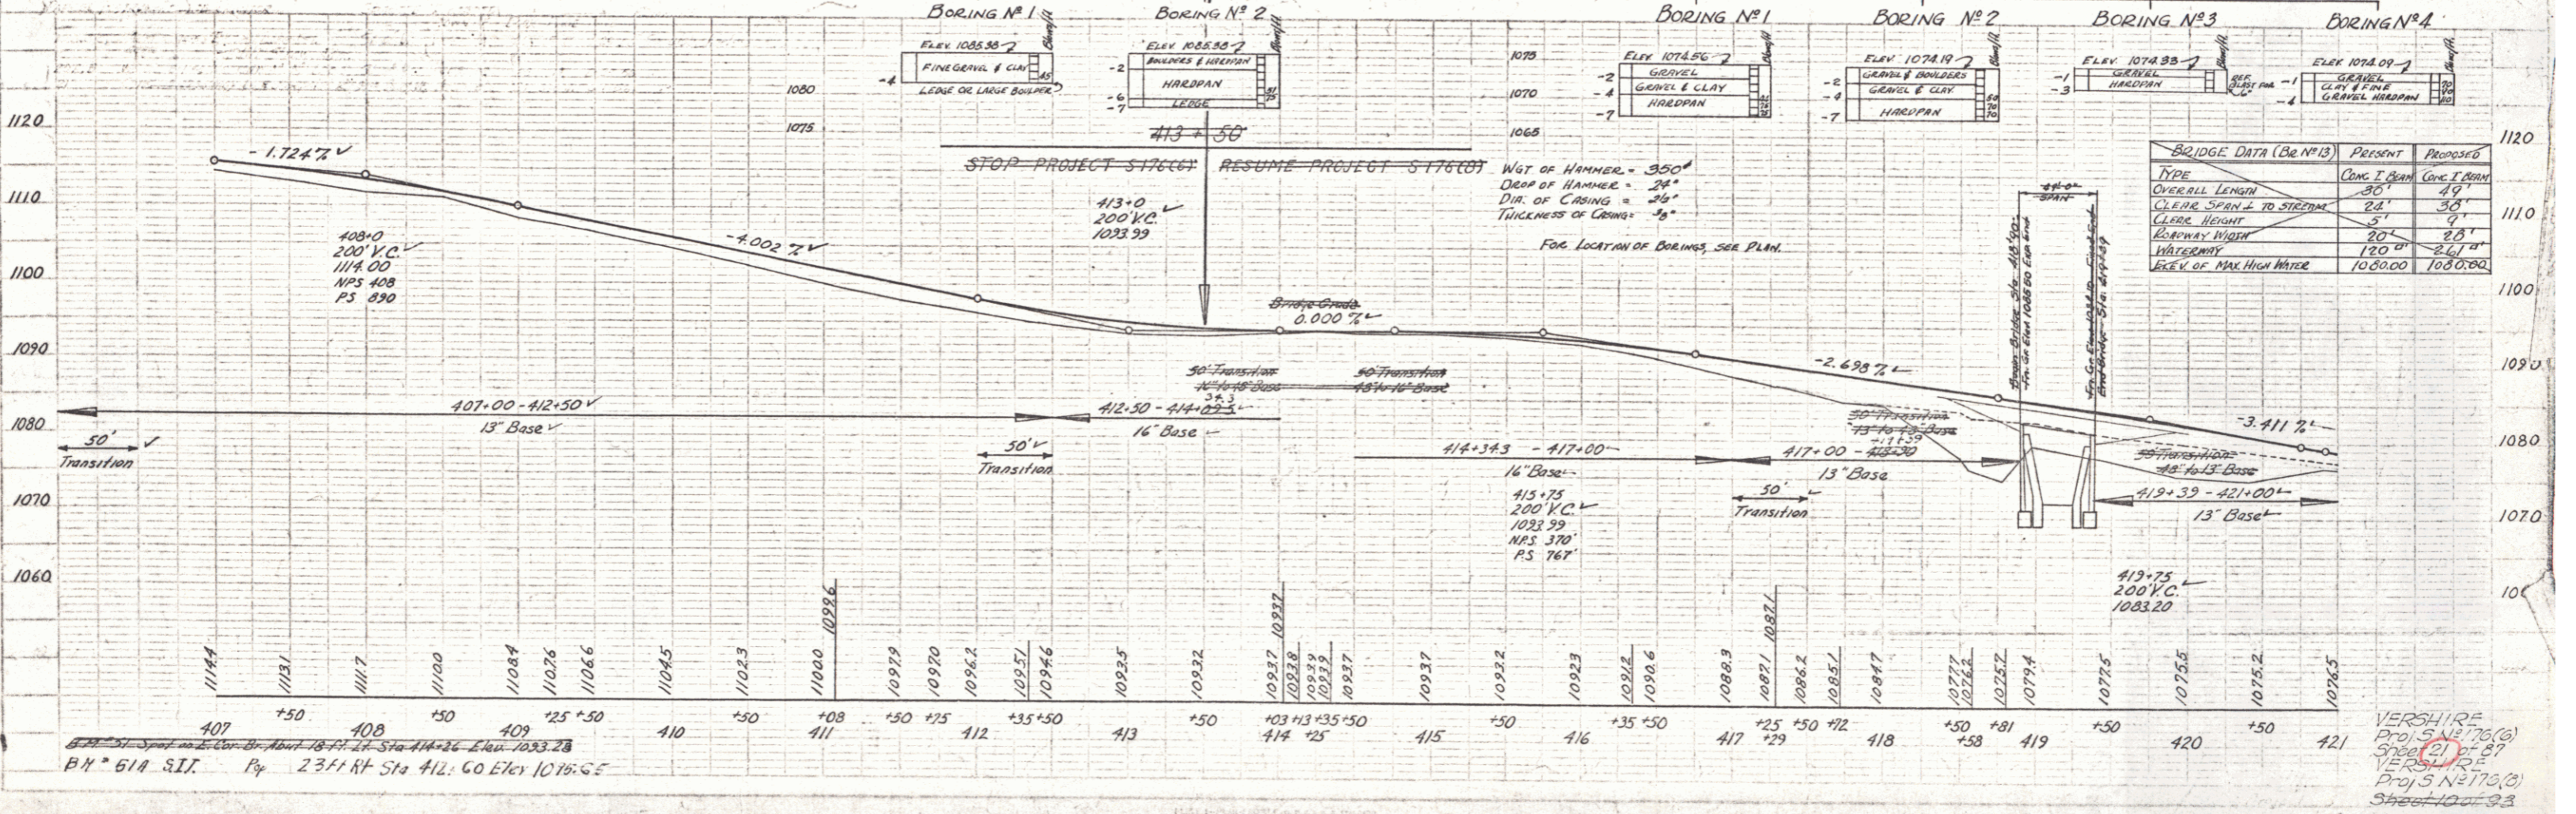

PLAN
Scale
VERSHIRE ENGINEERING CO.
INC. 100 W. MAIN ST. ST. LOUIS, MO. 63101

PROFILES
Scale
VERSHIRE ENGINEERING CO.
INC. 100 W. MAIN ST. ST. LOUIS, MO. 63101

VERSHIRE
PROJ. N° 76 (A)
SHEET (2) OF 27
DATE 10/15/55
PROJ. N° 76 (B)
SHEET 10 OF 23