
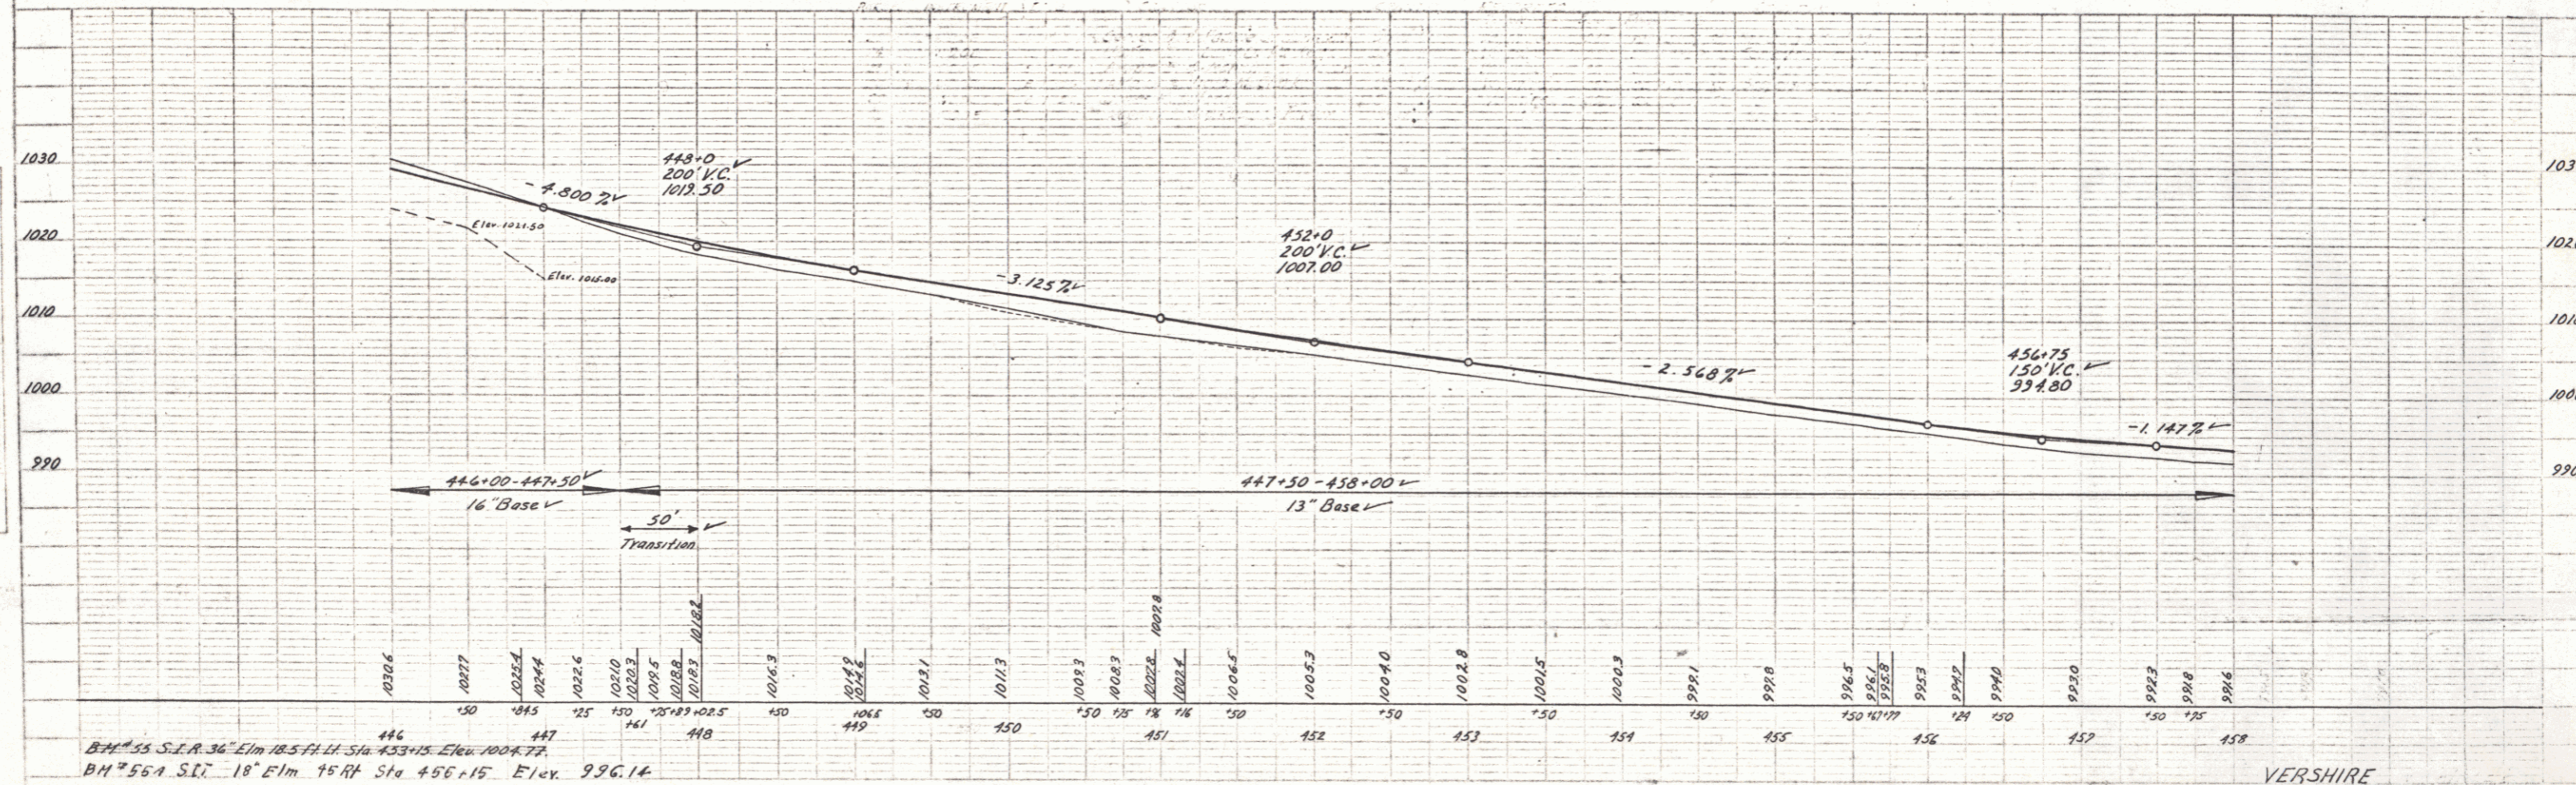


PLAN
 DRAWN BY
 CHECKED BY
 DATE
 SCALE

PROFILE
 DRAWN BY
 CHECKED BY
 DATE
 SCALE

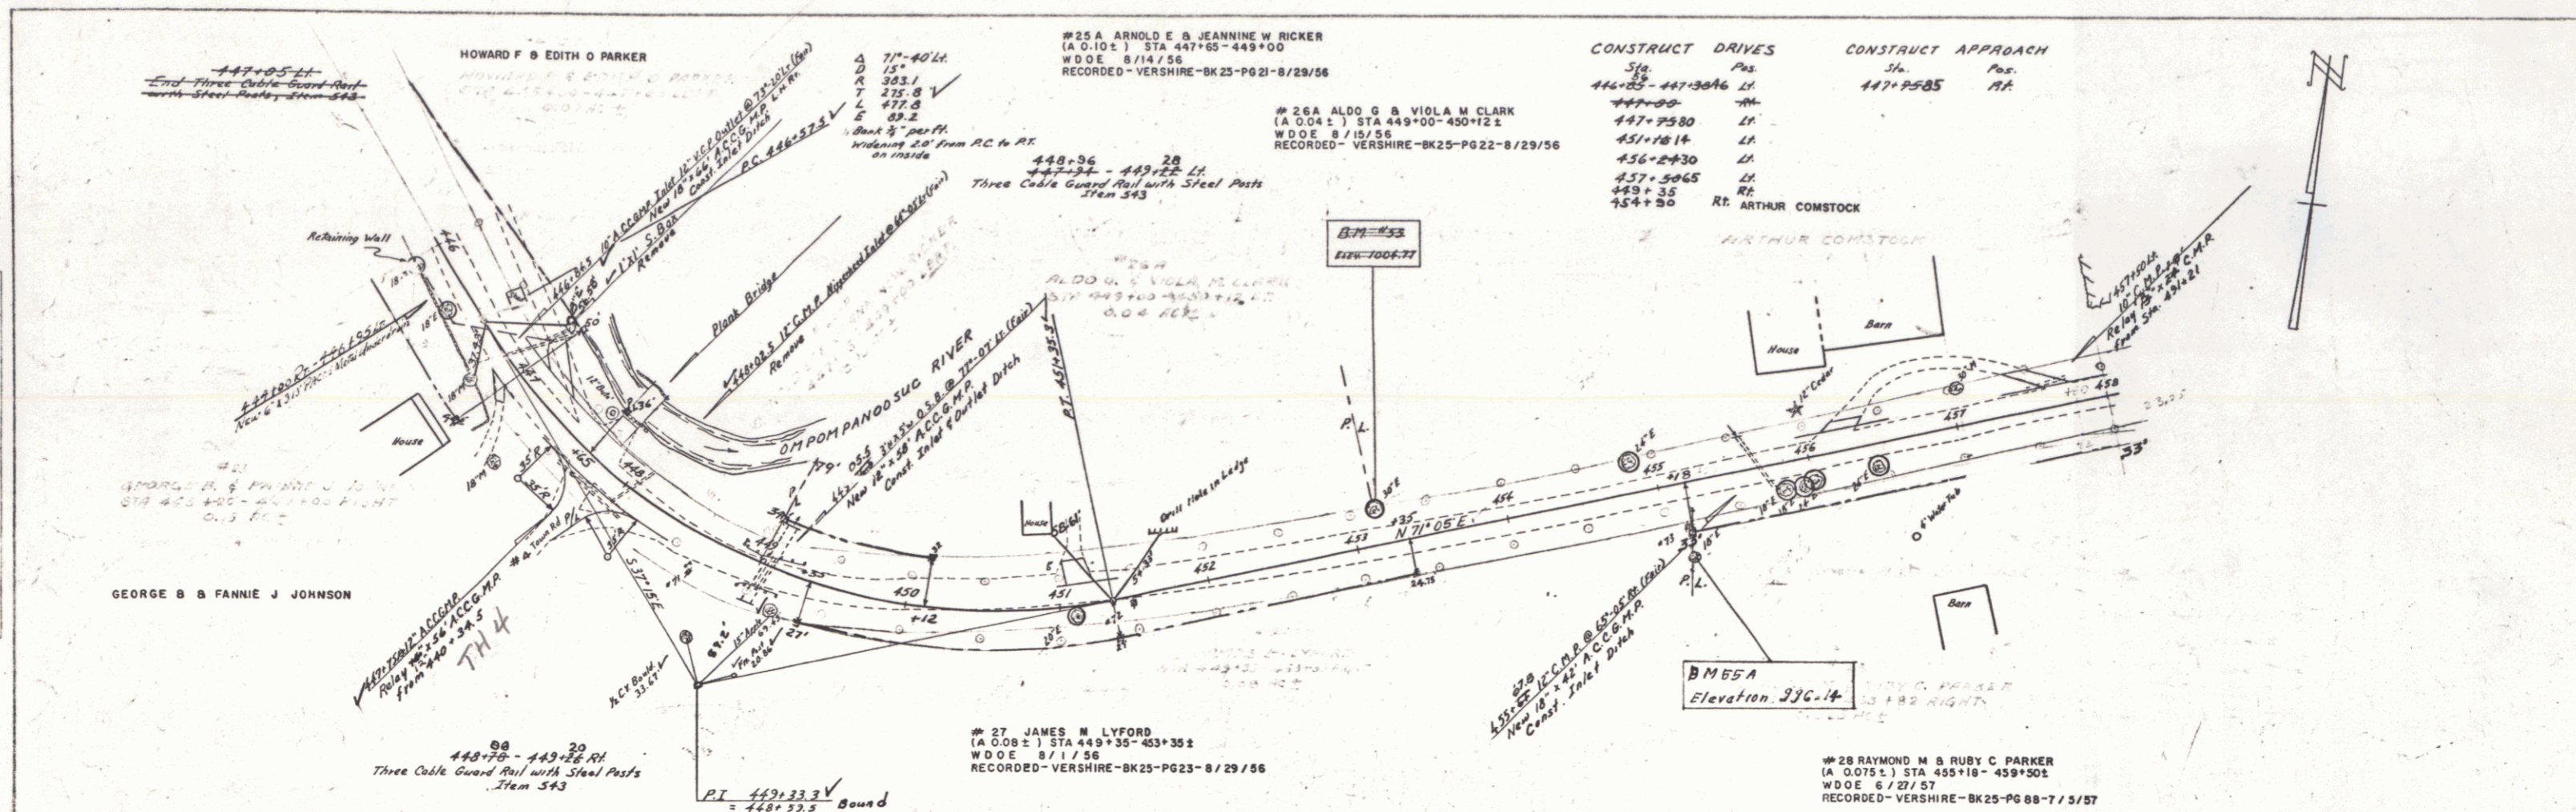

B.M. 55 S.I.R. 36' E 1m 18.5 ft. Sta. 433+25 Elev. 1004.77
 B.M. 56 A S.I.R. 18' E 1m 75 ft. Sta. 456+15 Elev. 996.14

VERSHIRE
 Project 5 No. 176(6)
 Sheet 24 of 87 Sheets