


Parcel	Trce	Date	Grantor	Grantee	Recorded Book	Page	Date	Remarks
#2	W.D.C.E.	7-12-52	KG & D. Thompson	St. of Vt.	Chelsea	32	190	7-19-52 See Sheet 10
#3	W.D.C.E.	7-21-52	Phoebe Folger Jordan	St. of Vt.	Chelsea	32	74	8-1-52 See Sheet 10


CONSTRUCT DRIVES  
 Station 133  
 139+50 RT  
 141+25 LT

CONSTRUCT TWO CABLE  
 GUARD RAIL, ITEM 642  
 148+00-148+50  
 149+00-149+50  
 154+21-155+00-RE

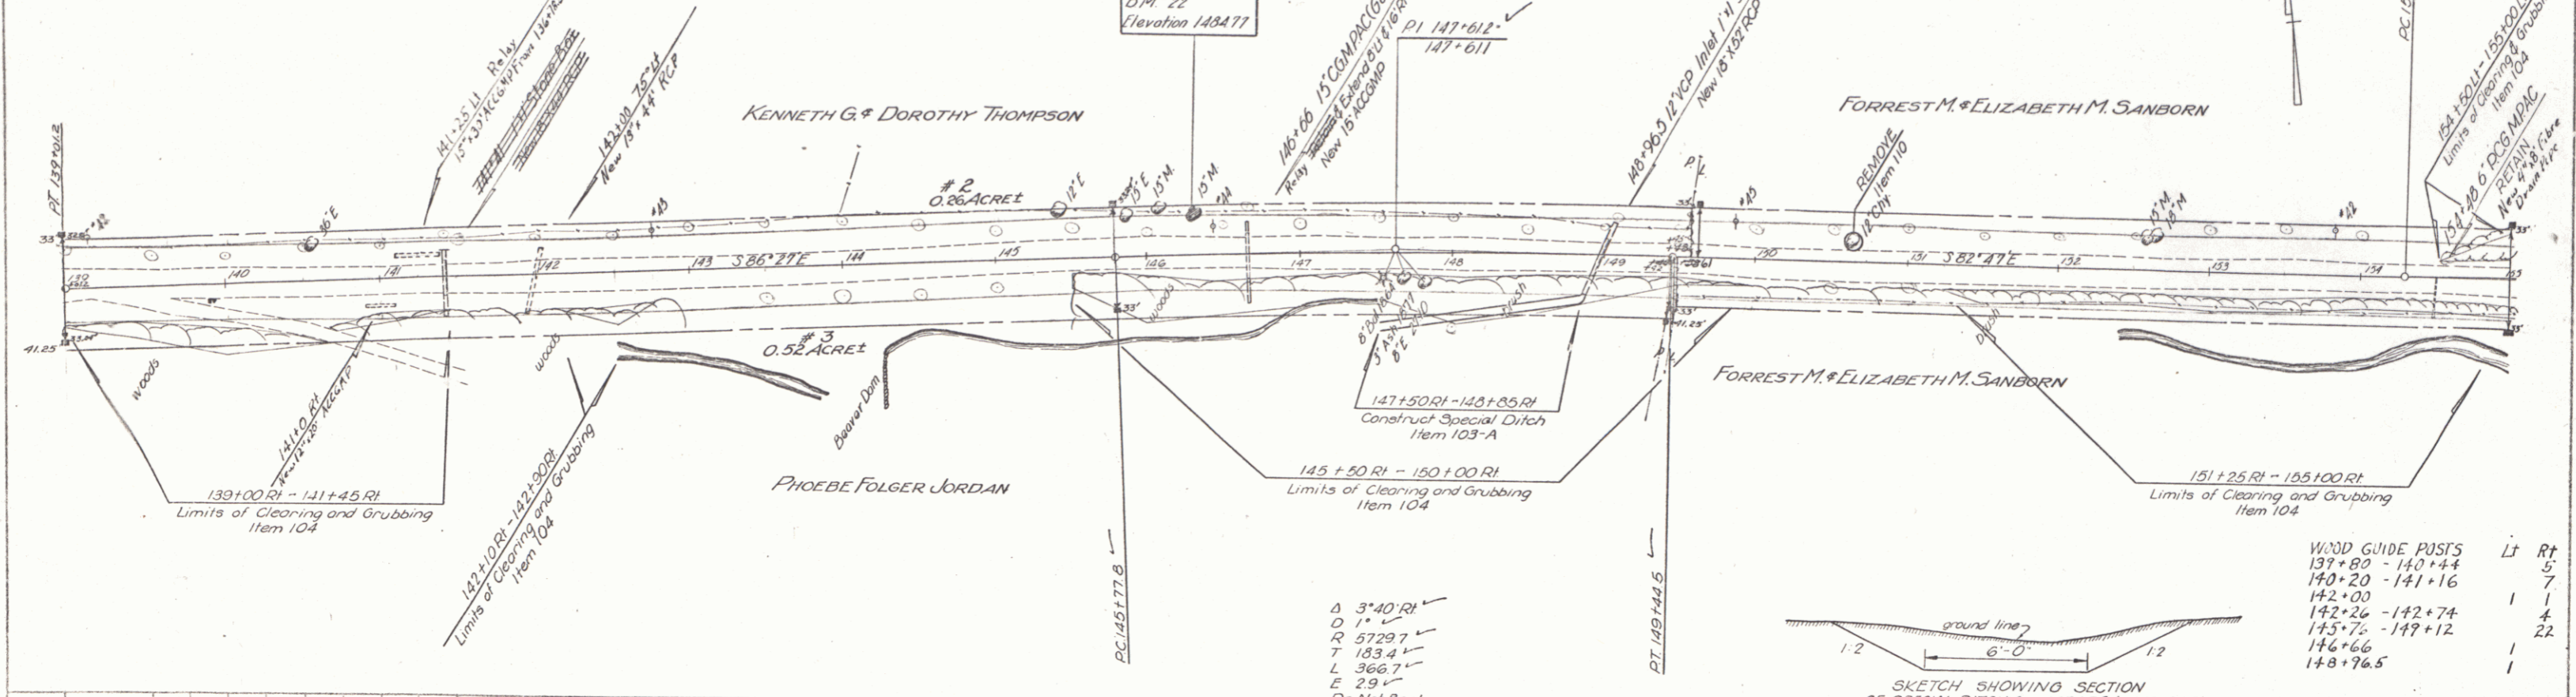


PLAN  
 SCALE: 1" = 40'  
 DATE: 7-21-52  
 DRAWN BY: [Name]  
 CHECKED BY: [Name]

Δ 3'-40" RI  
 D 1'  
 R 57297  
 T 1834  
 L 3667  
 E 29  
 Do Not Bank

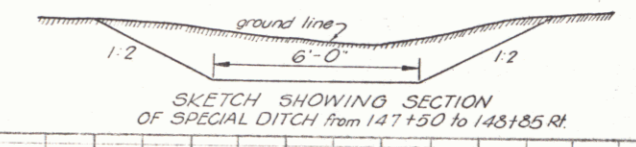

WIND GUIDE PISTS

LI	RT
139+80 - 140+44	5
140+20 - 141+16	7
142+00	1
142+26 - 142+74	4
145+75 - 149+12	22
146+66	1
148+96.5	1

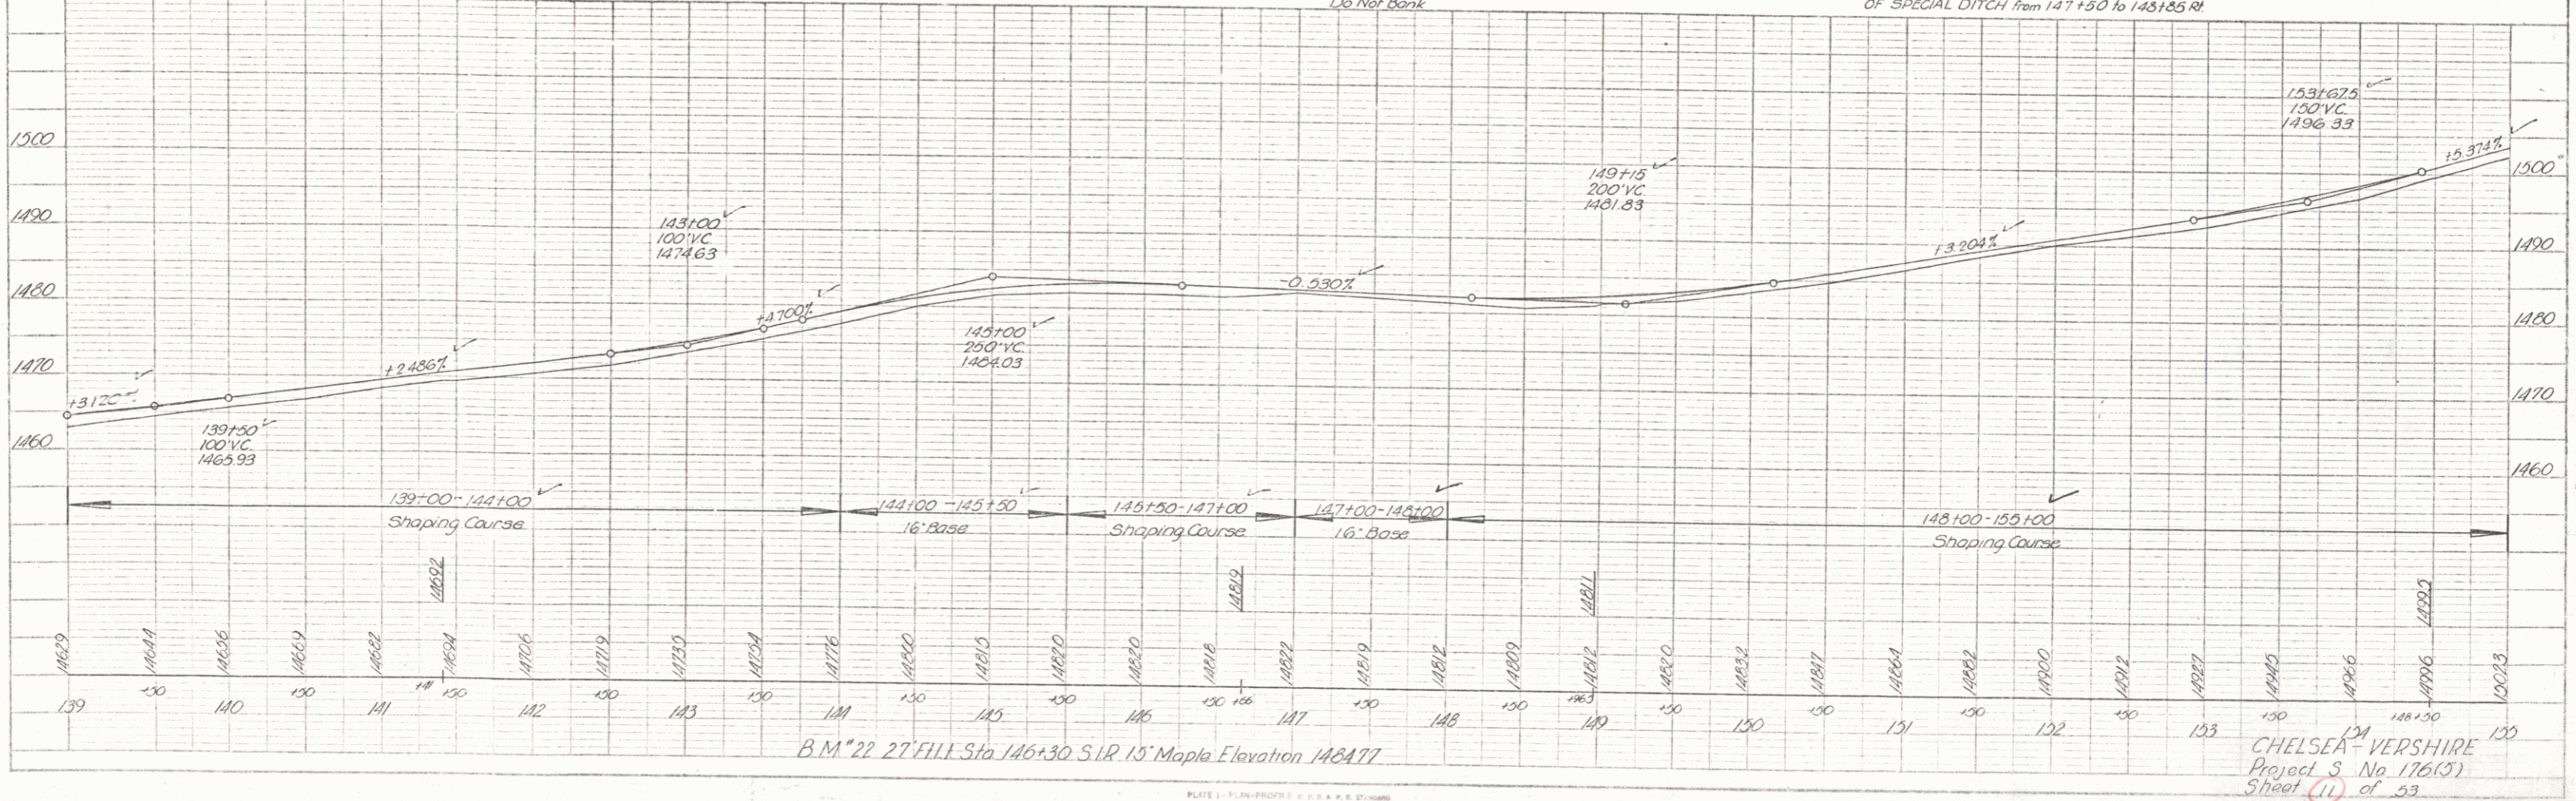

PROFILE  
 SCALE: 1" = 40'  
 DATE: 7-21-52  
 DRAWN BY: [Name]  
 CHECKED BY: [Name]

PLATE 1 - PLAN PROFILE - C. C. & R. S. STONE  
 201 WEST 4 STREET, NEW YORK, N.Y.  
 P.L.C. No. 348-17

CHELSEA-VERSHIRE  
 Project 3 No 176(5)  
 Sheet 11 of 55