


Parcel	Inste Date	Grantor	Grantee	Recorded	Book Page	Date	Remarks
#8A, E.C.	W.D.O.E. 6-19-52	Raymond & Anna Chartier	St. of Vt.	Vershire	24	197	6-26-52 See Sheets 14 & 16
#9	W.D.O.E. 6-19-52	John & Suzanna Pagac	St. of Vt.	Vershire	24	201	6-26-52 See Sheet 16

CONSTRUCT DRIVES
 Station Pos
 212+00 RT
 204+75 RT
 209+45 RT
 216+00 LT


NON-GOV'T. PART
 Install Sleeve for Water Pipe Item 103
 Sleeve to be furnished by Property Owner
 219+00

Δ 25°51' L
 D 51'
 R 1146.3
 T 2421
 L 4770
 E 253
 Bank 1/2 per foot

PLAN
 SHOWING
 SHAPING COURSE
 DATE 10/15/52
 BY J. H. [unclear]

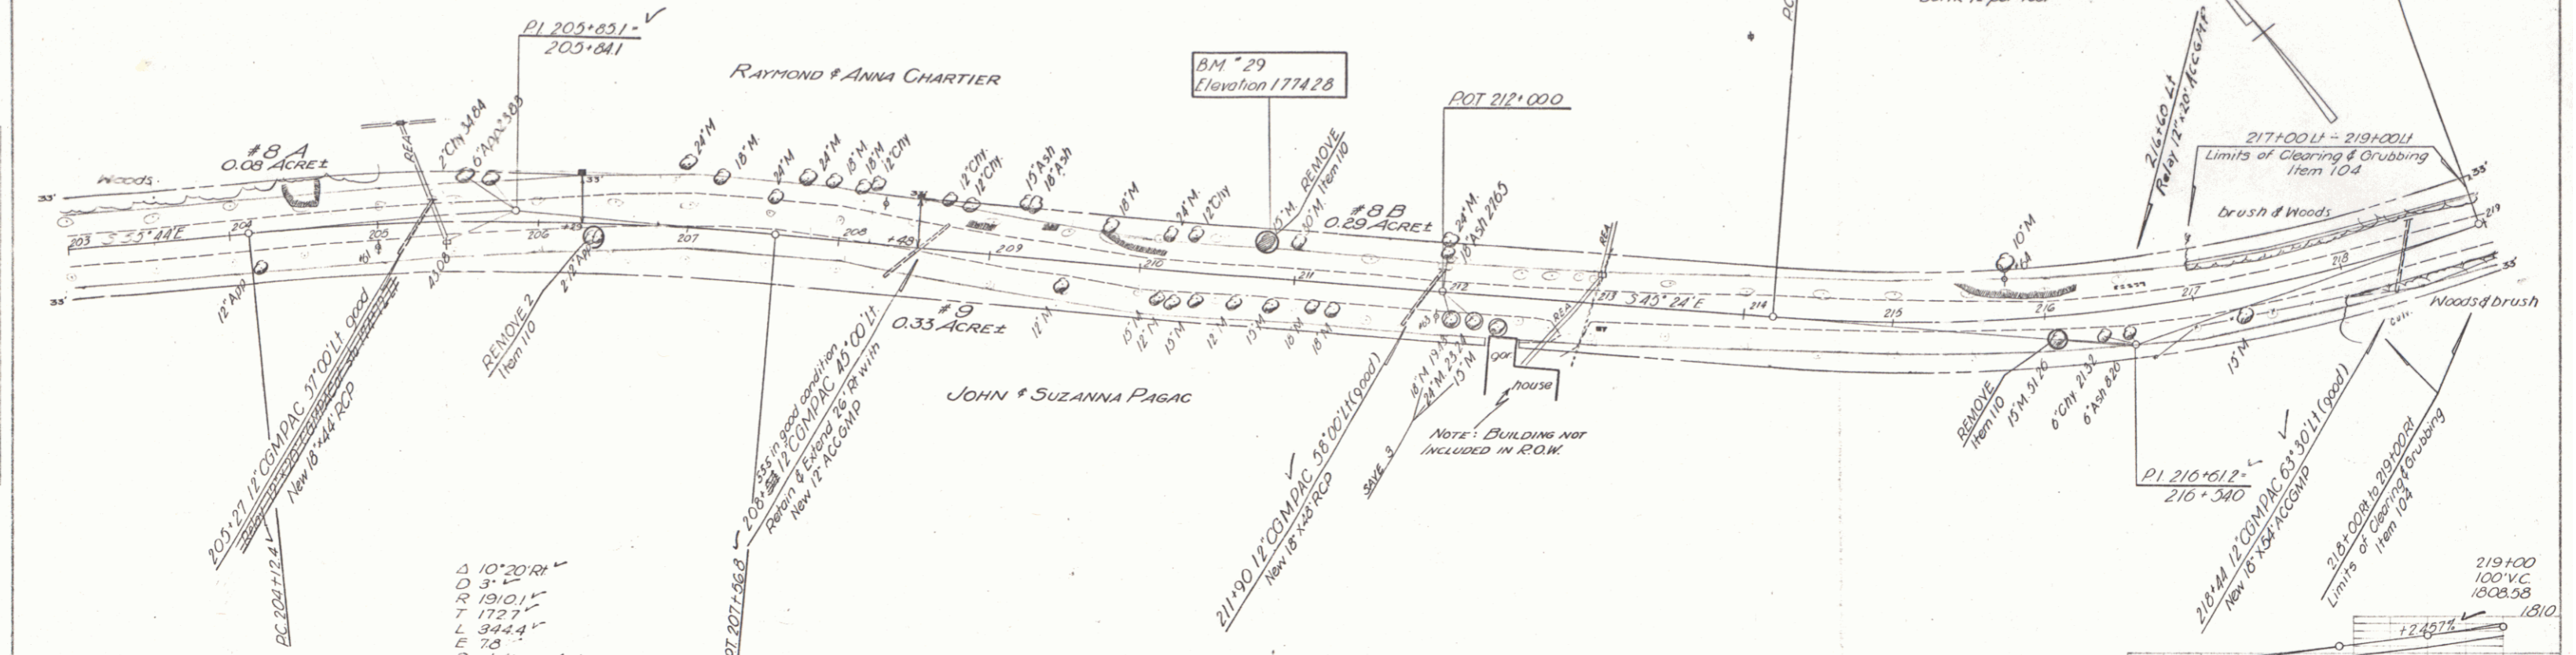

PROFILE
 SHOWING
 SHAPING COURSE
 DATE 10/15/52
 BY J. H. [unclear]

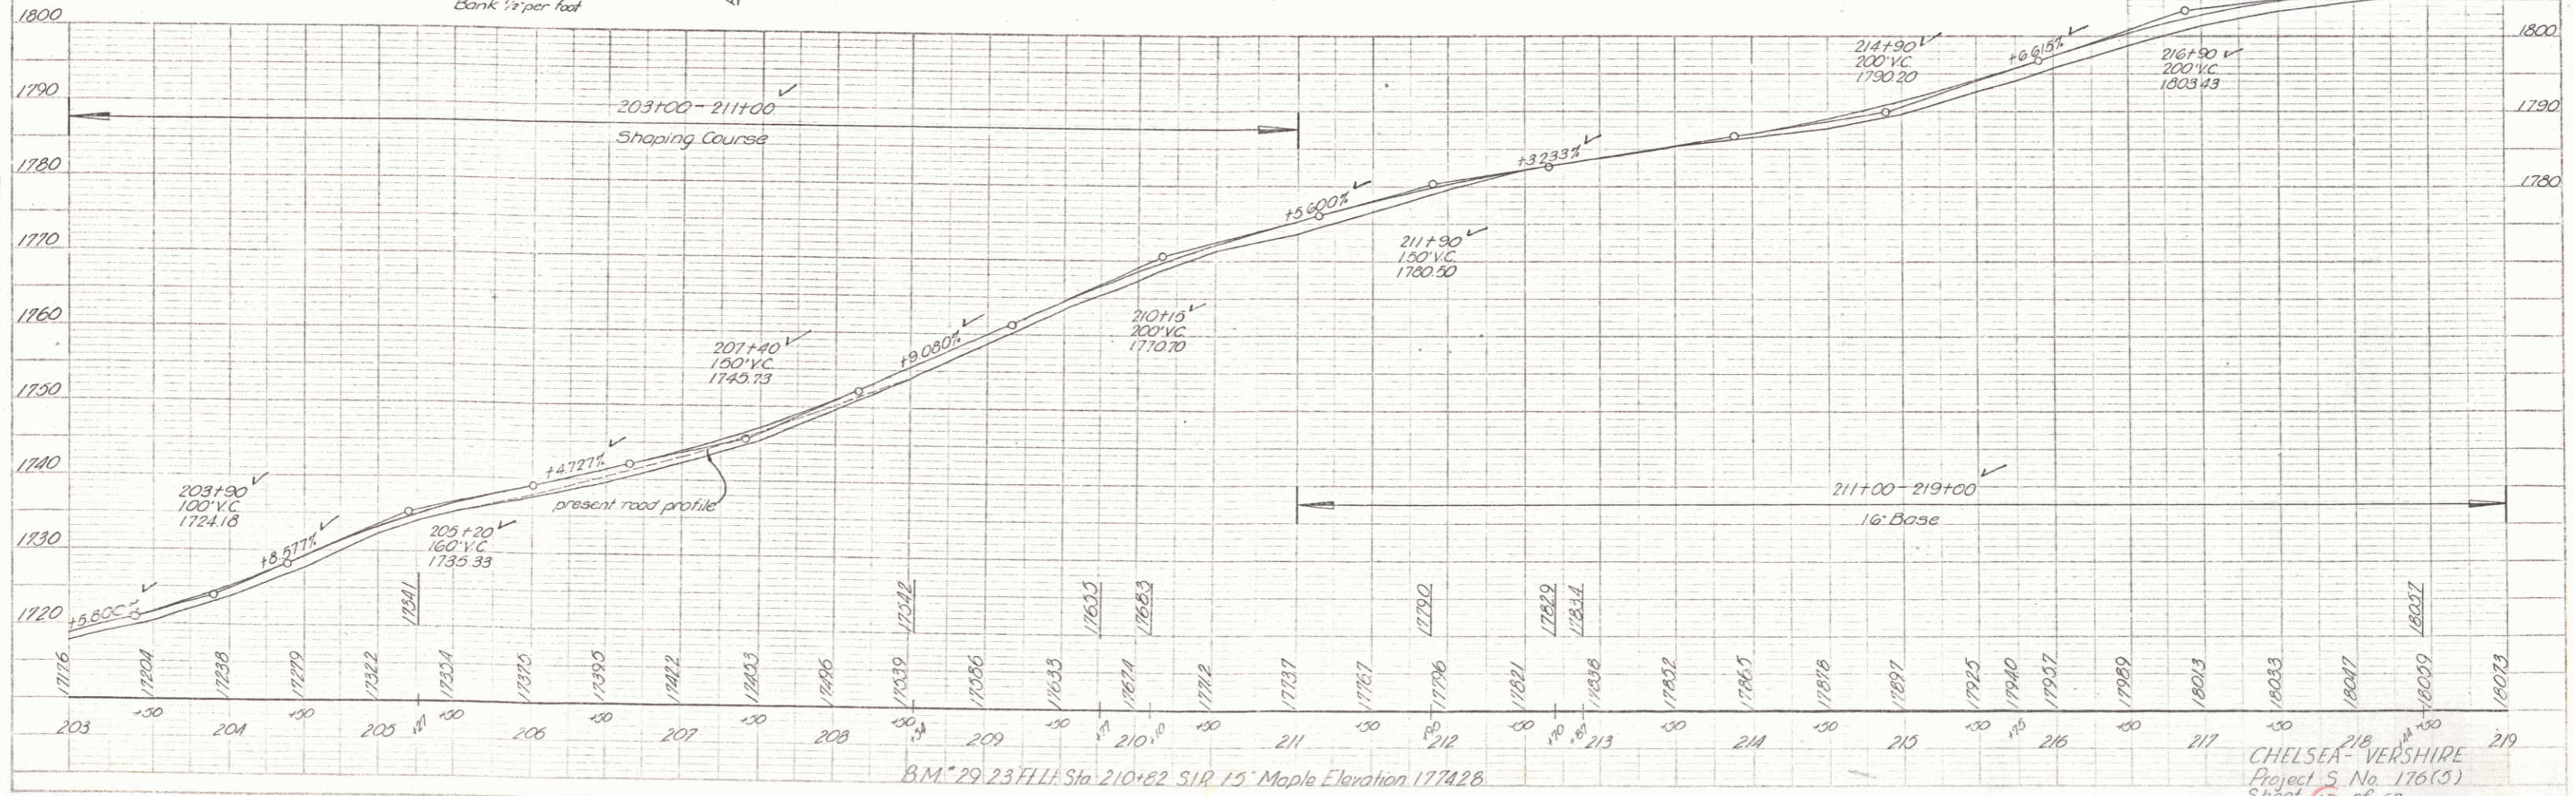

CHELSEA - VERSHIRE
 Project 5 No. 176(3)
 Sheet 15 of 33