


PLAN
 SHEET NO. 12-32
 DATE 1-28-24
 DRAWN BY [Name]
 CHECKED BY [Name]



PROFILE
 SHEET NO. 12-32
 DATE 1-28-24
 DRAWN BY [Name]
 CHECKED BY [Name]

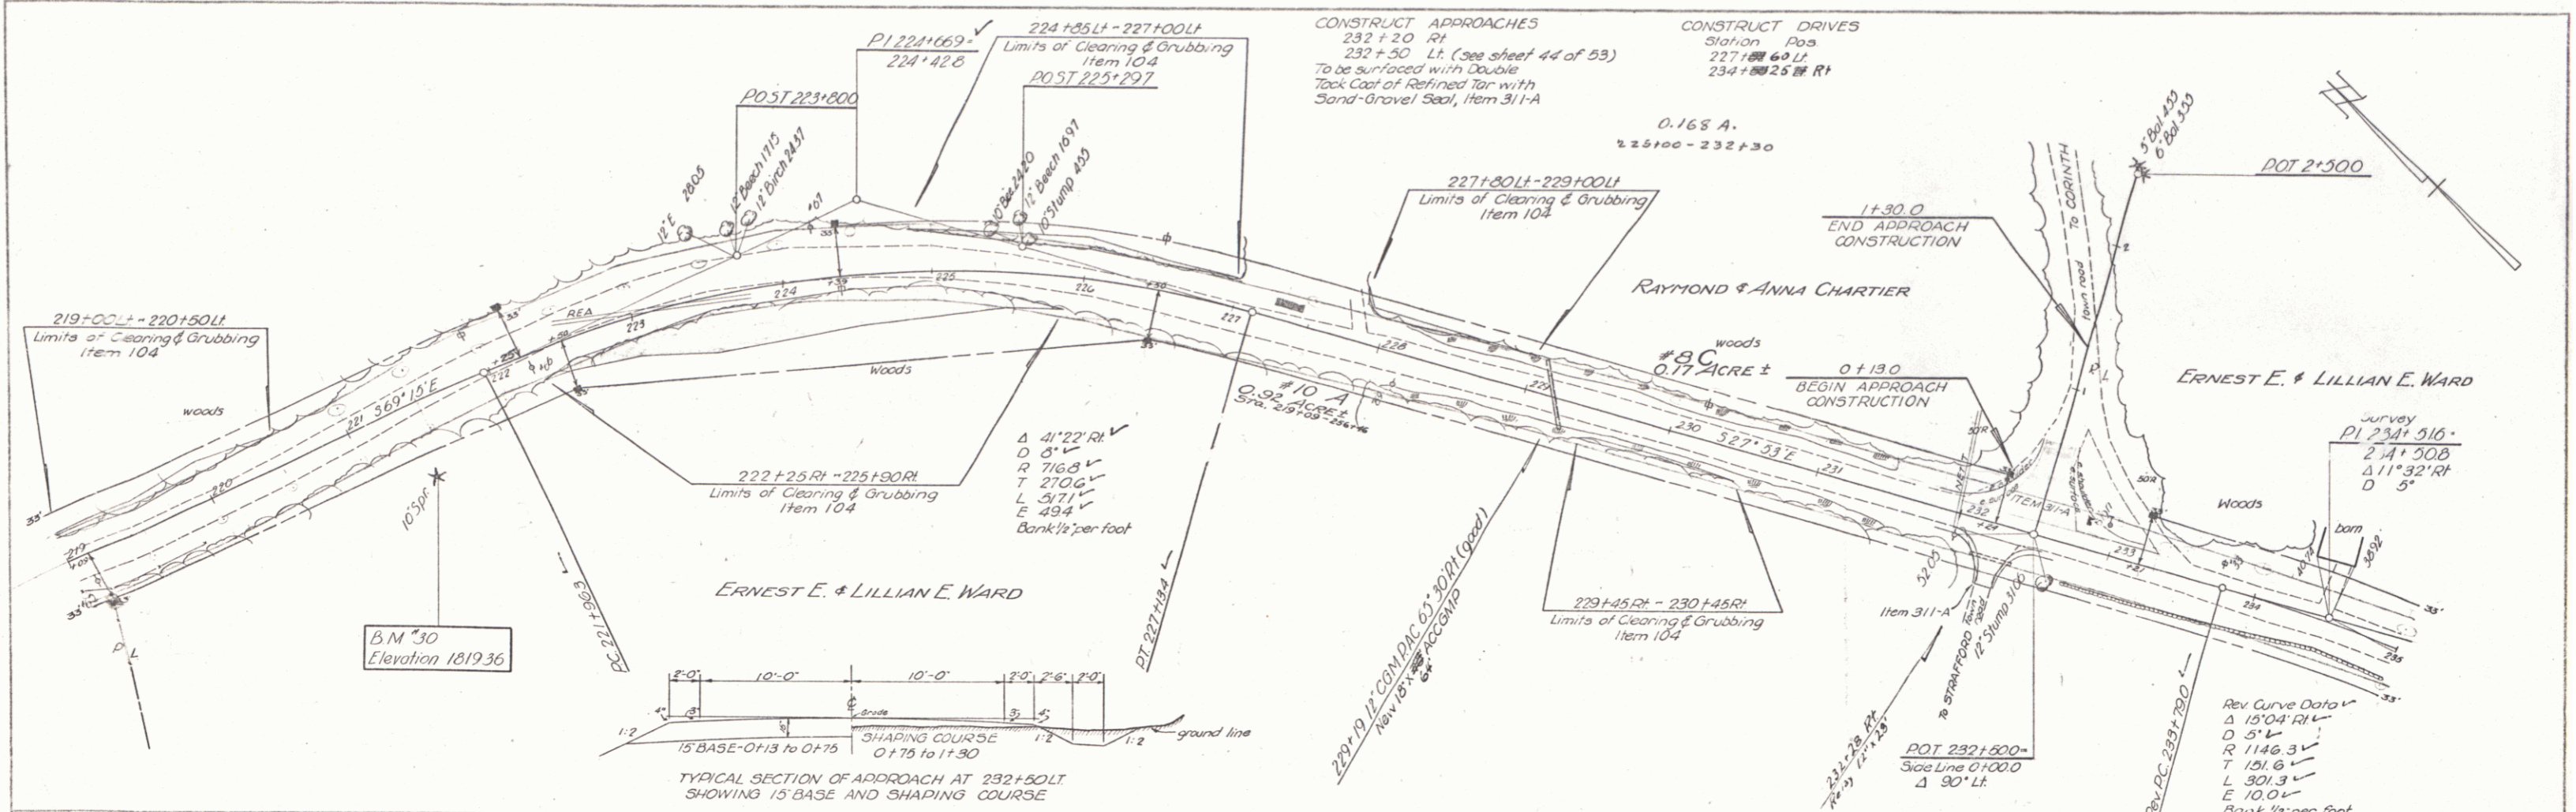