
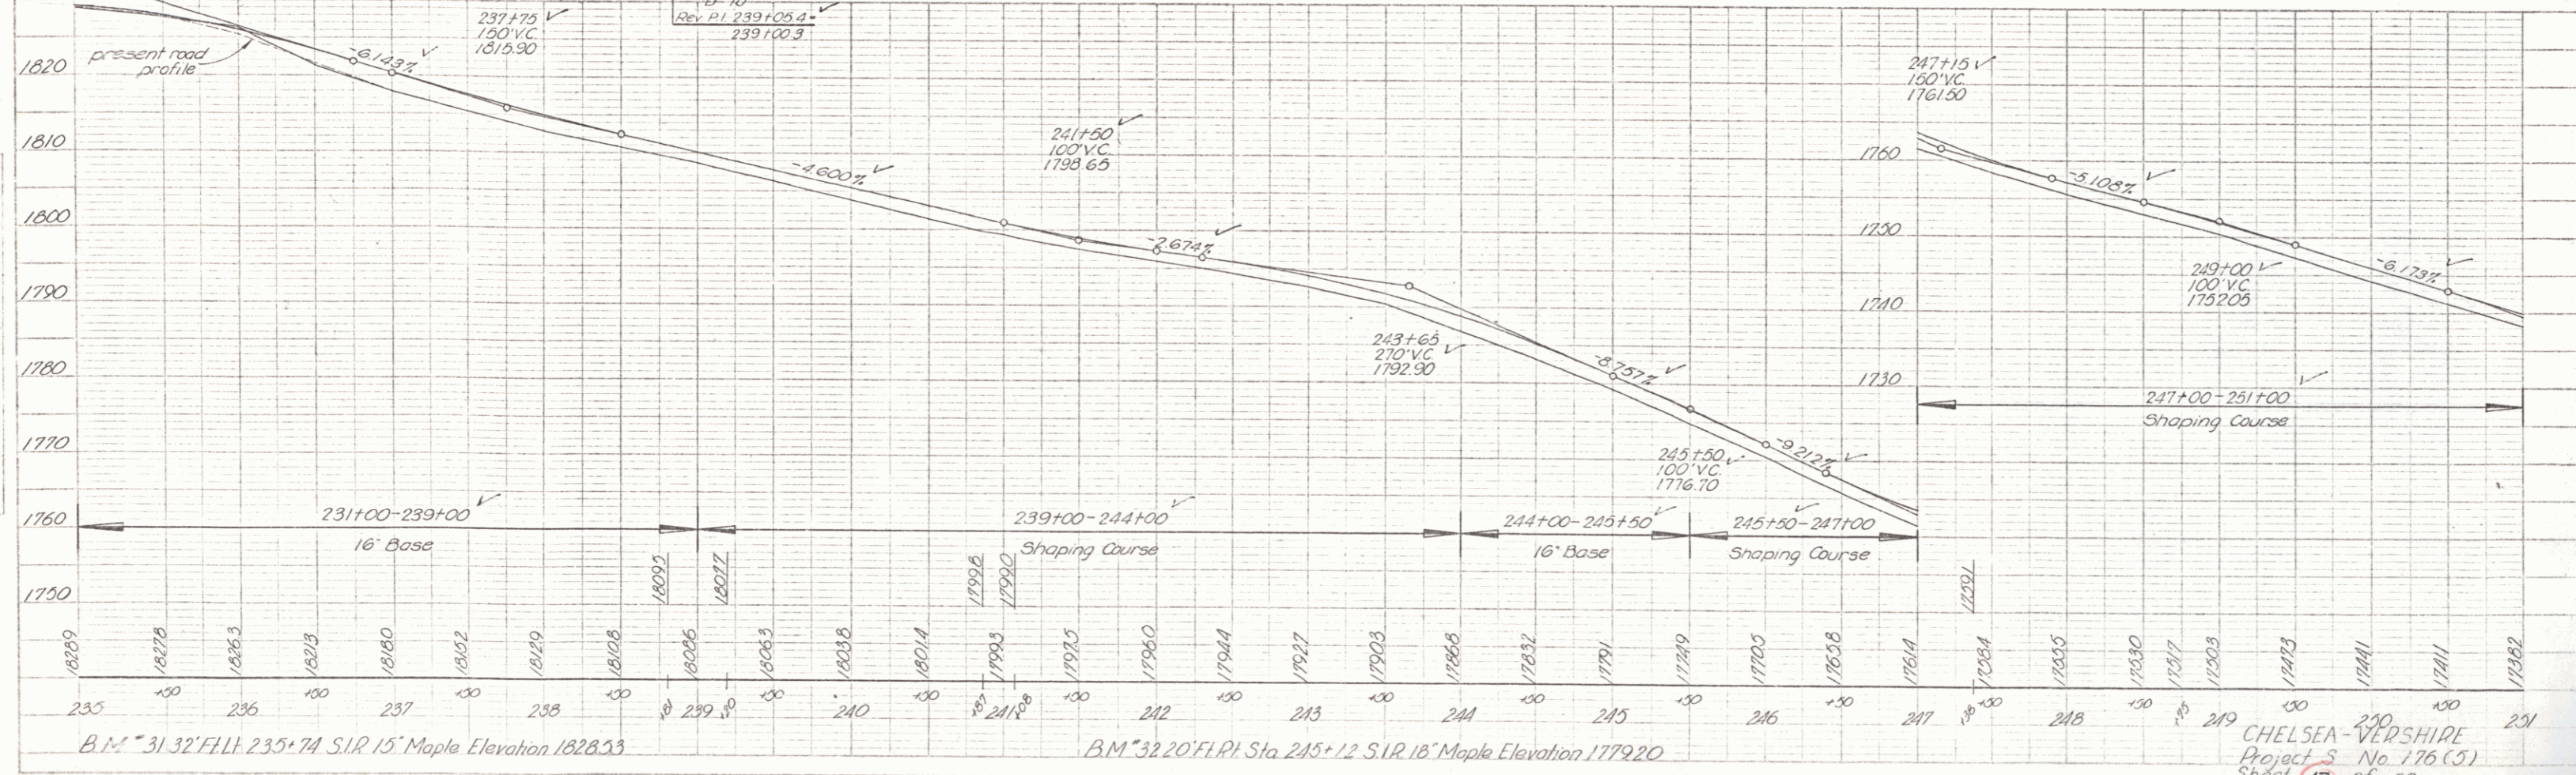


FILE NO. 17-30
 SHEET NO. 17 OF 53
 DATE 6-26-52
 DRAWN BY J. W. WARD
 CHECKED BY E. E. WARD

FILE NO. 17-30
 SHEET NO. 17 OF 53
 DATE 6-26-52
 DRAWN BY J. W. WARD
 CHECKED BY E. E. WARD

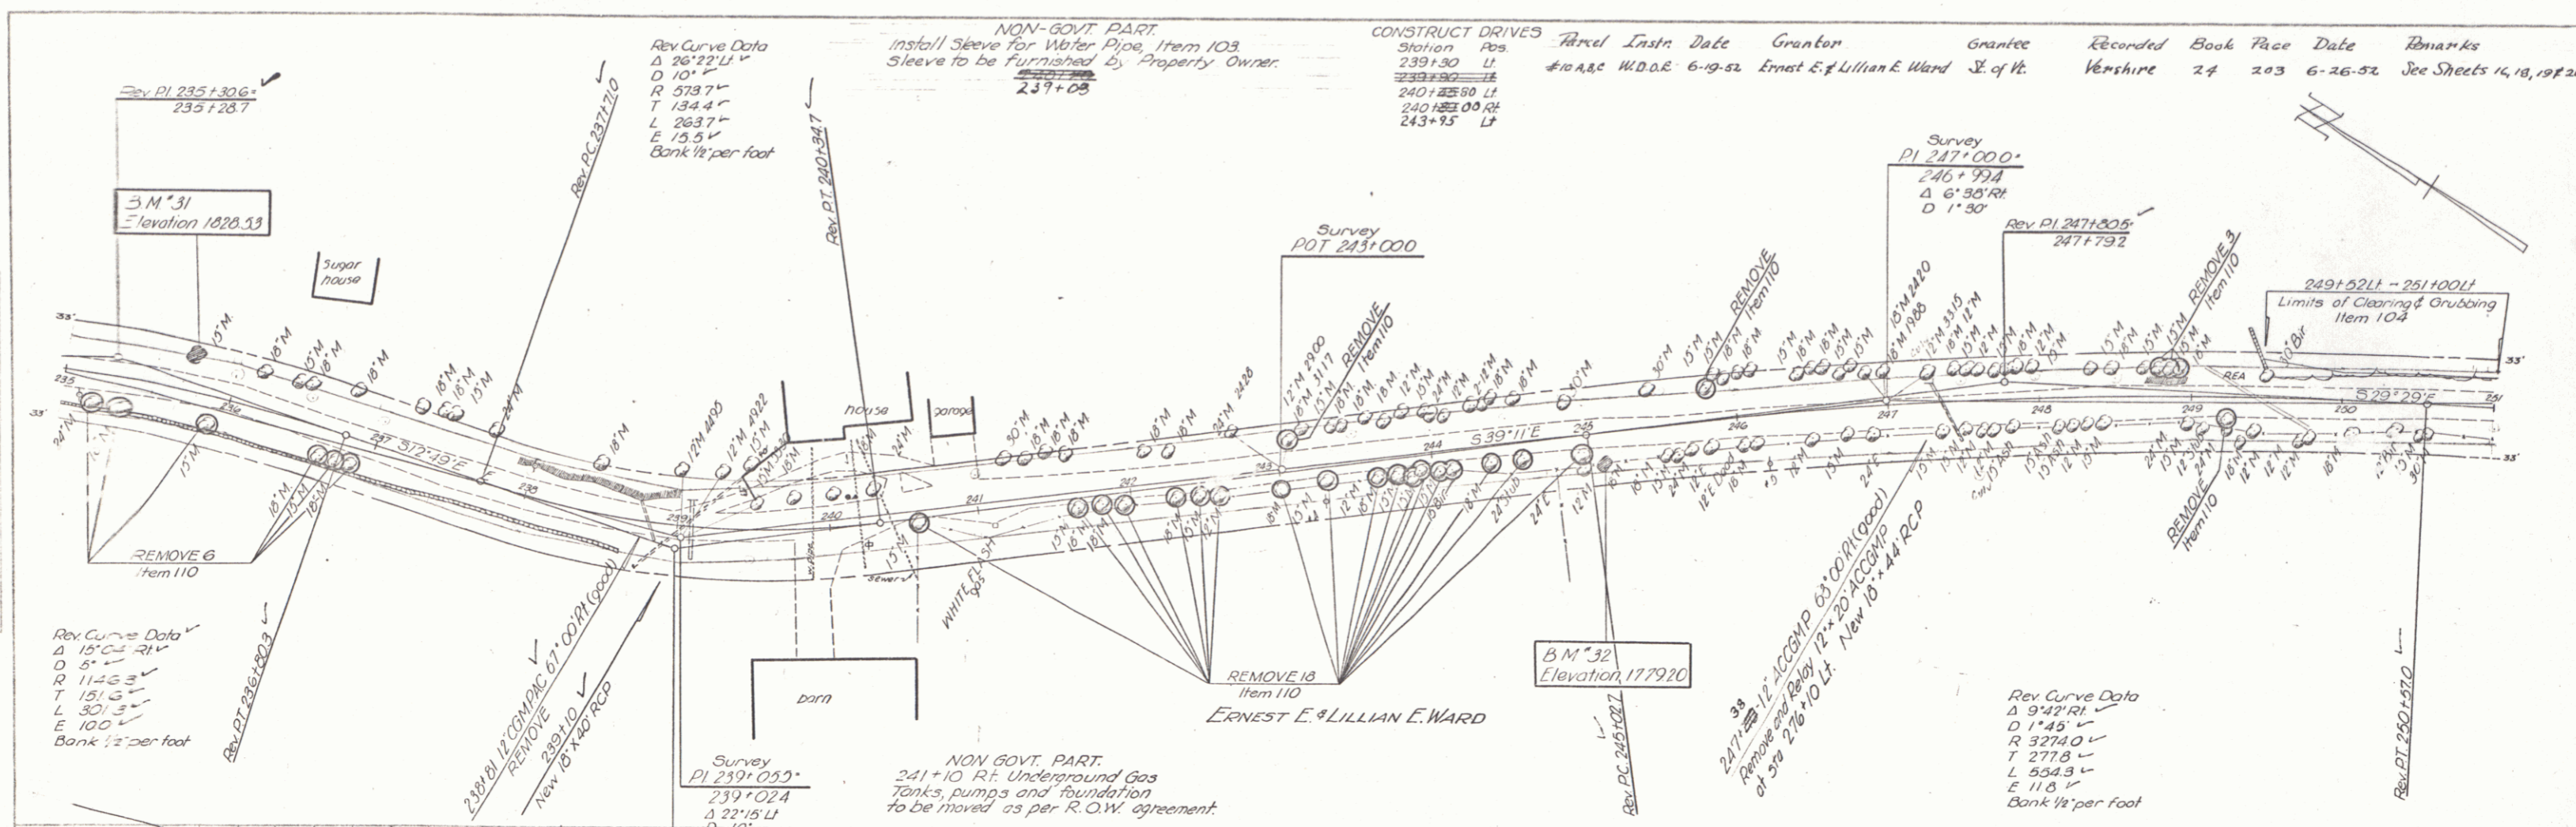

CHELSEA - VERSHIRE
 Project No. 176 (5)
 Sheet 17 of 53