



PLAN
 SCALE: 1" = 40'
 DATE: 1/28/52
 DRAWN BY: [Signature]
 CHECKED BY: [Signature]

PROFILE
 SCALE: 1" = 10'
 DATE: 1/28/52
 DRAWN BY: [Signature]
 CHECKED BY: [Signature]

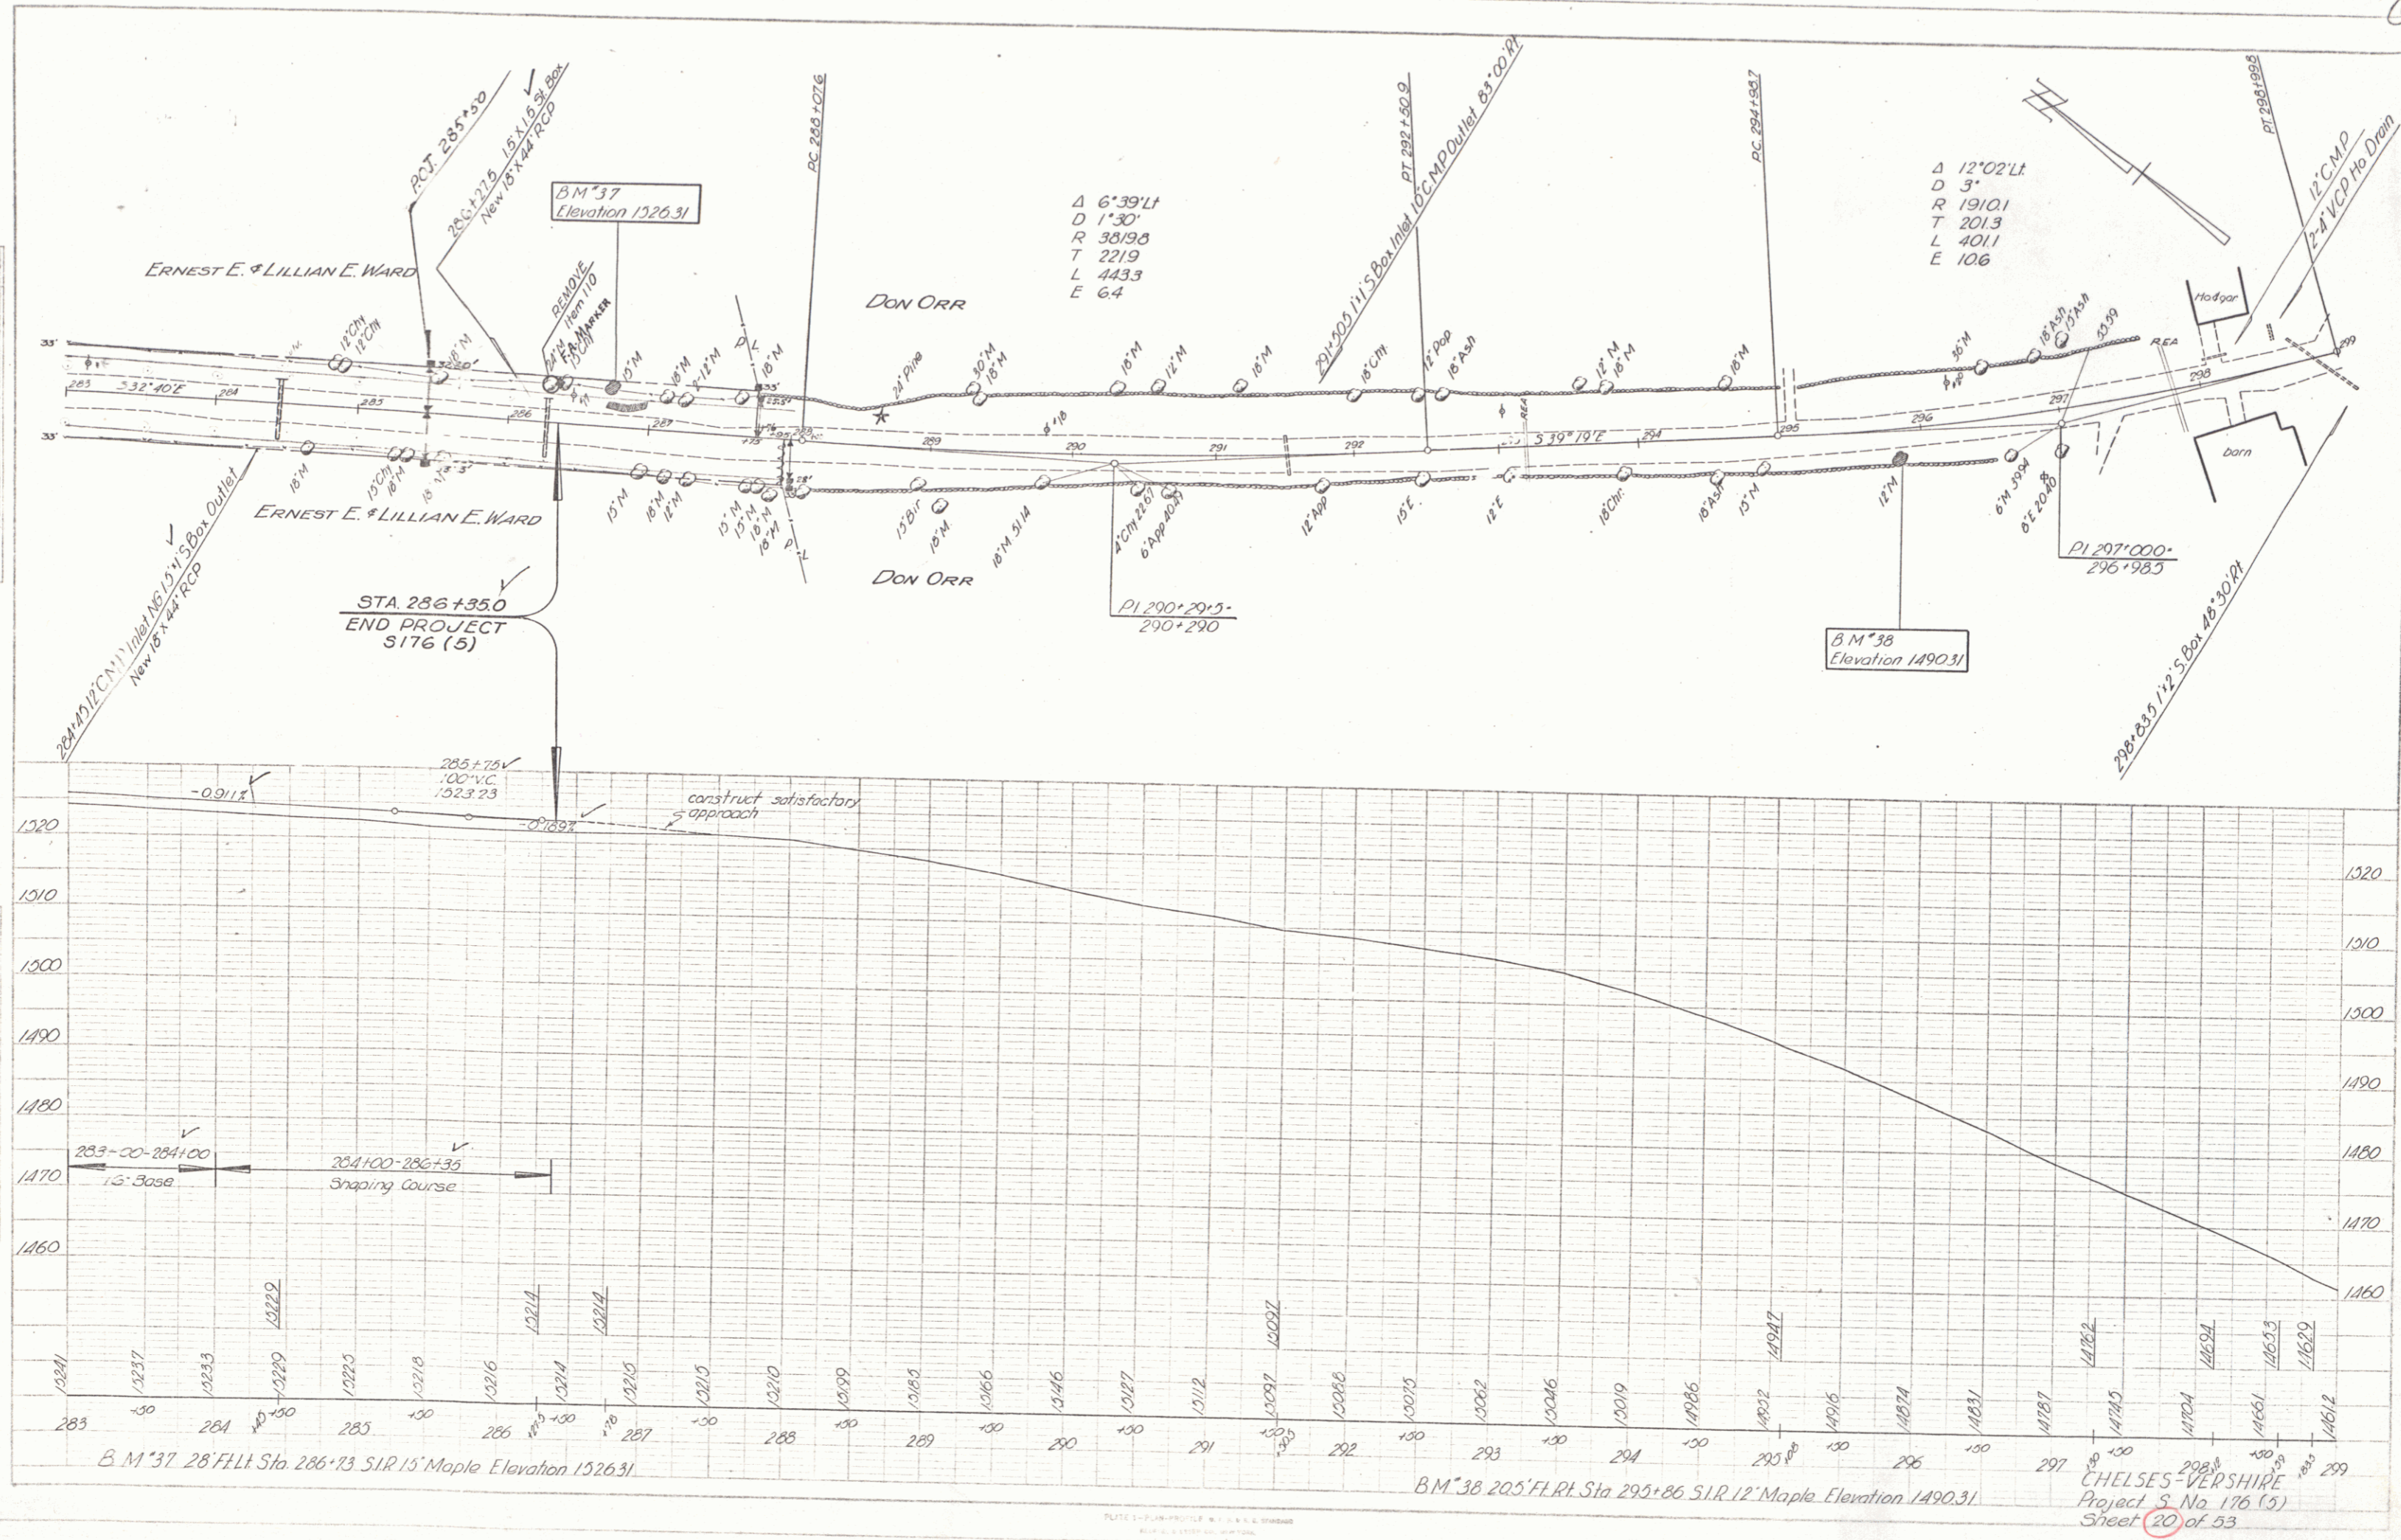

Δ 6'39" LI
 D 1'30"
 R 38198
 T 2219
 L 4433
 E 64

Δ 12'02" LI
 D 3'
 R 1910.1
 T 201.3
 L 401.1
 E 106

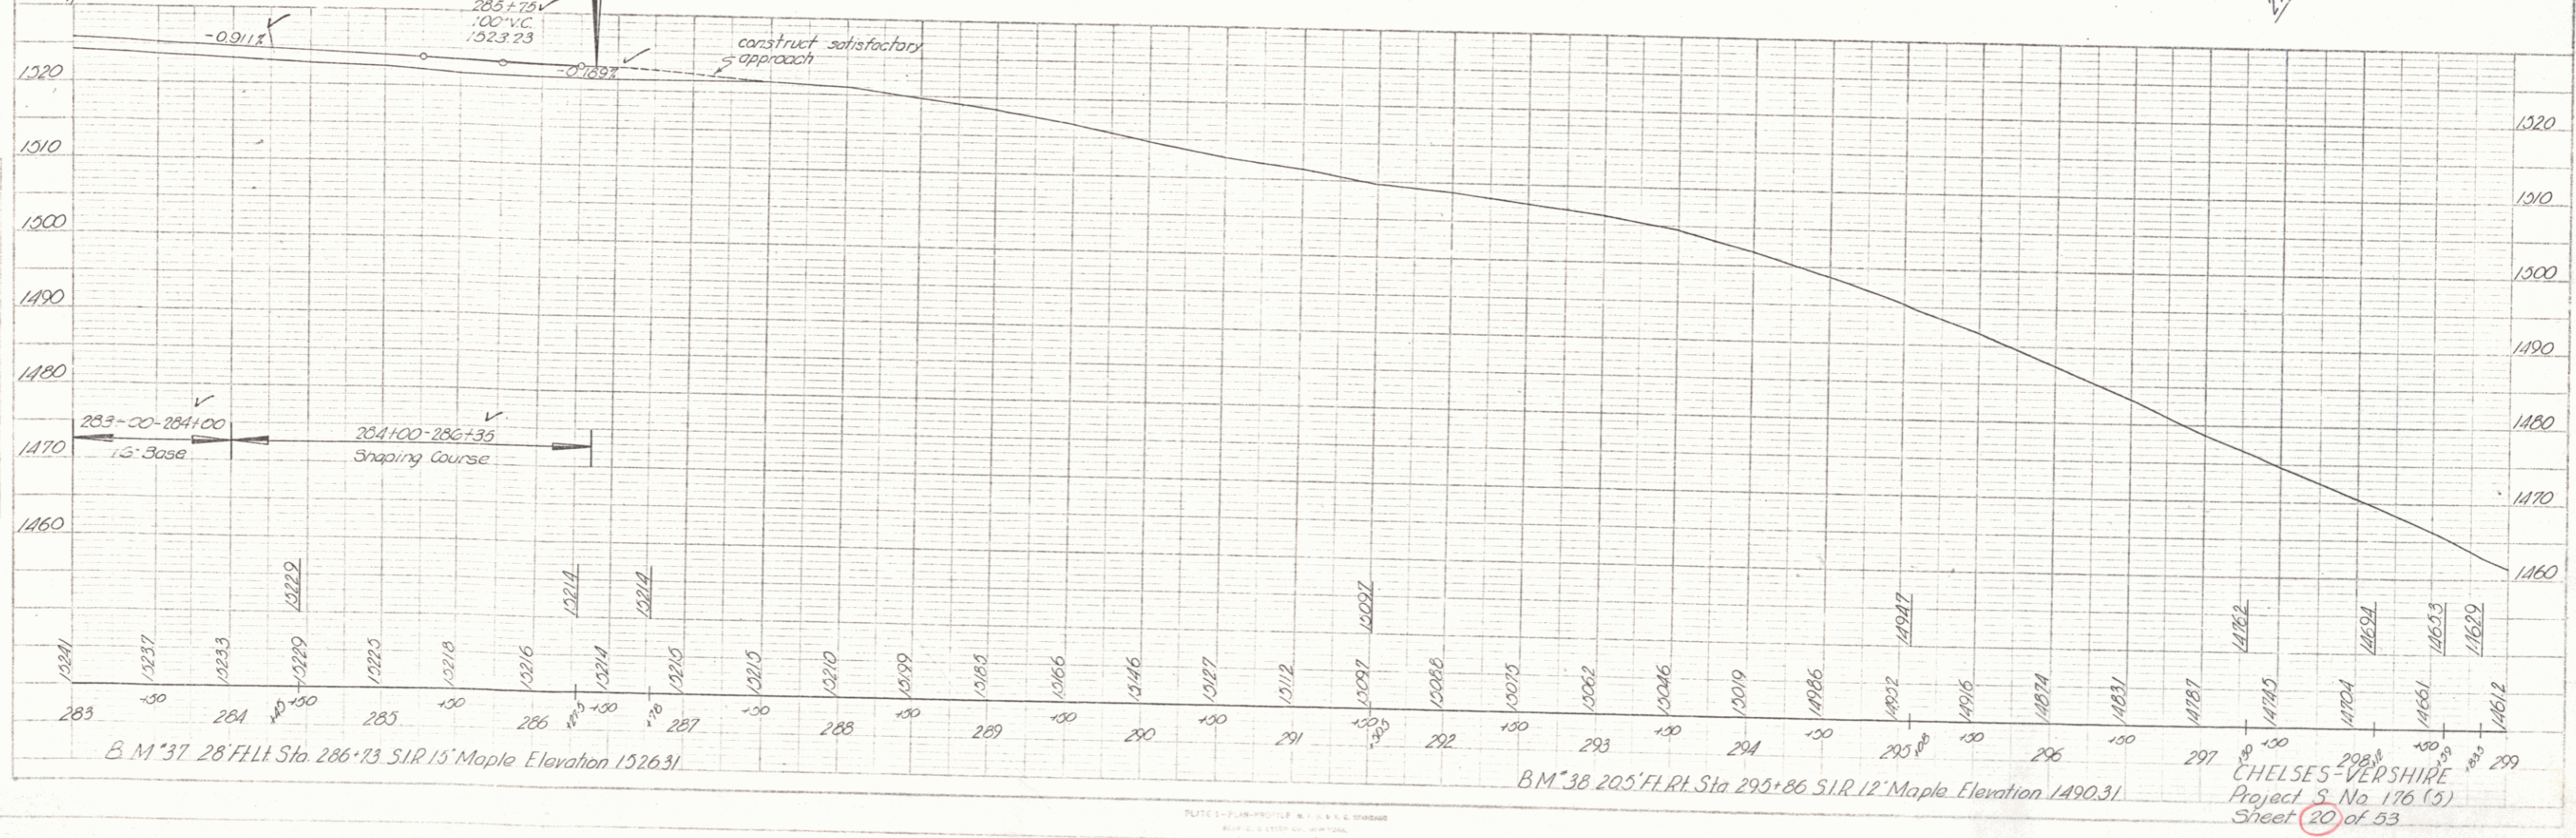

B.M. 37 28' F.L.T. Sta. 286+13 S.I.R. 15' Maple Elevation 1526.31

B.M. 38 205' F.L.T. Sta. 293+86 S.I.R. 12' Maple Elevation 1490.31

CHELSEA-VERSHIRE
 Project S No. 176 (5)
 Sheet 20 of 53